

leased rooms
which may be used
for massage


Room 2
Room 3
Room 4
Room 5

Room 1 is my room
which will be used
for massage.

Hours are generally
8am - 5pm
but each person leasing can
set their own hours M-Saturday
Sunday usually closed.

4121 E. VALLEY AUTO DR.
SUITE 109
2,244.15 S.F.

License Application
LICAZ 21-03481

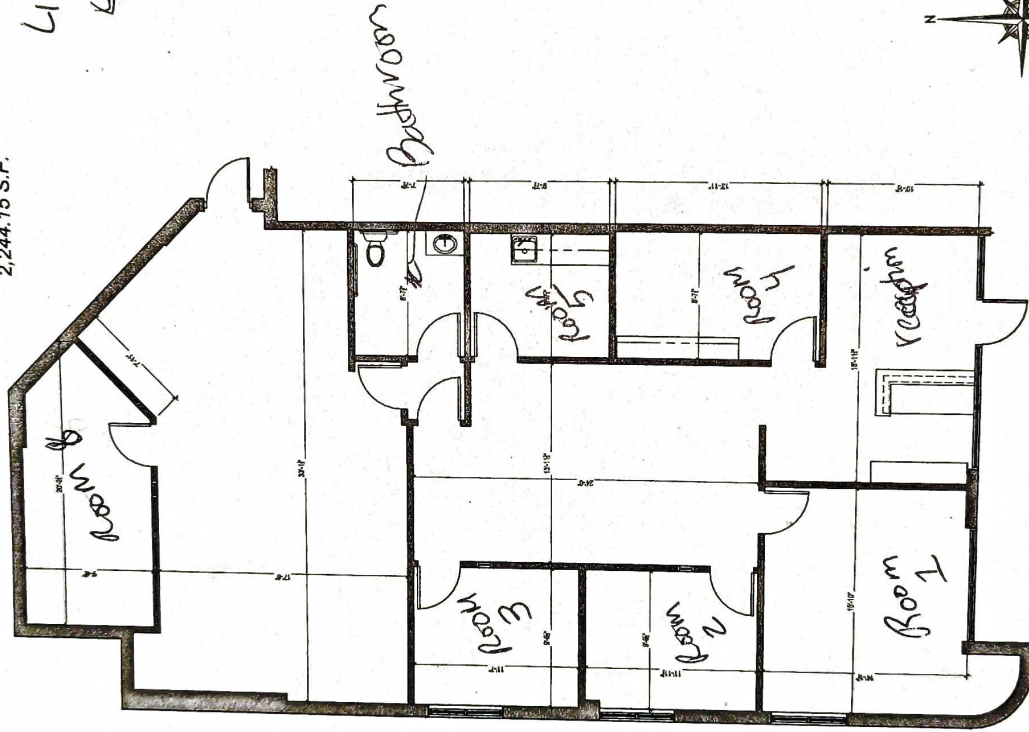

AS-BUILT FLOOR PLAN
1/4" = 1'-0"



PHOENIX DRAFTING SERVICES
PHOENIX DRAFTING SERVICE
1801 N. 19TH AVE. SUITE 109
SCOTTSDALE, AZ 85260
602.998.0777
PHOXDRAFTING@GMAIL.COM
ARCHITECT

4121 E. VALLEY
AUTO DRIVE
MESA, AZ

4121 E. VALLEY AUTO DRIV
SUITE 109
MESA, AZ 85206

10-28-19
MENLO 2019-006

REVISIONS

AB1.1
AS-BUILT FLOOR
PLAN