


**MAIN BUILDING AS BUILT**  
SCALE: 1/8" = 1'-0"

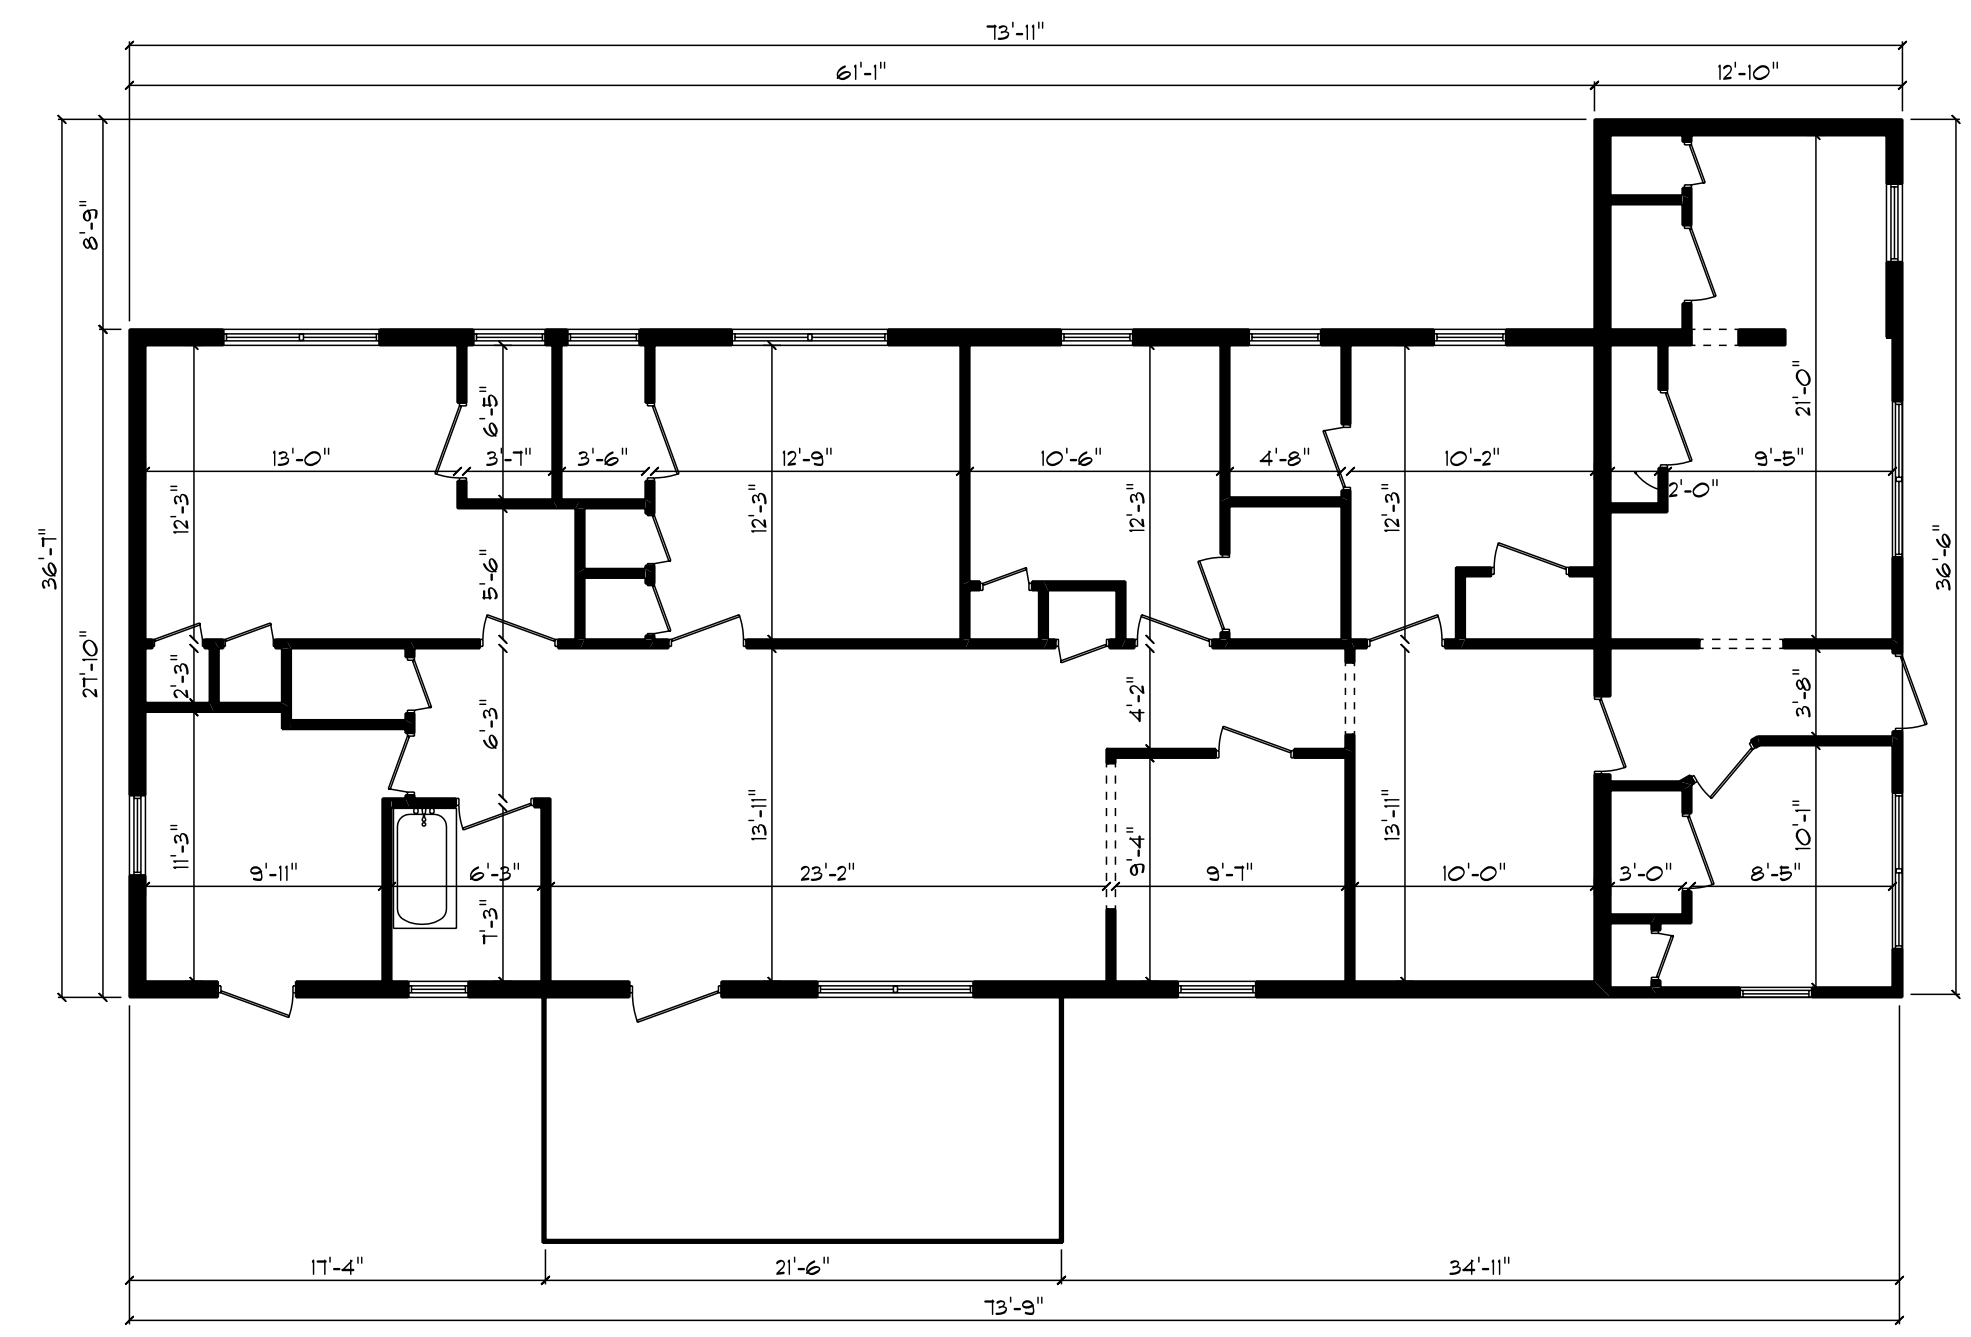

**SECONDARY BUILDING AS BUILT**  
SCALE: 1/8" = 1'-0"

AREA SCHEDULE	
AREA	SF
MAIN BUILDING	8420.2 sq ft.
SECONDARY BUILDING	2861.5 sq ft.
MAIN BUILDING PORCHES	896.2 sq ft.
SECONDARY BUILDING PORCHES	223.6 sq ft.