


- LEGEND:**
- WALL TYPE "A" - DENOTES 3 1/2" WD. STUD WALL w/ 24" O.C. w/ 1/2" GYPSUM WALL BOARD EA. SIDE TO NOTED CEILING HGT. - ANCHOR TO EXISTING WD. TRUSSES; PAINT
  - POINT OF ORIGIN
  - DENOTES COMMON PATH OF EGRESS TRAVEL FROM FURTHEST DISTANCE
  - ⊗ DENOTES WINDOW TYPE
  - ⊗ DENOTES DOOR TYPE

**NEW FLOOR PLAN 1**  
SCALE: 3/16" = 1'-0"

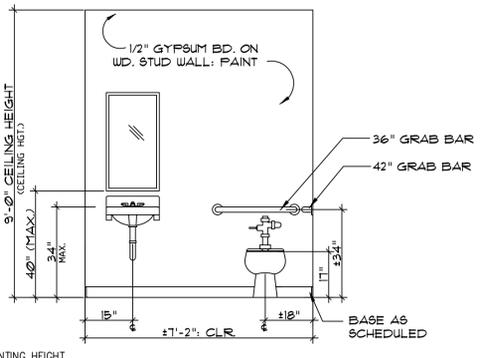

NOTE:  
SEE MOUNTING HEIGHT TABLE AND NOTES PROVIDED: ALL DIMENSIONS PER ADA STANDARDS FOR ACCESSIBLE DESIGN, 2010 ED.

**NEW H/C RESTROOM 2**  
SCALE: 3/8" = 1'-0"


**GENERAL NOTES:**

- A. MISCELLANEOUS:**
- CONTRACTOR TO FIELD VERIFY ALL EXISTING CONDITIONS PRIOR TO NEW CONSTRUCTION.
  - ALL NEW FRAMED INTERIOR WALLS TO BE 3 1/2" WOOD STUDS @ 16" O.C. w/ 1/2" THK. LAYER GYPSUM BOARD EA. SIDE - PAINT. GYPSUM BD. ATTACHED TO STUDS w/ TYPE 'S' PAN HEAD SCREWS, SECURE P.T. BASE PLATE TO CONC. FLOOR @ 24" O.C. WITH "RAMSET", 3/4" TRAKFAST PINS (19" L).
  - PROVIDE NEW WALL MOUNTED A10BC FIRE EXTINGUISHERS AS LOCATED ON NEW FLOOR PLAN.
  - CONTRACTOR TO PROVIDE ADEQUATE BLOCKING IN NEW WALLS FOR ALL TOILET ACCESSORIES & FIXTURES.
  - PROVIDE ALL NEW, HORIZONTAL - 5 PANEL, INTERIOR DOOR UNITS & HARDWARE.
  - ALL NEW INTERIOR DOOR UNITS TO BE BOTH 3'-0" w x 8'-0" h & 3'-0" w x 6'-8" h. SOLID WOOD, FIVE (5) HORIZONTAL PANELS; STAIN. SEE FINISH SCHEDULE.
  - CONTRACTOR TO COORDINATE ALL ELECTRICAL, SECURITY, FIRE ALARM, NETWORKING, TELE-COMMUNICATIONS, DATA, ETC. WITH OWNER.


**TABLE:**

ITEM	HEIGHTS	NOTES	REMARKS
WALL HUNG LAVATORIES	34" MAX.	1, 2	FROM FIN. FLR. TO TOP OF LAV. RIM
MIRRORS	40" MAX.	5	FROM FIN. FLR. TO BOTTOM OF MIRROR
GRAB BARS	33"-36"	4	FROM FIN. FLR. TO CENTERLINE OF BAR
TOILET PAPER HOLDERS	19"	3	FROM FIN. FLR. TO CENTERLINE
TOILET DISPENSER/WASTE RECEPTACLES	59" 1/2"		FROM FIN. FLR. TO TOP OF UNIT
FIRE EXTINGUISHERS	48"		FROM FIN. FLR. TO TOP OF CABINET PULL

- NOTES:**
- EXCEPT DESIGNATED HANDICAP UNITS, PROVIDE KNEE CLEARANCE THAT IS AT LEAST 21" HGH, 30" WIDE & 19" DEEP SHALL BE PROVIDED UNDERNEATH SINKS.
  - SET HANDICAP LAVATORIES AT 21" CLEAR FROM FIN. FLOOR TO BOTTOM OF LAVATORY; PROVIDE A CLEARANCE OF AT LEAST 29" ABOVE FINISH FLOOR TO BOTTOM OF LAVATORY APRON.
  - SET 36" MAX. FROM BACK WALL.
  - SET GRAB BARS IN COMPLIANCE WITH GEORGIA ACCESSIBILITY CODE.
  - MIRRORS SHALL BE MOUNTED WITH THE BOTTOM EDGE OF THE REFLECTING SURFACE NO HIGHER THAN 40" MAX. ABOVE FINISH FLOOR.

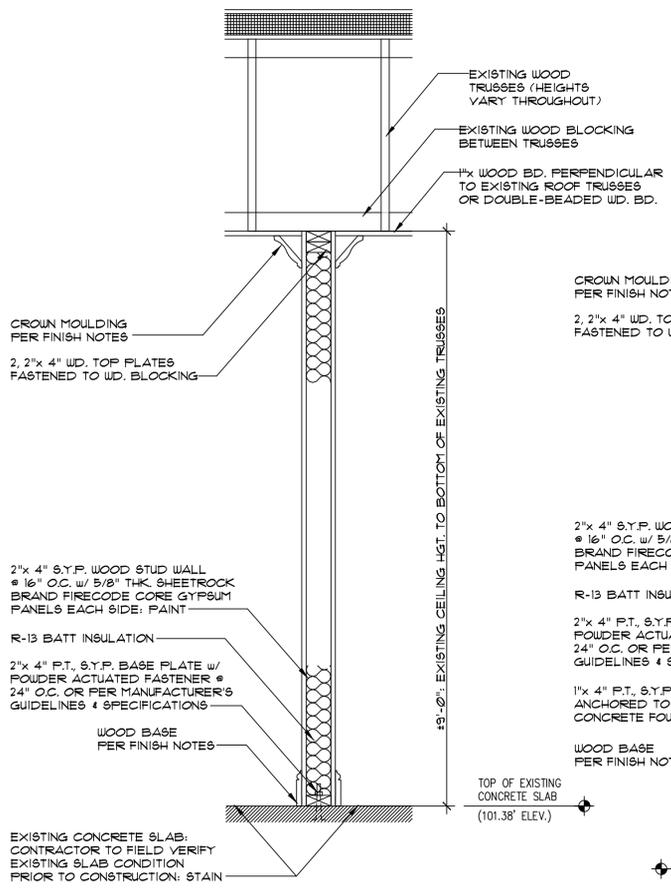

**WALL TYPE "A"**  
SCALE: 1" = 1'-0"

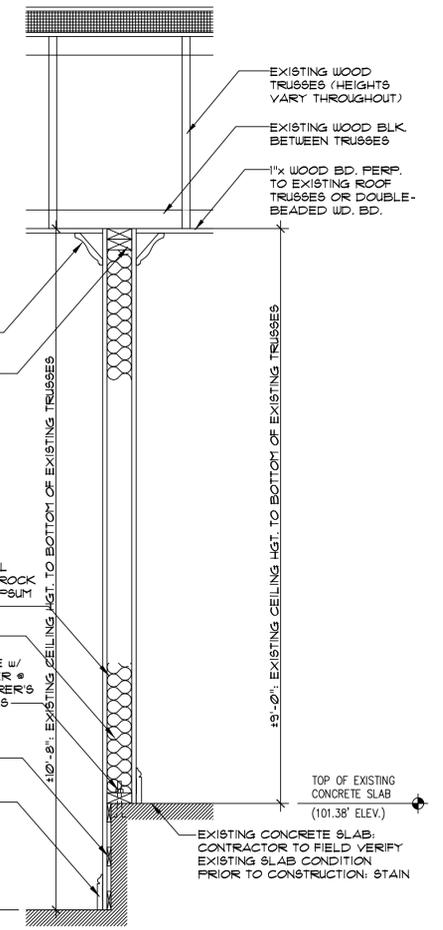

**WALL TYPE "B"**  
SCALE: 1" = 1'-0"

**SOUTHLAND ARCHITECTURE, LLC.**  
architecture / interiors / planning

100 Madison Street  
Thomasville, GA 31792  
1.229.403.7425  
tstancel@southlandarch.com

---

TROY A. STENCEL  
REGISTERED ARCHITECT

TROY ANTHONY STENCEL, ARCHITECT  
GEORGIA ARCHITECT #RA134099

---

**MADISON INVESTMENT PARTNERS, LLC.**  
Renovation & Modifications

115/119 SOUTH MADISON STREET  
THOMASVILLE, GEORGIA 31792

---

SUBMITTAL			
PHASE	DATE	DRAWN	CHECK
PERMIT	08 Nov	TAS	

---

REVISIONS	
#	REMARKS
A	03 July Plan Changes- Field Alterations

---

PROJECT NUMBER: SA19010

PHASE: AS-BUILT

SHEET TITLE: NEW FLOOR PLAN, LIFE SAFETY PLAN, INTERIOR WALL SECTIONS & NOTES

SHEET NUMBER: **A3.0**