



Re:Vision

GREEN ARCHITECTURE
SUSTAINABILITY CONSULTING
COMMUNITY ENGAGEMENT

BEST MADE CENTER

18 SOUTH 5TH STREET
QUAKERTOWN, PA



OWNER
BEST MADE CENTER, LLC

1 IRON BRIDGE DRIVE
COLLEGEVILLE, PA 19426
P: 610.489.9131




DESIGN/BUILDER
GORSKI ENGINEERING

1 IRON BRIDGE DRIVE
COLLEGEVILLE, PA 19426
P: 610.489.9131

ARCHITECT
RE:VISION ARCHITECTURE

133 GRAPE STREET
PHILADELPHIA, PA 19127
P: 215.482.1133

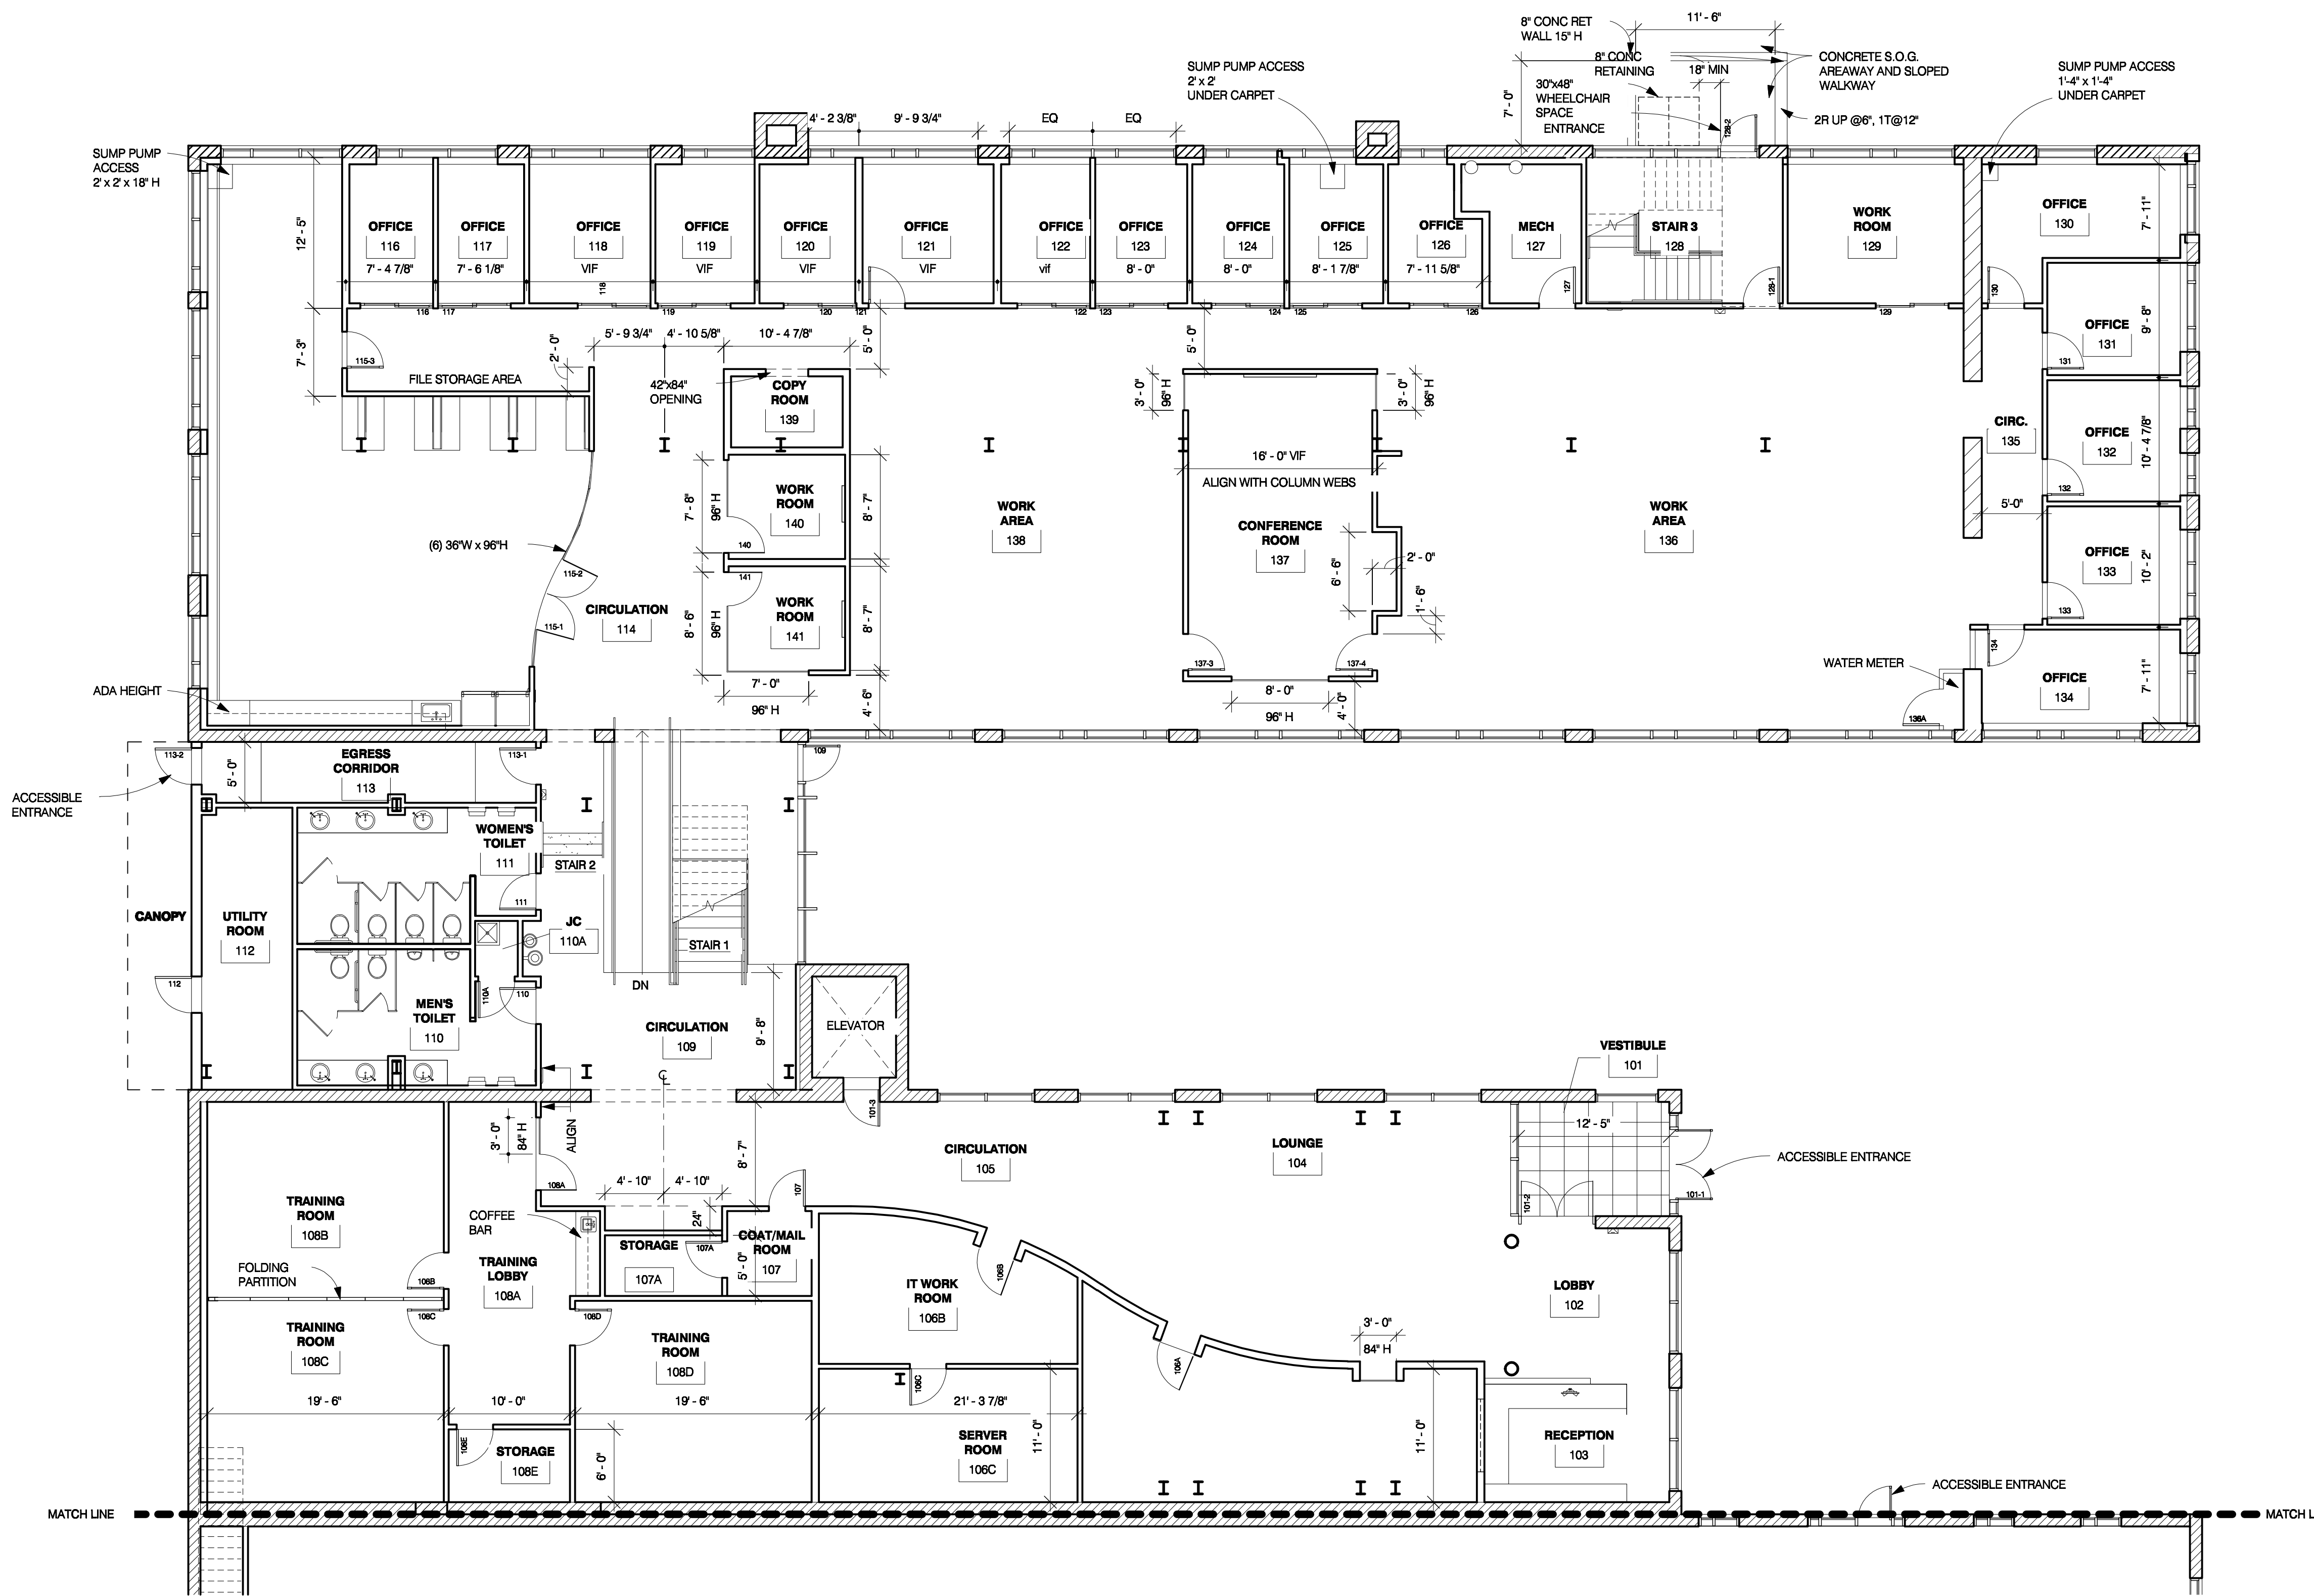

LEVEL ONE:
13,300 S.F.

LEVEL 1 ROOM SCHEDULE

| No. | NAME | SIGN | SIGN TEXT |
|------|-----------------|------|---|
| 101 | VESTIBULE | No | - |
| 102 | LOBBY | No | - |
| 103 | RECEPTION | No | - |
| 104 | LOUNGE | No | - |
| 105 | CIRCULATION | No | - |
| 106A | IT | - | - |
| 106B | IT WORK ROOM | Yes | IT WORK ROOM |
| 106C | SERVER ROOM | Yes | SERVER ROOM |
| 107 | COAT/MAIL ROOM | Yes | MAIL ROOM |
| 108A | TRAINING LOBBY | Yes | TRAINING SUITE |
| 108B | TRAINING ROOM | Yes | TRAINING ROOM 1 |
| 108C | TRAINING ROOM | Yes | TRAINING ROOM 2 |
| 108D | TRAINING ROOM | Yes | TRAINING ROOM 3 |
| 108E | STORAGE | No | - |
| 109 | CIRCULATION | No | - |
| 110 | MEN'S TOILET | Yes | MEN |
| 110A | JC | Yes | JANITORIAL |
| 111 | WOMEN'S TOILET | Yes | WOMEN |
| 112 | UTILITY ROOM | No | - |
| 113 | EGRESS CORRIDOR | Yes | EXIT |
| 114 | CIRCULATION | No | - |
| 115 | CAFE | Yes | CAFE |
| 116 | OFFICE | Yes | OFFICE |
| 117 | OFFICE | Yes | OFFICE |
| 118 | OFFICE | Yes | OFFICE |
| 119 | OFFICE | Yes | OFFICE |
| 120 | OFFICE | Yes | OFFICE |
| 121 | OFFICE | Yes | OFFICE |
| 122 | OFFICE | Yes | OFFICE |
| 123 | OFFICE | Yes | OFFICE |
| 124 | OFFICE | Yes | OFFICE |
| 125 | OFFICE | Yes | OFFICE |
| 126 | OFFICE | Yes | OFFICE |
| 127 | MECH | Yes | MECHANICAL ROOM - AUTHORIZED PERSONNEL ONLY |
| 128 | STAIR 3 | Yes | EXIT |
| 129 | WORK ROOM | Yes | WORK ROOM |
| 130 | OFFICE | Yes | OFFICE |
| 131 | OFFICE | Yes | OFFICE |
| 132 | OFFICE | Yes | OFFICE |
| 133 | OFFICE | Yes | OFFICE |
| 134 | OFFICE | Yes | OFFICE |
| 135 | CIRC. | No | - |
| 136 | WORK AREA | No | - |
| 137 | CONFERENCE ROOM | Yes | CONFERENCE ROOM |
| 138 | WORK AREA | No | - |
| 139 | COPY ROOM | Yes | COPY ROOM |
| 140 | WORK ROOM | Yes | WORK ROOM |
| 141 | WORK ROOM | Yes | WORK ROOM |

- ROOM SIGNAGE NOTES:
- ALL SIGN DESIGN, CONSTRUCTION AND MOUNTING TO COMPLY WITH ICC/ANSI A117.1-2003, SECTION 703
 - ALL SIGNS TO INCLUDE TACTILE CHARACTERS AND BRAILLE
 - SIGNS TO BE WALL MOUNTED ON THE LATCH SIDE OF DOORS ENTERING THE ROOM BEING REFERENCED
 - RESTROOM SIGNS TO INCLUDE MALE OR FEMALE PICTOGRAM
 - TACTILE EXIT SIGNS TO BE MOUNTED AT ALL EXIT STAIRS, EXIT CORRIDORS AND EXIT VESTIBULES TO COMPLY WITH IBC SECTION 1011.3
 - STAIR 3 AND STAIR 5 TO HAVE SIGNS ON THE STAIRWELL LATCH SIDE OF DOORS INDICATING THE FLOOR LEVEL AND STORY OF EXIT DISCHARGE
 - SPACES DESIGNATED AS ASSEMBLY OCCUPANCY SHALL HAVE THE CODE OCCUPANCY POSTED IN CONSPICUOUS LOCATION APPROVED IN FIELD BY AHJ.
 - SIGNS STATING "SMOKING SHALL NOT BE PERMITTED WITHIN 25' OF THIS ENTRANCE" SHALL BE POSTED AT THE INTERIOR AND EXTERIOR OF ALL ENTRANCE AND EGRESS DOORS.

- GENERAL FLOOR PLAN NOTES:
- UNLESS NOTED OTHERWISE, ALL NEW WALLS TO I TYPE G2.
 - UNLESS NOTED OTHERWISE, ALL NEW WALLS AT EXISTING BUILDING PERIMETER TO BE TYPE G1.
 - EXISTING WALLS SHOWN WITH DIAGONAL HATCH PATTERN
 - ALL EXISTING EXTERIOR WALLS 12" SOLID MASONRY UNLESS OTHERWISE NOTED


REVISIONS

| DATE | ITEM |
|------|------|
| | |

AS-BUILT PLAN

DATE: 01.02.15
SCALE: 1/8" = 1'-0"
TITLE: LEVEL 1 FLOOR PLAN

SHEET NO.:
A2.2

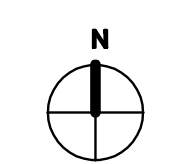

AS-BUILT

CONTRACTOR TO VERIFY ALL DIMENSIONS IN FIELD AND INFORM ARCHITECT OF ANY DISCREPANCIES BEFORE STARTING WORK.

© COPYRIGHT RE:VISION ARCHITECTURE, 2014