


## Suite A-201-205 | 3,798 SF

AS BUILT FLOOR PLAN

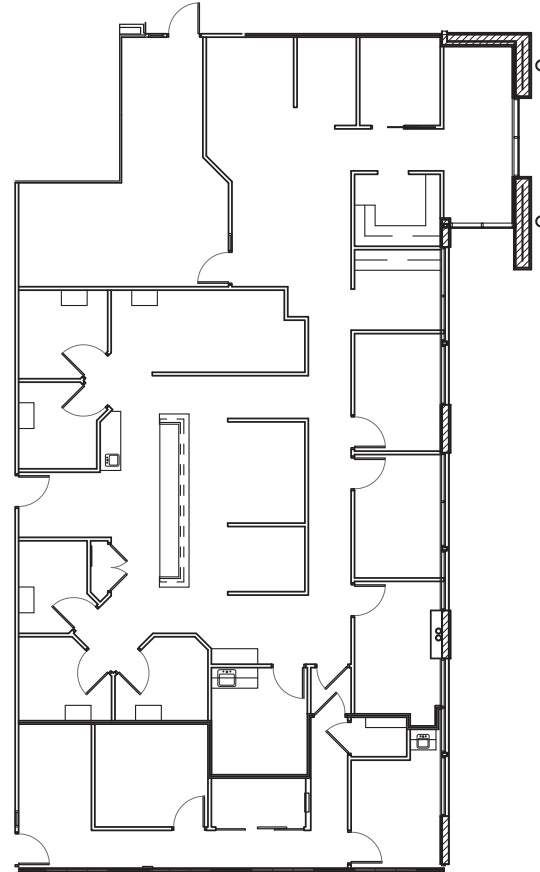

OWNED BY



LEASING BY

**Rachael Thompson**

602.513.5122

rachael.thompson@kidder.com

**Perry Gabuzzi, CCIM**


602.513.5116

perry.gabuzzi@kidder.com



## Suite A-201-205 | 3,798 SF

### TEST FIT FLOOR PLAN

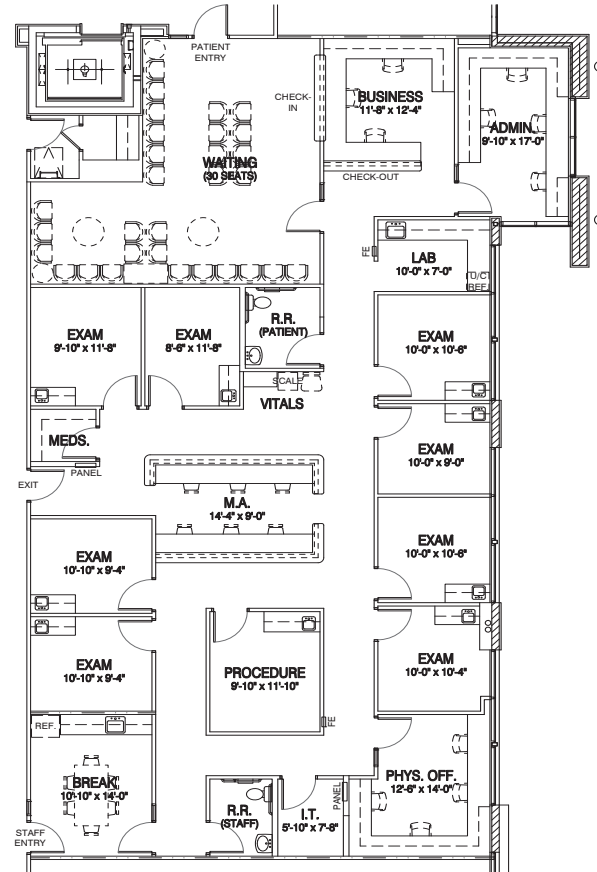

### OWNED BY



### LEASING BY


Rachael Thompson  
602.513.5122  
rachael.thompson@kidder.com

Perry Gabuzzi, CCIM  
602.513.5116  
perry.gabuzzi@kidder.com



## Suite A-207 | 1,159 SF

AS BUILT FLOOR PLAN

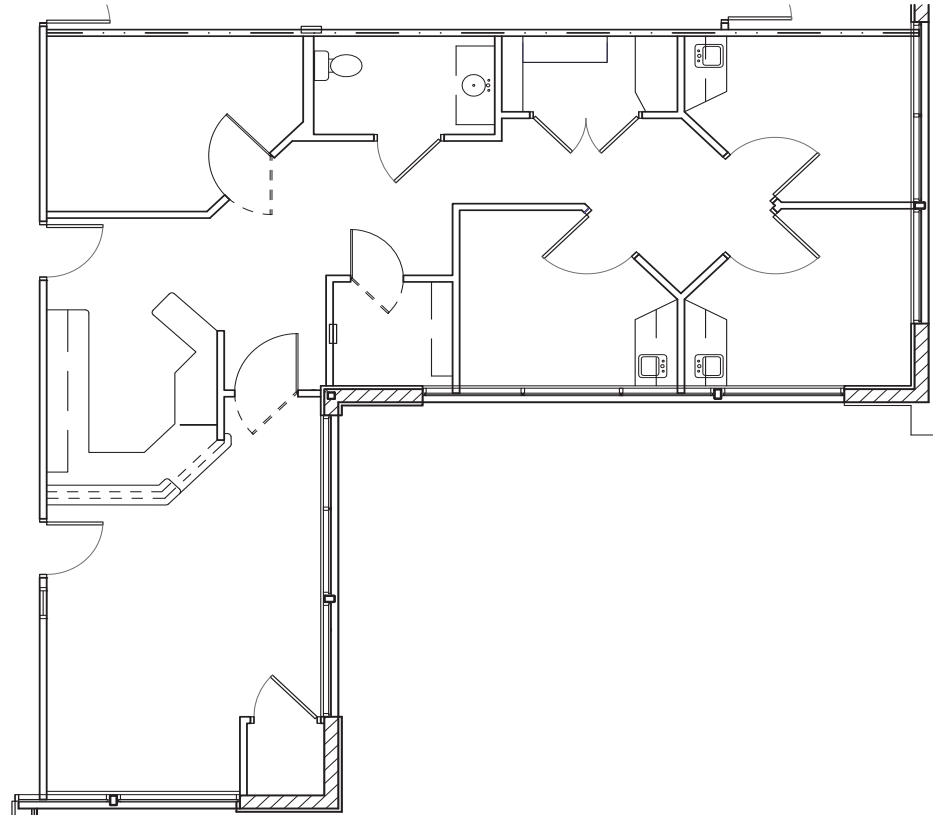

OWNED BY



LEASING BY

Rachael Thompson

602.513.5122

rachael.thompson@kidder.com

Perry Gabuzzi, CCIM


602.513.5116

perry.gabuzzi@kidder.com



## Suite A-209 | 1,597 SF

AS BUILT FLOOR PLAN

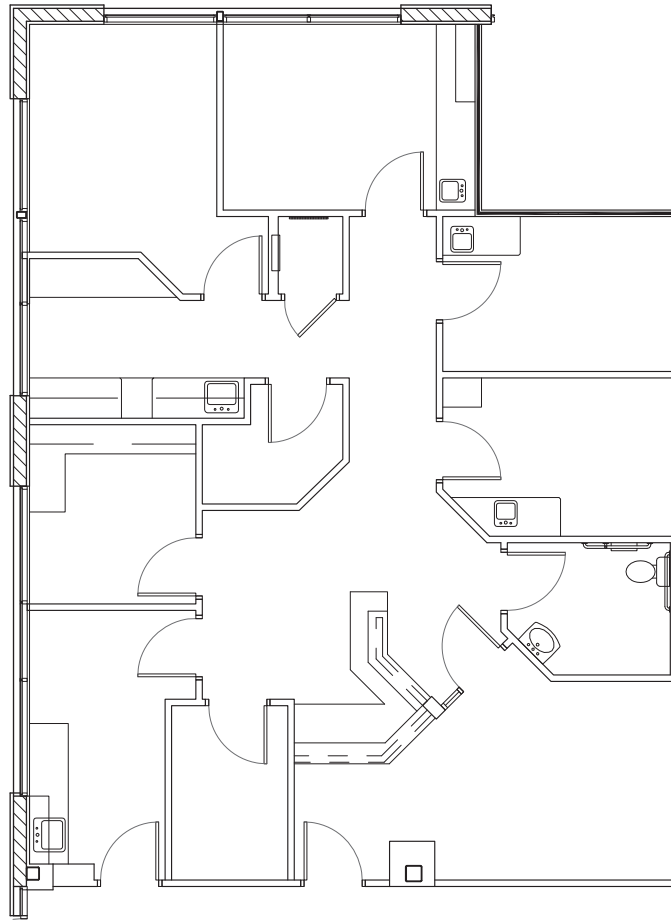

OWNED BY



LEASING BY

**Rachael Thompson**

602.513.5122

rachael.thompson@kidder.com

**Perry Gabuzzi, CCIM**


602.513.5116

perry.gabuzzi@kidder.com



## Suite B-221 | 4,580 SF

### AS BUILT FLOOR PLAN

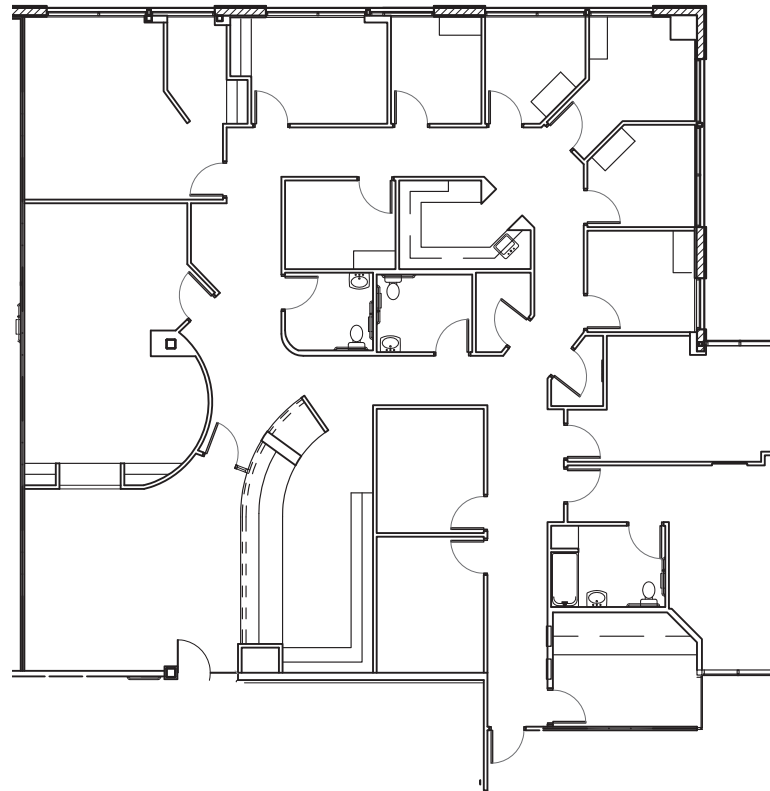

#### OWNED BY



#### LEASING BY

**Rachael Thompson**

602.513.5122

rachael.thompson@kidder.com

**Perry Gabuzzi, CCIM**


602.513.5116

perry.gabuzzi@kidder.com



## Suite B-221 | 4,580 SF

### TEST FIT FLOOR PLAN

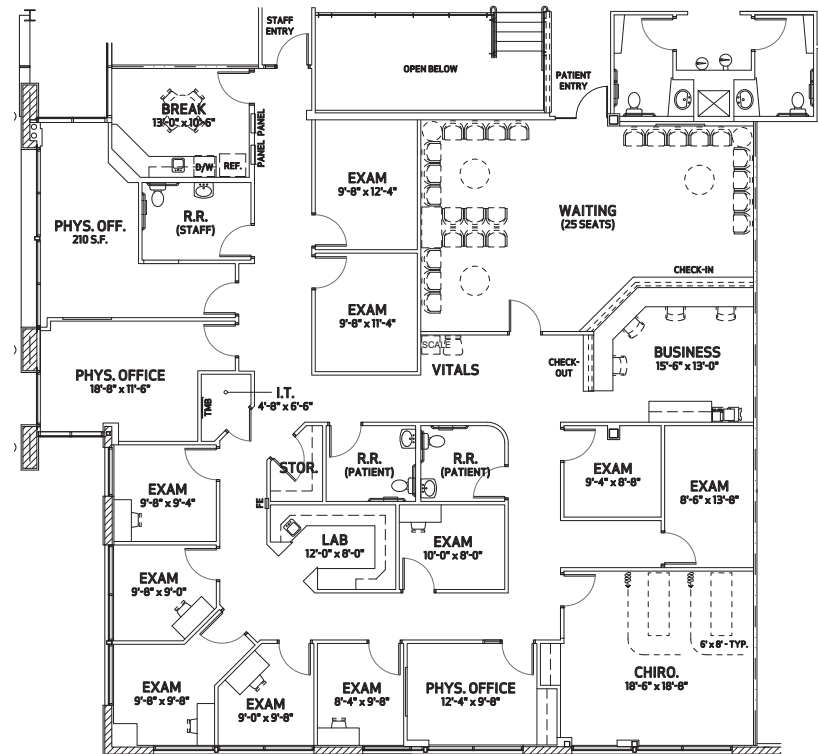

### OWNED BY



### LEASING BY

**Rachael Thompson**  
602.513.5122  
rachael.thompson@kidder.com

**Perry Gabuzzi, CCIM**  
602.513.5116  
perry.gabuzzi@kidder.com

