



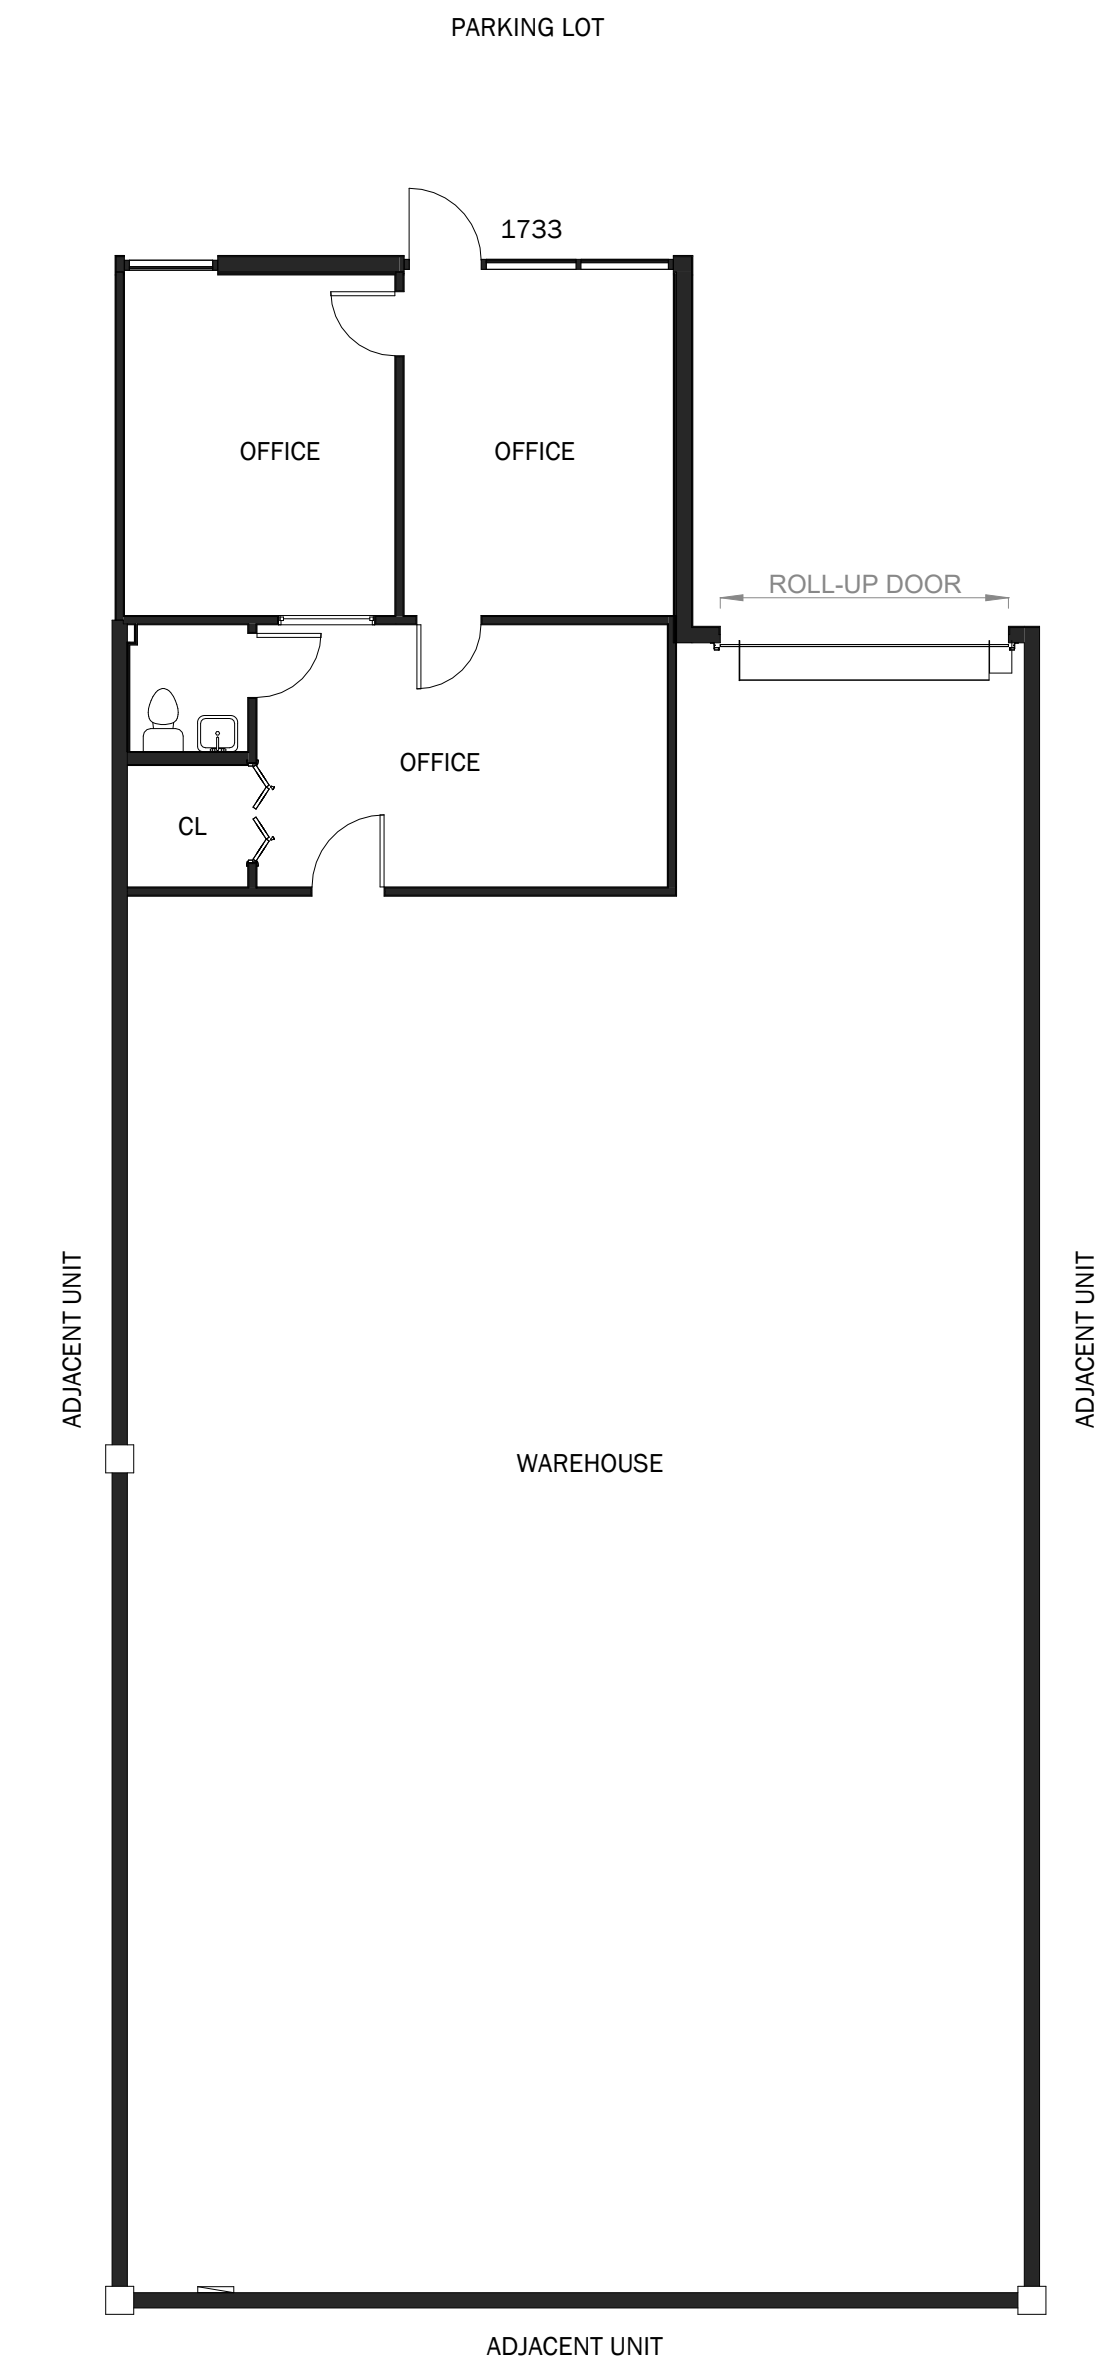

1 GROUND LEVEL FLOOR PLAN
1/8" = 1'-0"

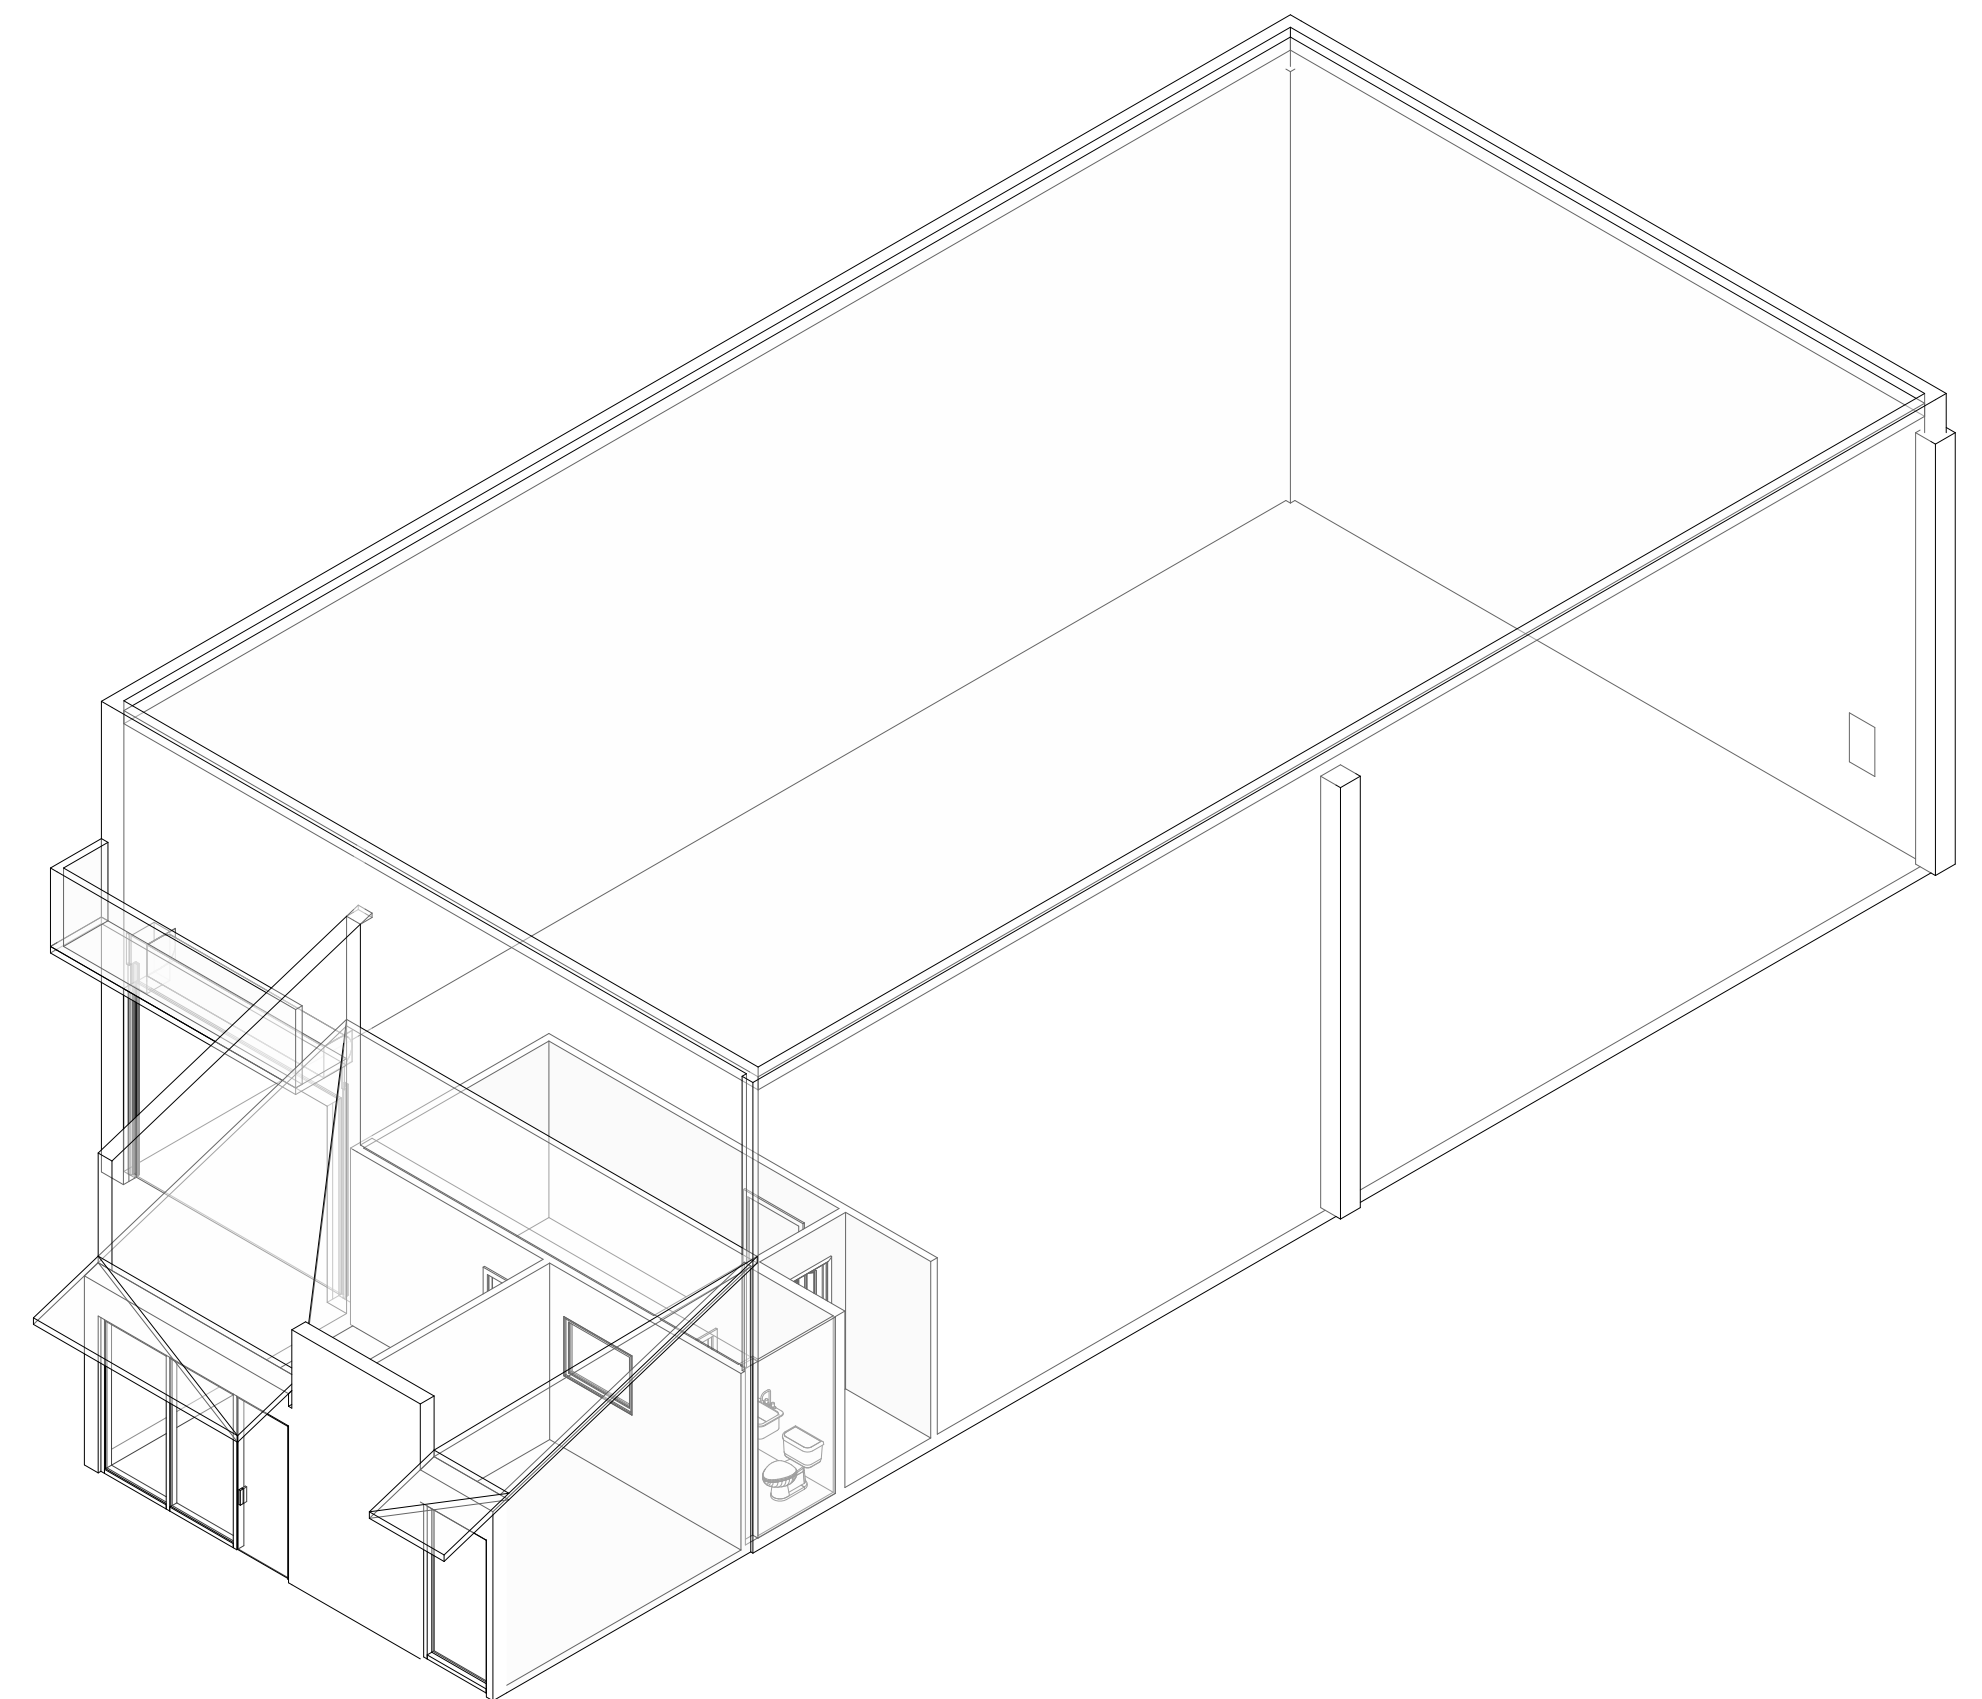

2 3D



1733 NW 79 AVE	
NAME	AREA
WAREHOUSE	2394 SF
OFFICE	622 SF
	3016 SF

ADDRESS: 1733 NW 79 AVE
FOLIO: 35-3034-006-0010

FEATURES:
• ONE SINGLE-STALL BATHROOM. • ONE 12' WIDE ROLL-UP DOOR. • ONE WAREHOUSE SPACE. • THREE OFFICE SPACES.

AS-BUILT CONDITIONS

1733 NW 79 AVE

DATE PRODUCED: 12/14/23



RUKAN

7925 NW 12 STREET, STE 312
DORAL, FL 33126

786.547.0363