


Southwest Utah Public Health Department

SEPTIC SYSTEM PERMIT

This is NOT a building permit. Building permit must be obtained from the appropriate local authority prior to starting construction.

NAME Henry Alexander ADDRESS Lot 21 Plat A Big Water PERMIT No **2275**

Sketch of System As Installed:

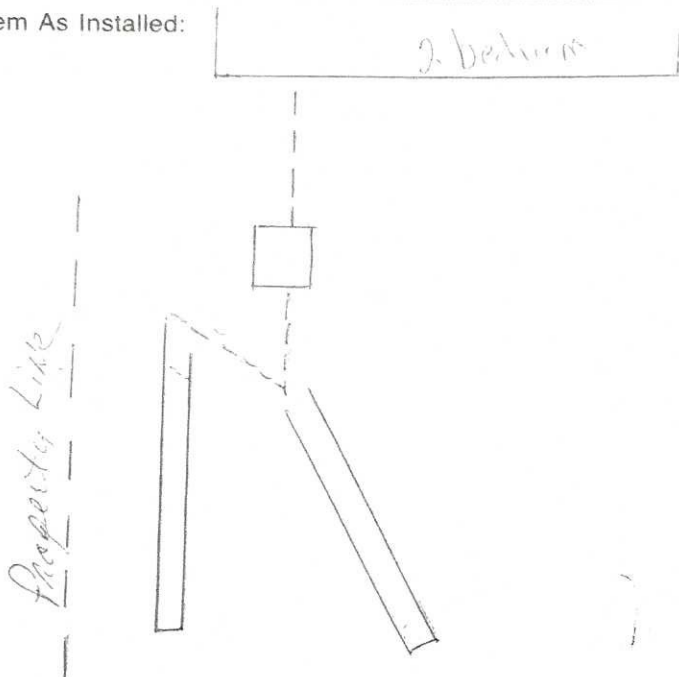

Inspection Date: 4-26-94 Approved ☒ Rejected ☐

Comments: _____

White - Office
Pink - City or County
Blue - Financing Agency
Buff - On site

NONE

[Signature]
Environmental Health Specialist

NAME Henry Alexander Number of Bedrooms two
ADDRESS Lot 21, Plat A Big Water Basement No
Percolation Rate 8 Min/in.
Tank Size 950 Gal.
Absorption Area 12 infiltrators Sq. Ft.
Water Supply City
Fees PAID: \$ 50.00 REC'D BY cln
Plans Approved: Date: 3-29-94 By RNN
Permit expires 1 year from issue date.

Southwest Utah Public Health Department

PERMIT MUST BE POSTED ON-SITE

No **2275**

System must be installed as per approved plans or final approval will be withheld, unless other arrangements are made prior to installation. After construction and installation of the system, but prior to covering or putting in use, it will be necessary for us to conduct an on-site field inspection in order to grant final approval. Inspection arrangements must be facilitated by letting us know in advance when the system will be ready for inspection.

Alexander, Henry
Lot 21 Plat A
Big Water, Utah
50 is Concord