


AS-BUILT FLOOR PLAN
 NOT FOR CONSTRUCTION
 KELLOGG DEVELOPMENT COMPANY
 CHARTERED ACCOUNTANTS
 300 HIGHLAND PARK, N.E. 25TH ST.
 SUITE 1000, MIAMI, FL 33136
 TAYLOR
 ARCHITECTS
 1000 BAYVIEW BLVD., SUITE 1000
 MIAMI, FL 33134
 PROJECT 7-10-10

ISLAND LAKE CENTER
 1001 STATE ROAD 44
 MIAMI, FL 33136
 5,370 sq. ft.
 SUITE 136
 5,370 sq. ft.

AS-BUILT FLOOR PLAN
 THIS IS NOT A SURVEY. ALL DIMENSIONS ARE
 NORMAL AND SUBJECT TO FIELD VERIFICATION.
 0 4' 8' 16'
 1/8"=1'-0"

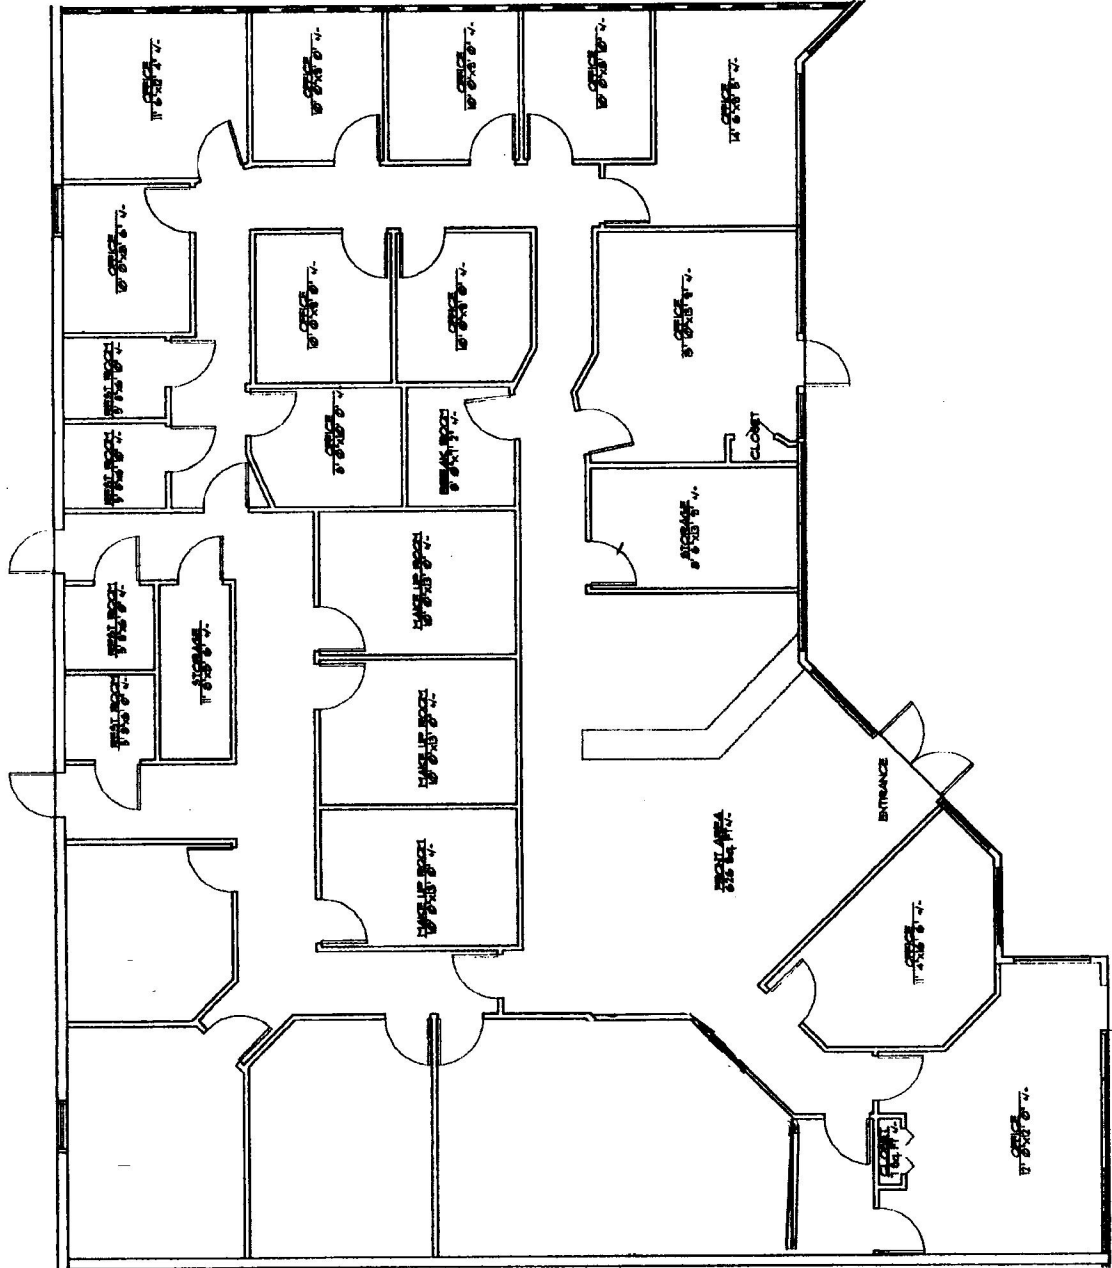

1001 STATE ROAD 44, MIAMI, FL 33136
 5,370 sq. ft. SUITE 136