

ROUTE 67 BAR AND GRILL


1380 HWY 67 ALVARADO TX

AS-BUILT FLOOR PLAN

PROJECT NO: #
ISSUE DATE: 06-02-21
REV 1:
REV 2:

A100

1,380 HWY 67
ALVARADO, TX
4,501 SF TOTAL FOOTPRINT

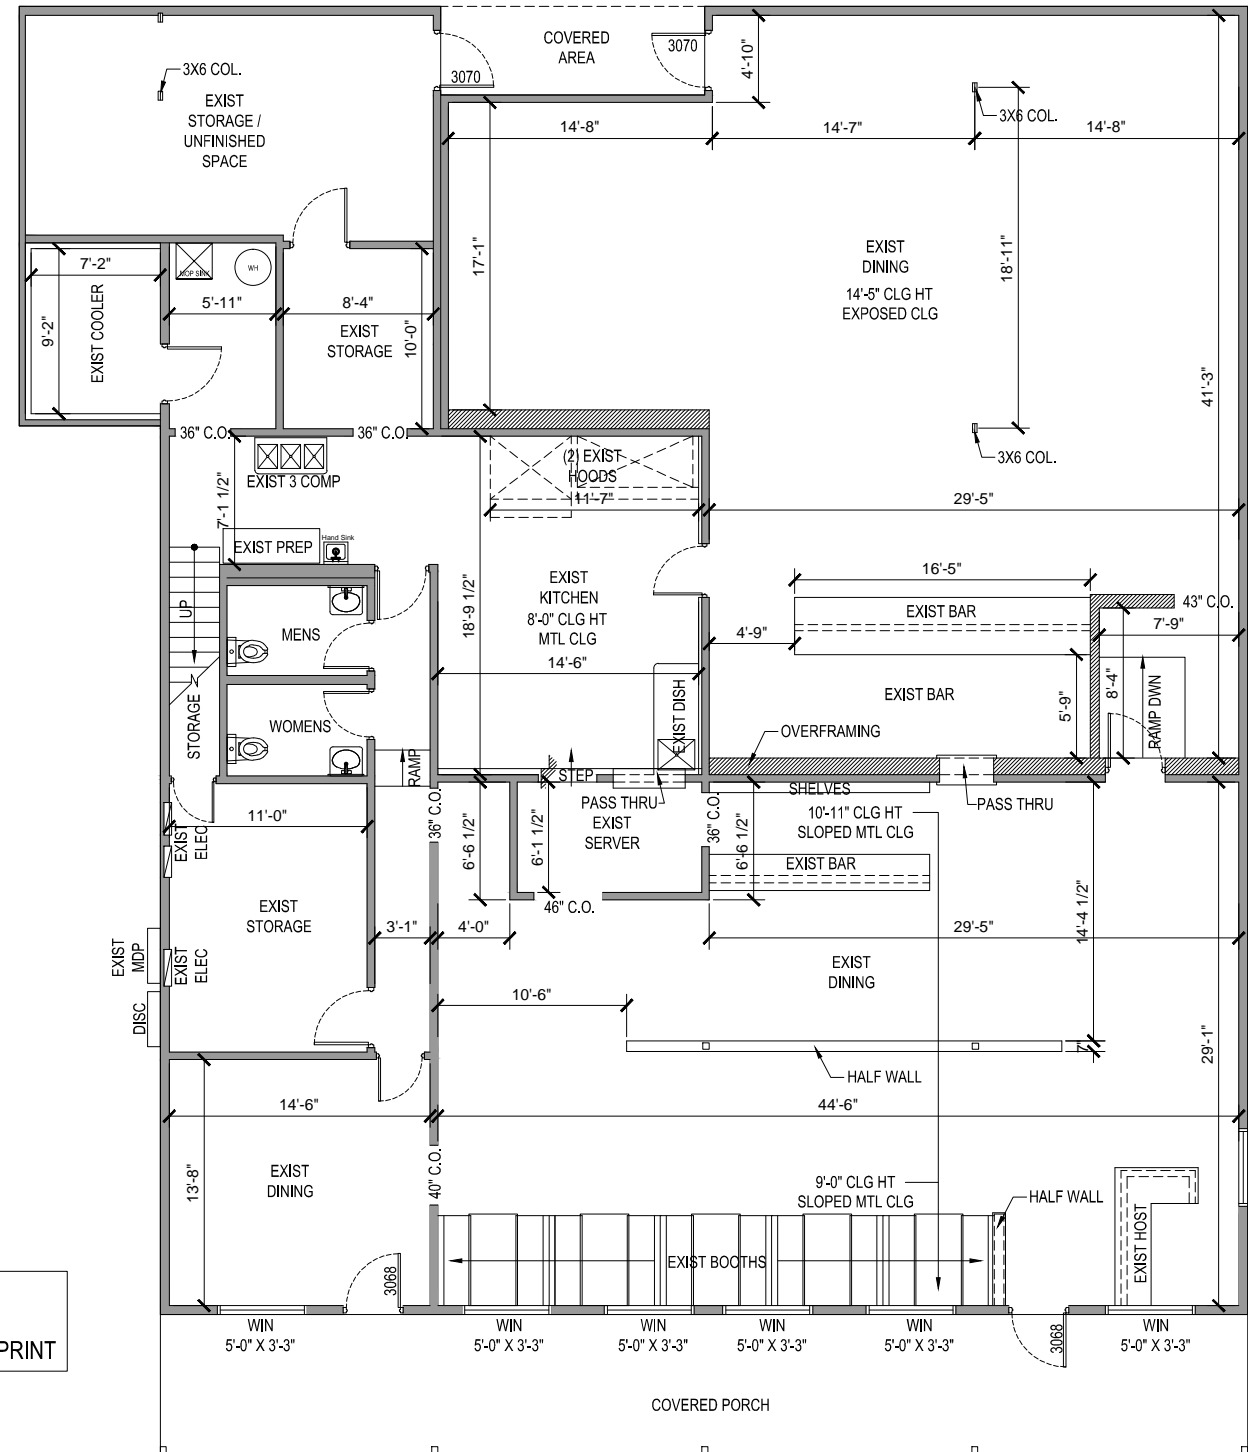

1 AS-BUILT
Scale: 3/32" = 1'-0"