
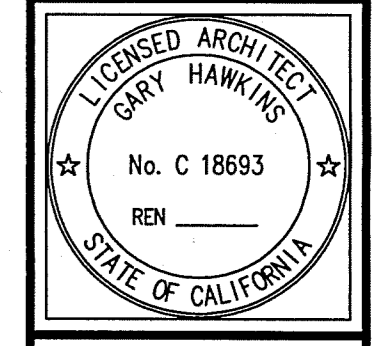


BUILDING AREA	
EXISTING CONDITIONED AREA:	53,191 Square Feet

AS BUILT FLOOR PLAN
 SCALE: 1/16"=1'-0"
 0' 4' 8' 12' 16' 32'

Revisions:
 Plot Date: 1/11/2024

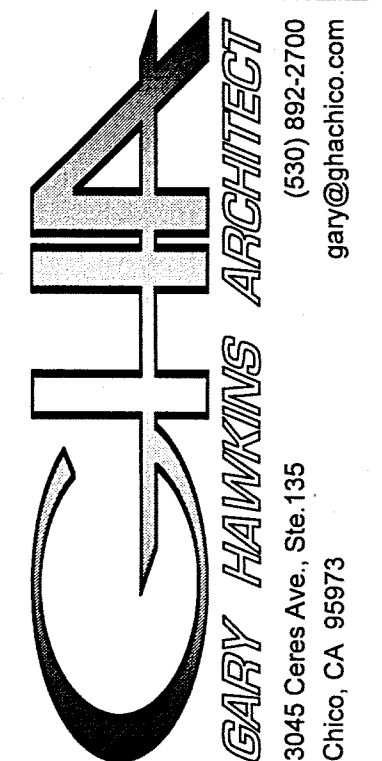

Commercial Infill for:
GECCo Development, LLC
 2445 Carmichael Dr. Chico, Ca.
 APN: 005-570-010-000

Date: 1-2024
 Drawn: GC
 Job No: 24-050
 SHEET NAME:
 AS BUILT FLOOR PLAN

SHEET NUMBER:
A1.1
 of: