


1 AS-BUILT - FIRST FLOOR PLAN
 A1 SCALE: 1/4"=1'-0"

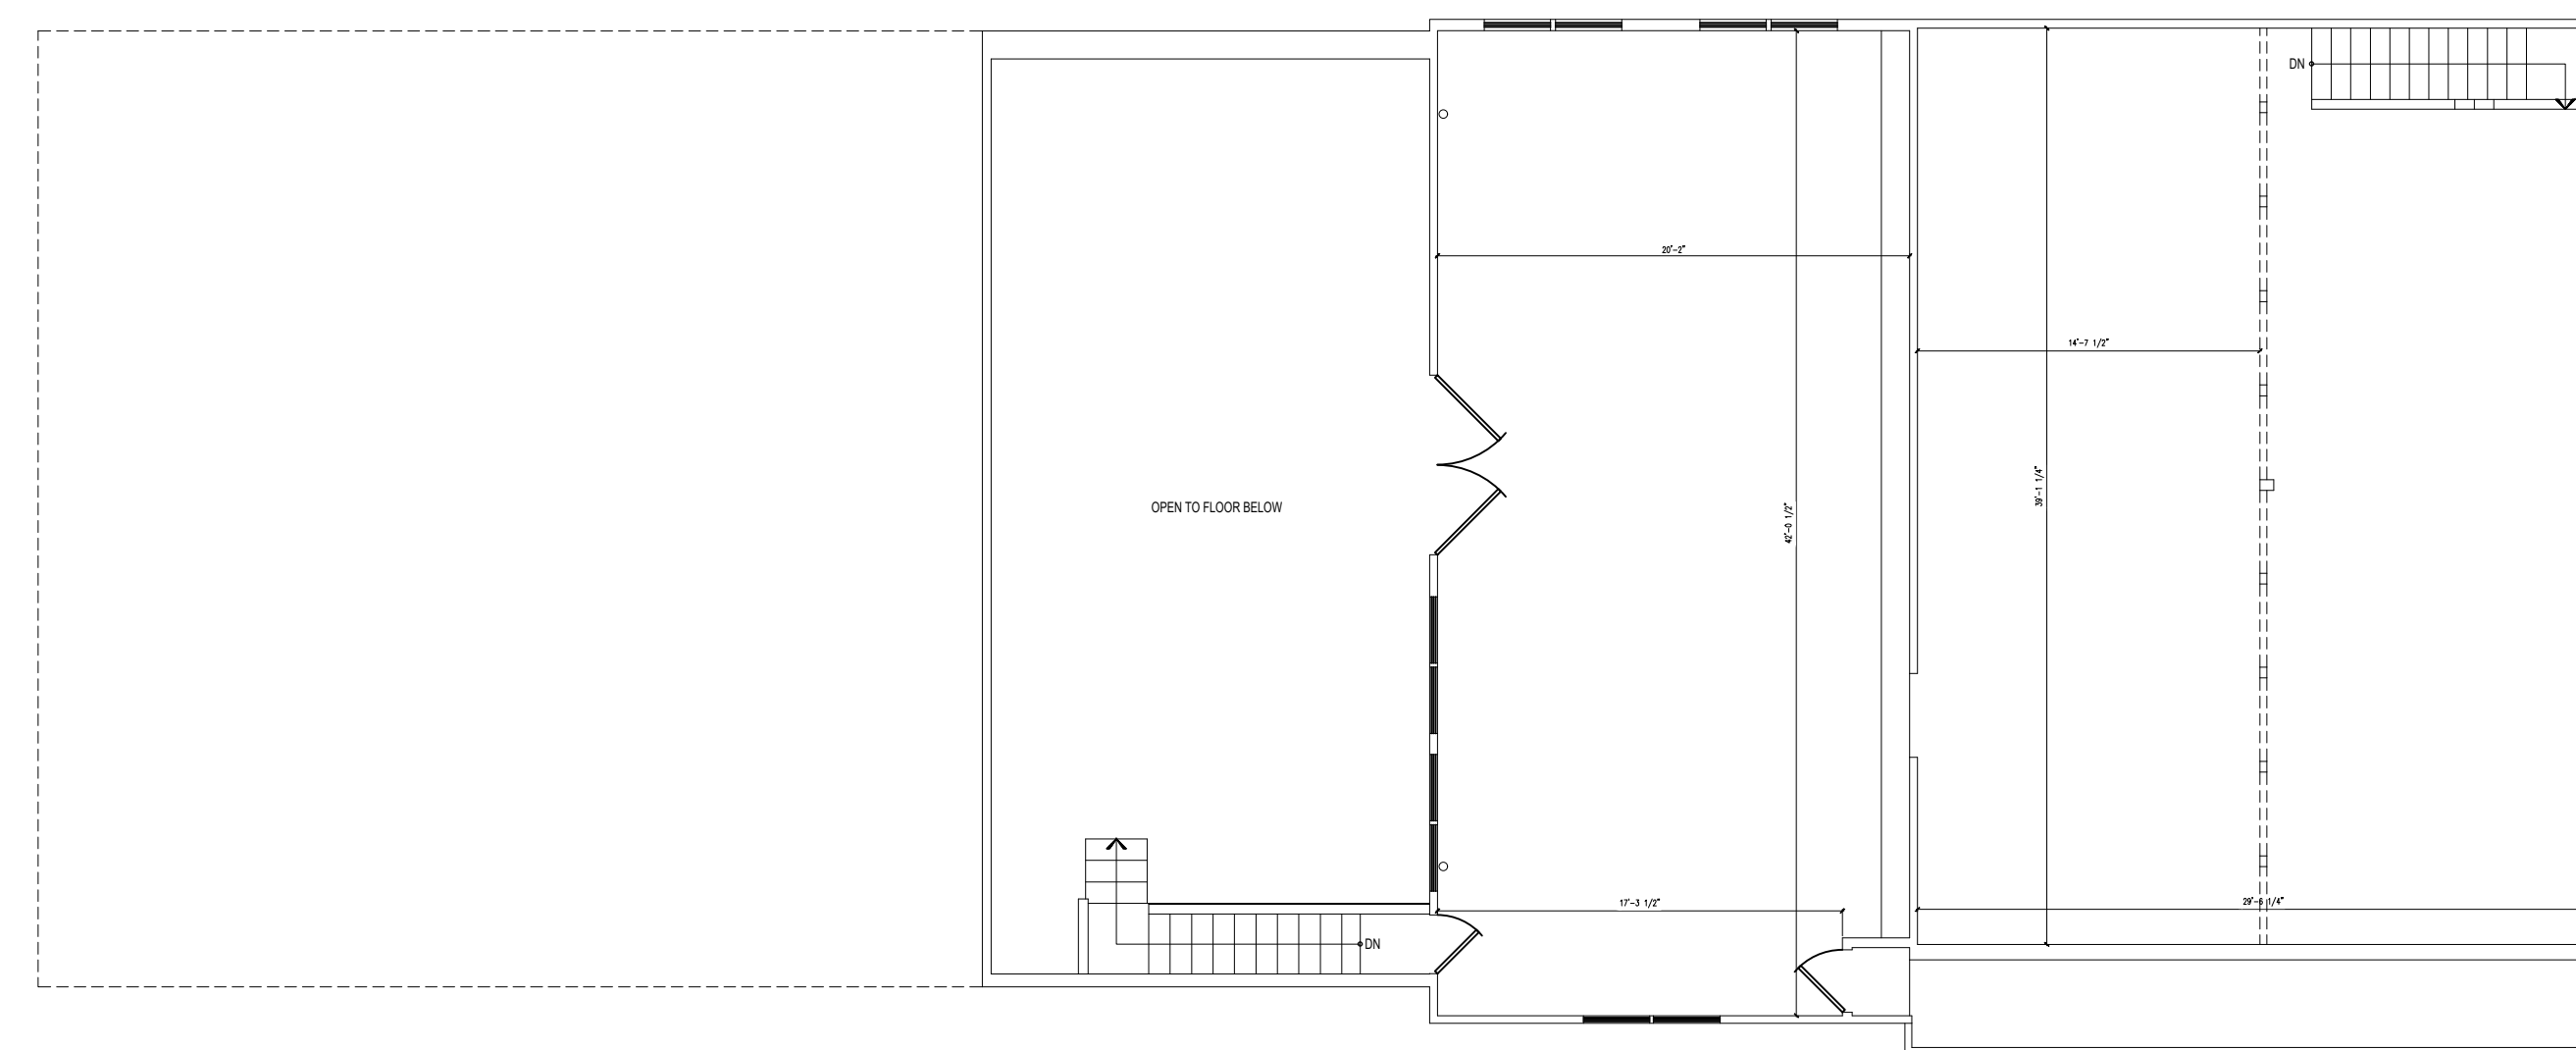

2 AS-BUILT - SECOND FLOOR PLAN
 A1 SCALE: 1/4"=1'-0"