


Spaces are currently combined for 2,010 SF but can be easily divided back into two spaces.

Suite 30
1275 SF

Suite 20
735 SF

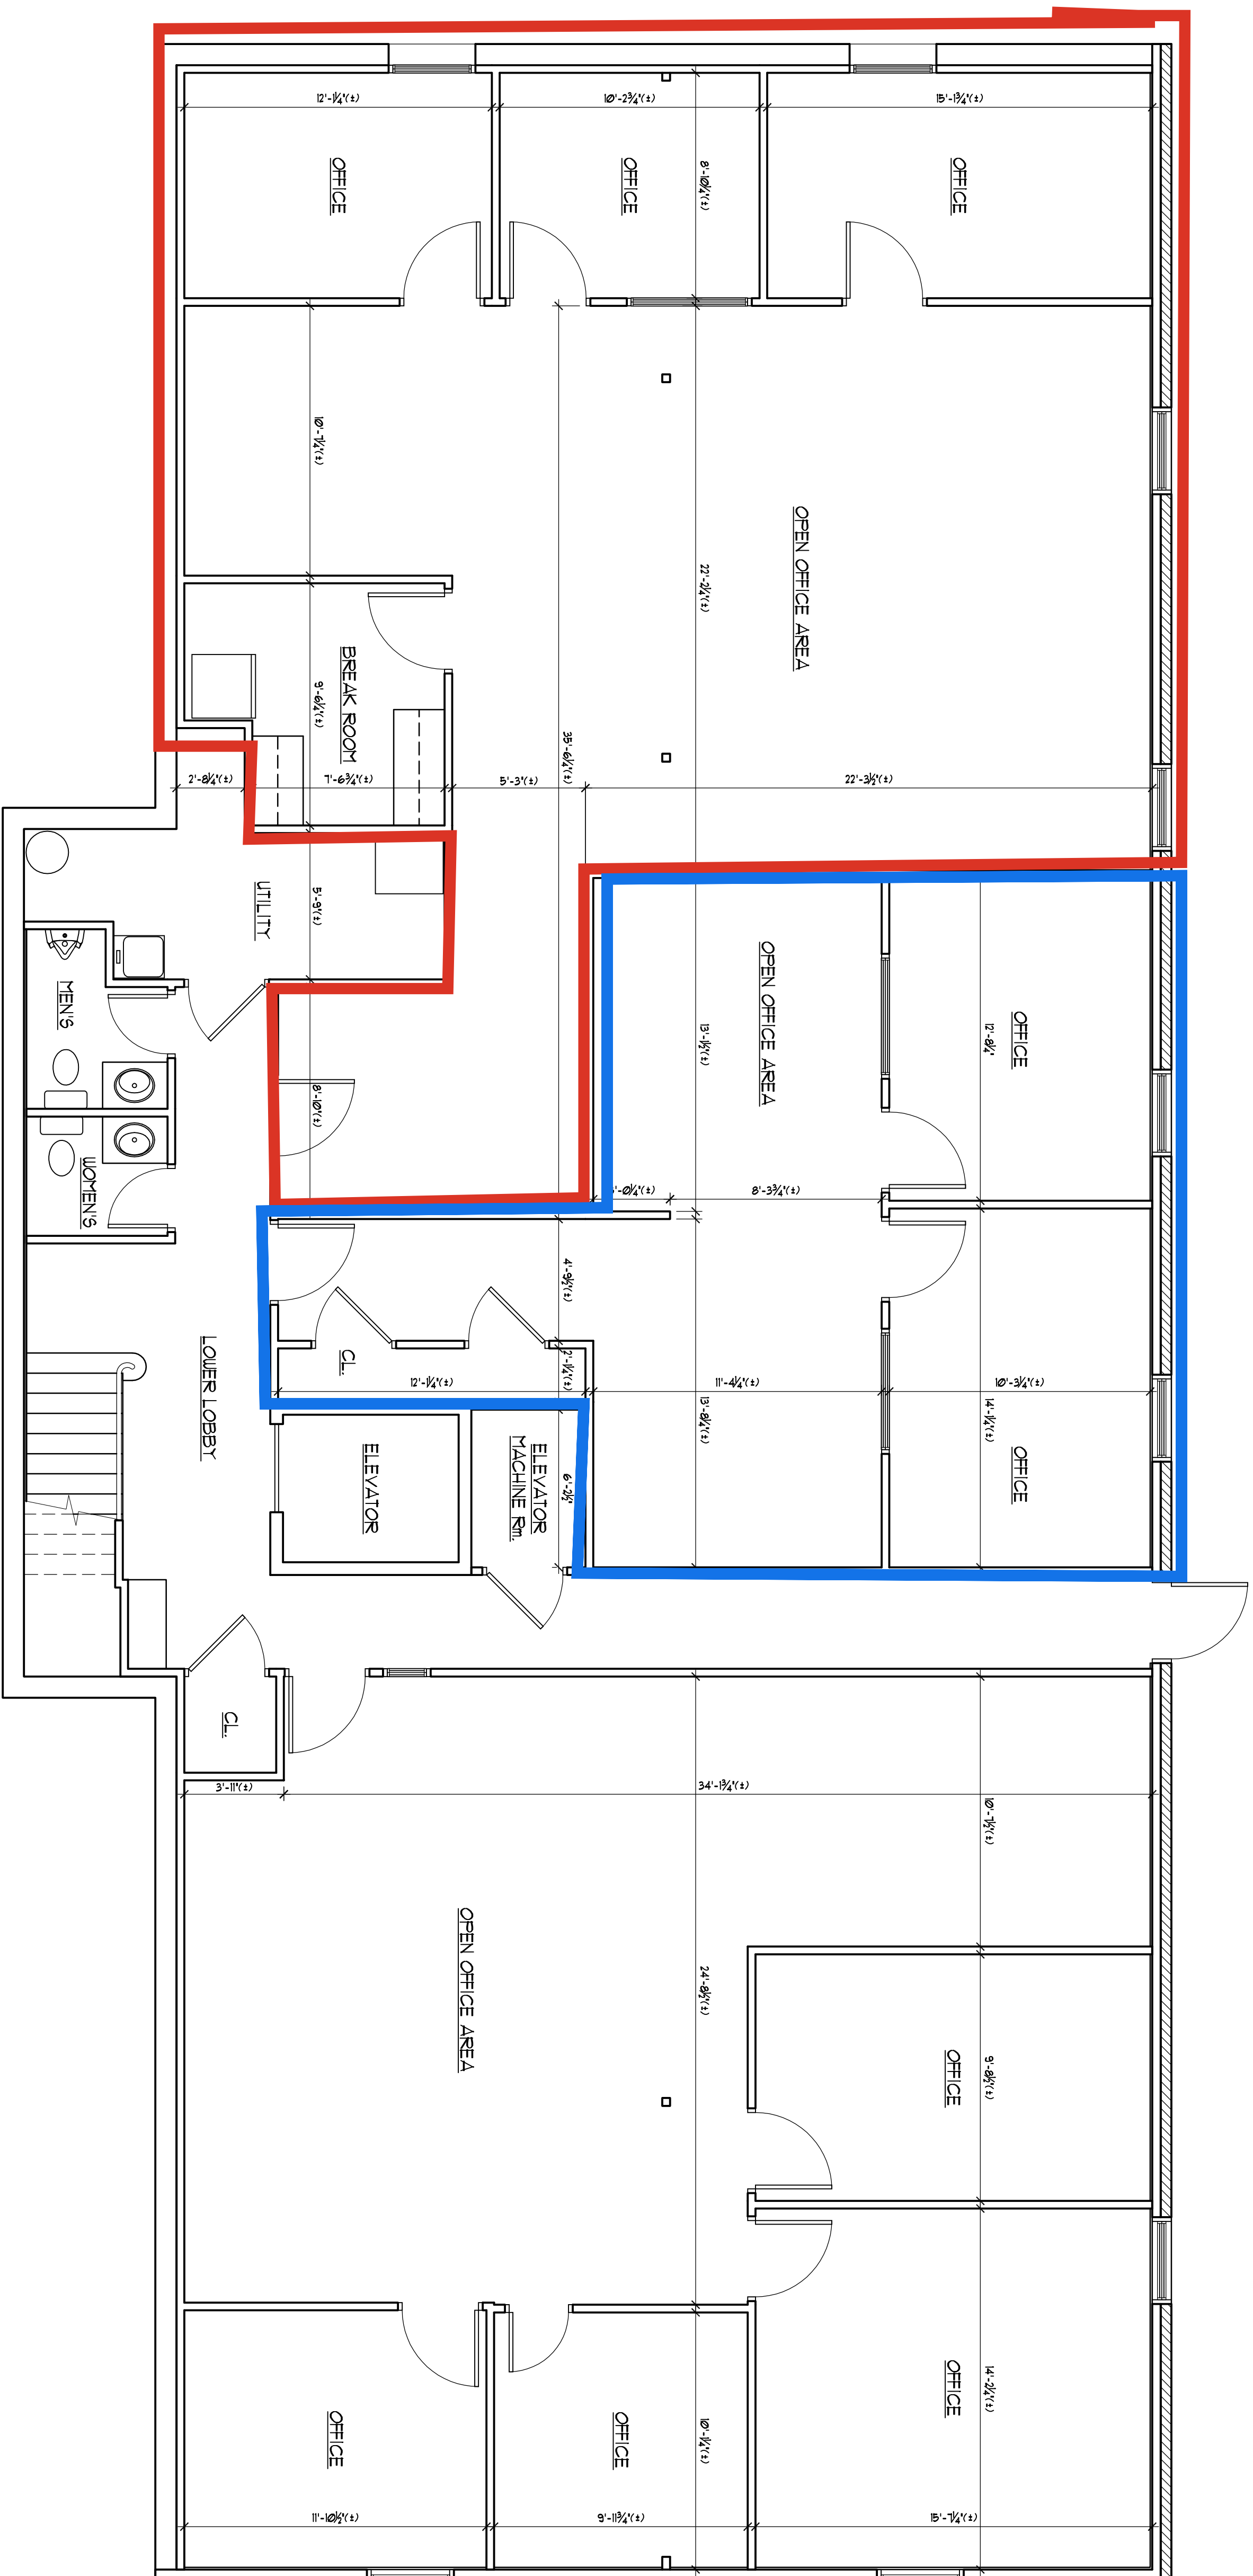

EXISTING LOWER LEVEL FLOOR PLAN

SCALE: 1/4" = 1'-0"

Copyright by Tim Nelson Architect, Ltd. ©2020

Project No. 20201
Drawn By: TN

Design: 4/22/20
Client Revisions: 8/6/20

Construction: 8/26/20
Village Revisions:

TIM NELSON ARCHITECT, LTD.
Custom Homes • Additions • Remodeling
421 James, Geneva, IL 60134
Tel (630) 597-5122 Fax (630) 252-1135
tim@timnelsonarchitect.com

AS-BUILT DRAWINGS OF:
NORTH AVENUE OFFICE PARK
1652 E. MAIN STREET
ST. CHARLES, ILLINOIS 60114

EXISTING LOWER LEVEL FLOOR PLAN