


POINT AT CASCADE
2287 & 2311 CASCADE RD
ATLANTA, GA 30311

Mark	Date	Description
	07.26.16	AS-BUILT

Project ID	1627
Drawn By	XLI
Checked By	LGE
Sheet Title	


FLOOR PLAN

Drawing No.
AB-2.1

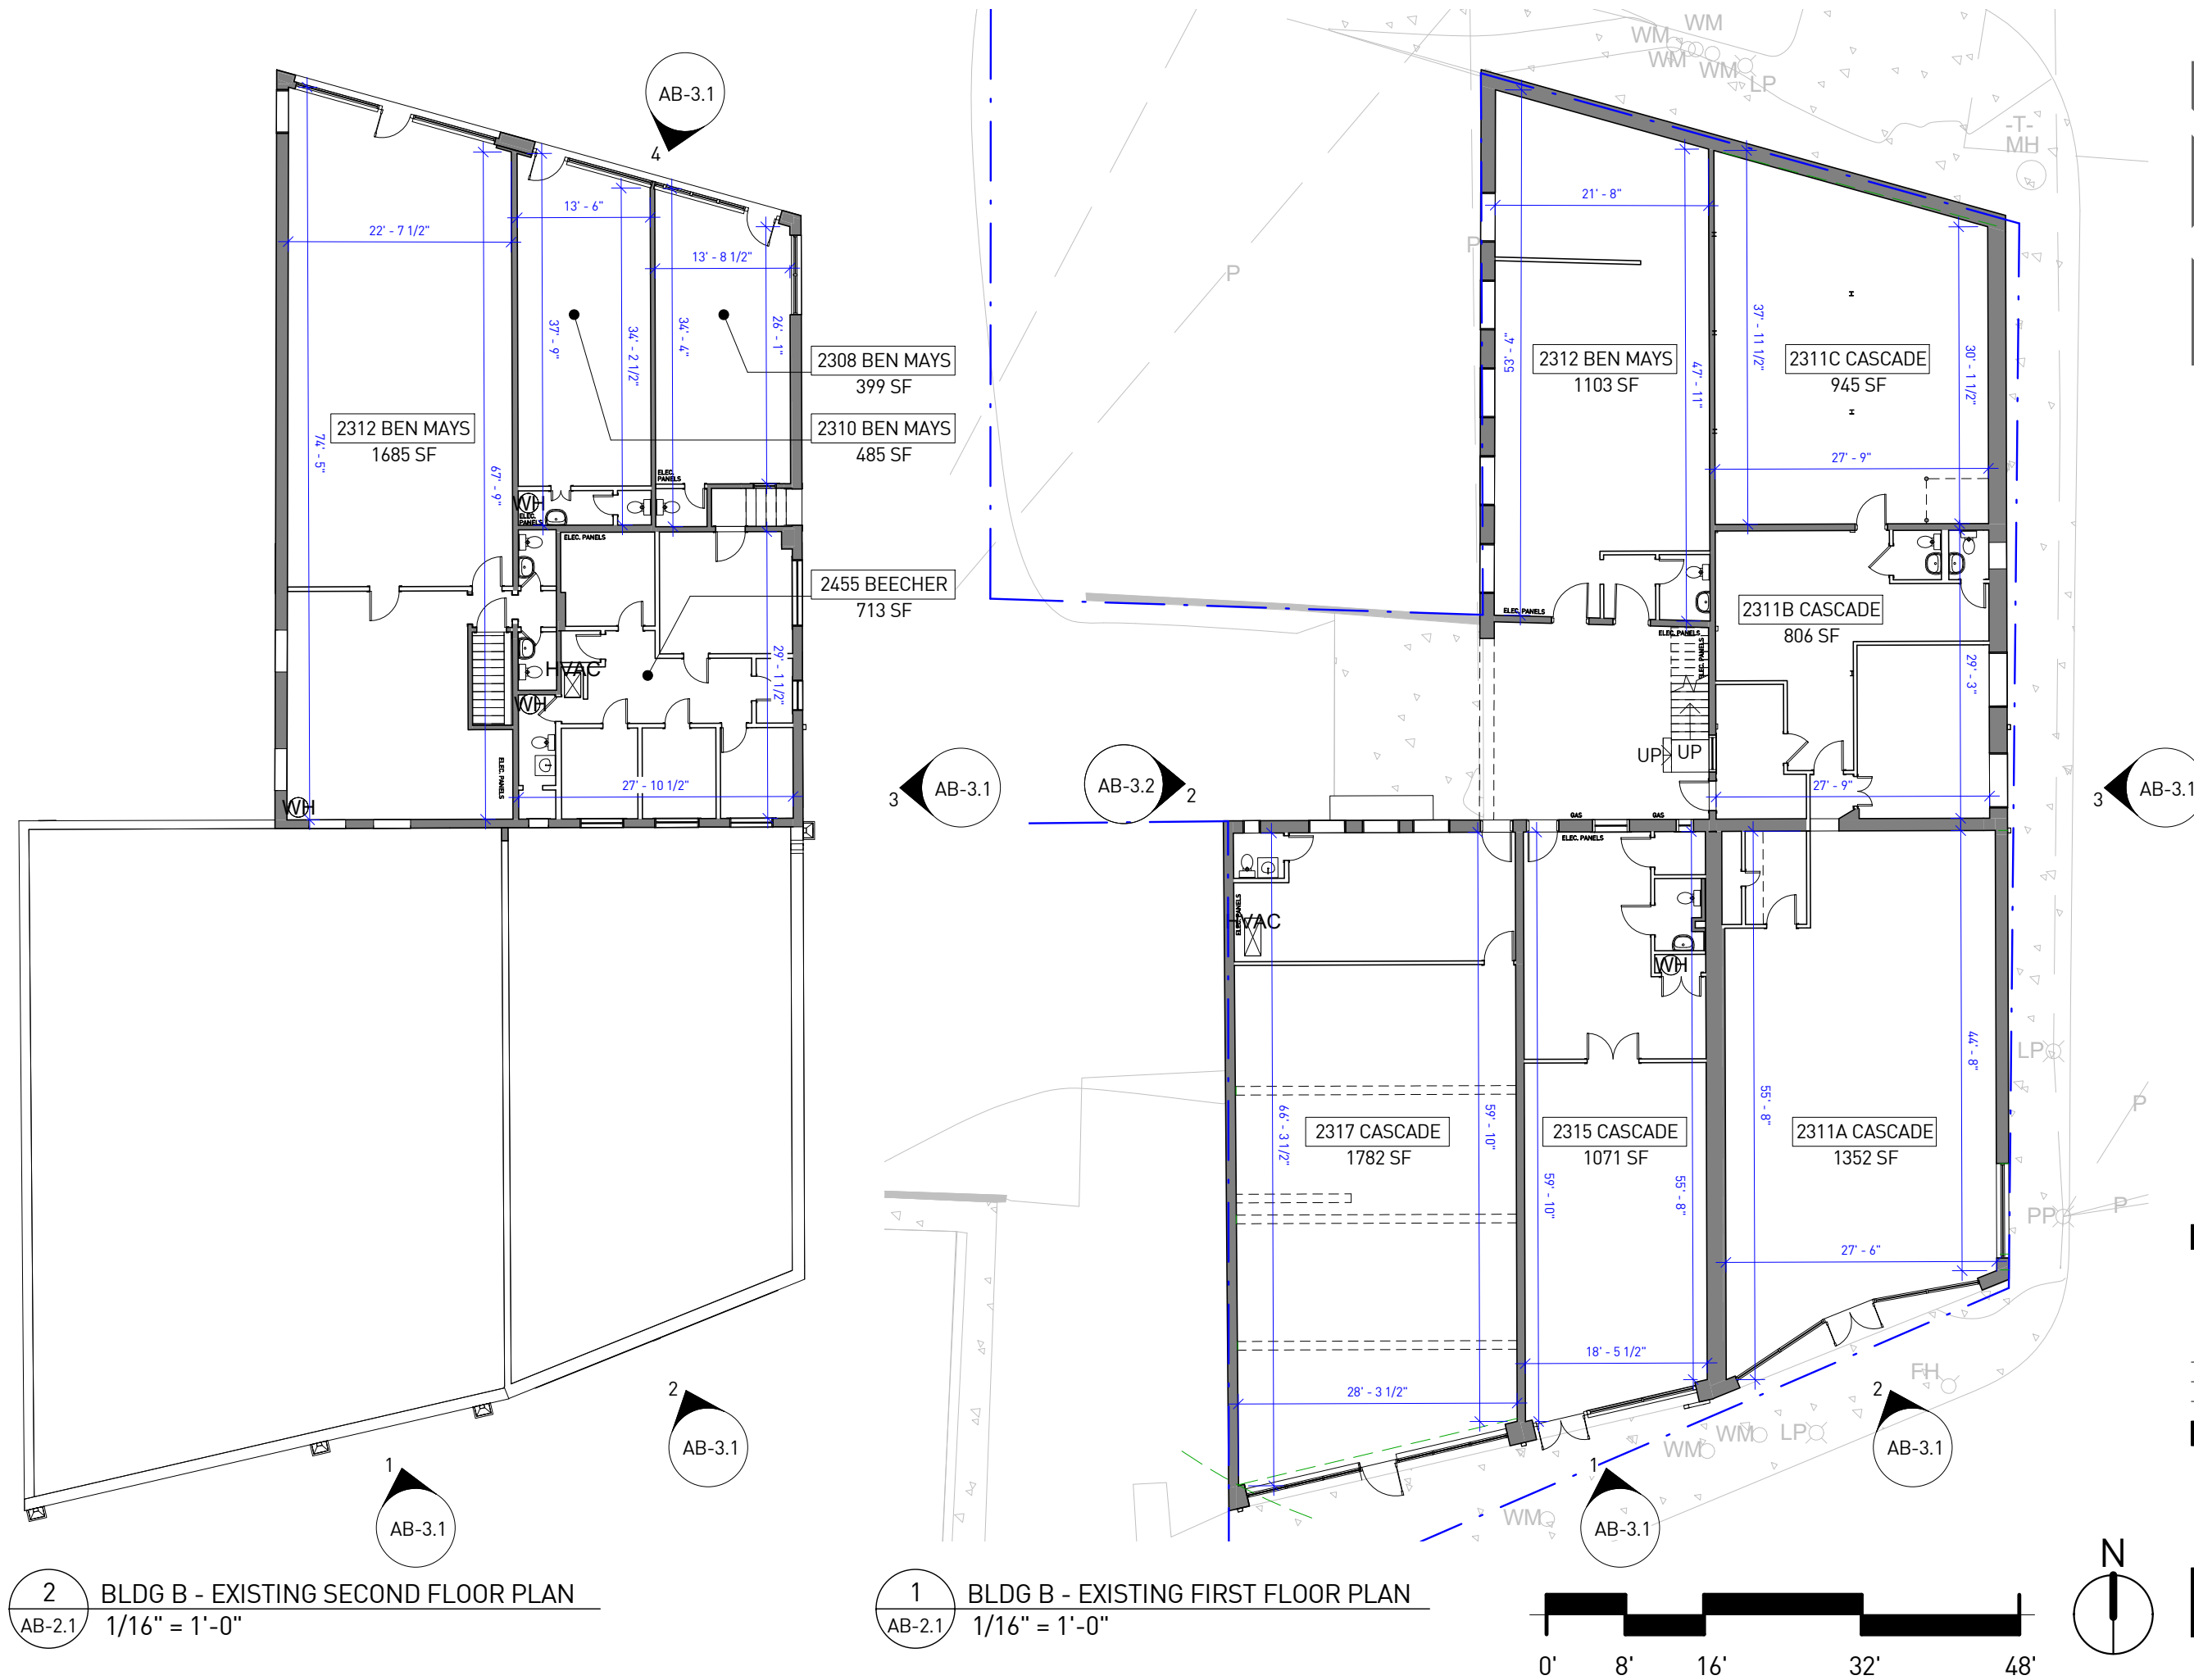

2 BLDG B - EXISTING SECOND FLOOR PLAN
AB-2.1 1/16" = 1'-0"


1 BLDG B - EXISTING FIRST FLOOR PLAN
AB-2.1 1/16" = 1'-0"

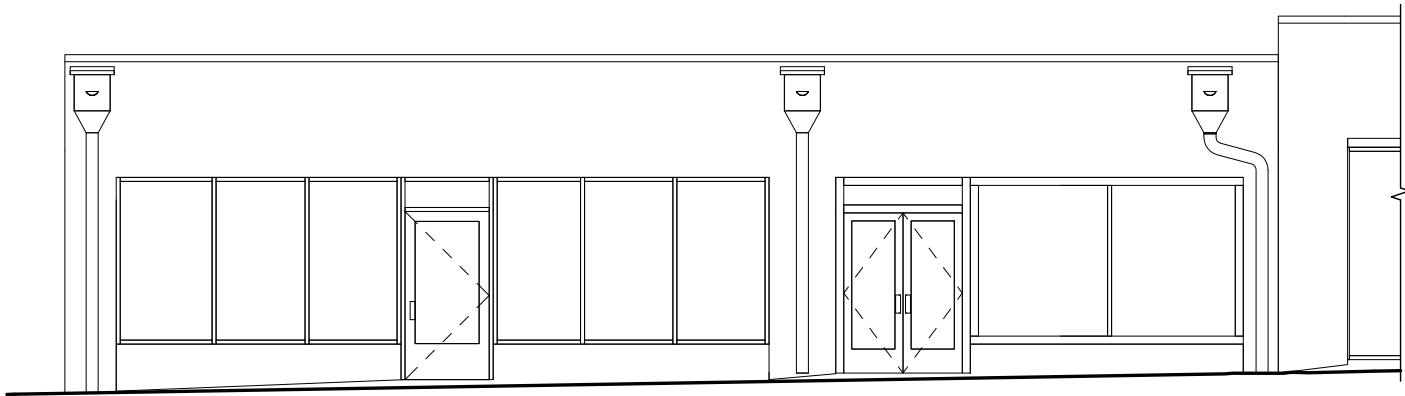

2317 CASCADE


2315 CASCADE

1
AB-3.1 ELEVATION @ 2317 & 2315 CASCADE
1/8" = 1'-0"

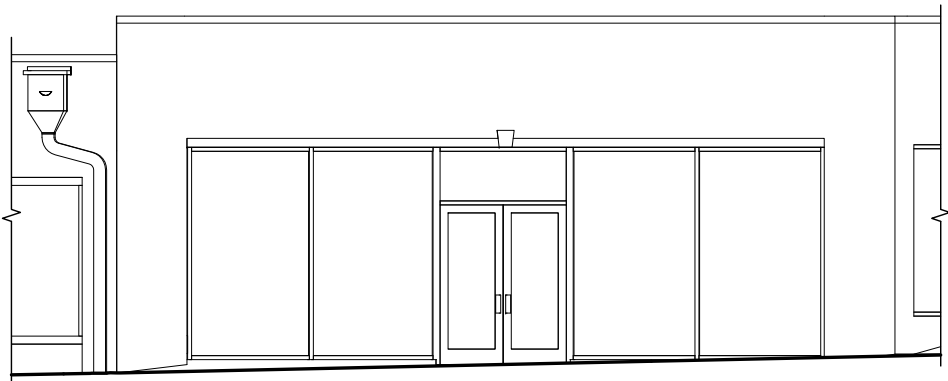

2311 CASCADE

2
AB-3.1 ELEVATION @ 2311 CASCADE
1/8" = 1'-0"

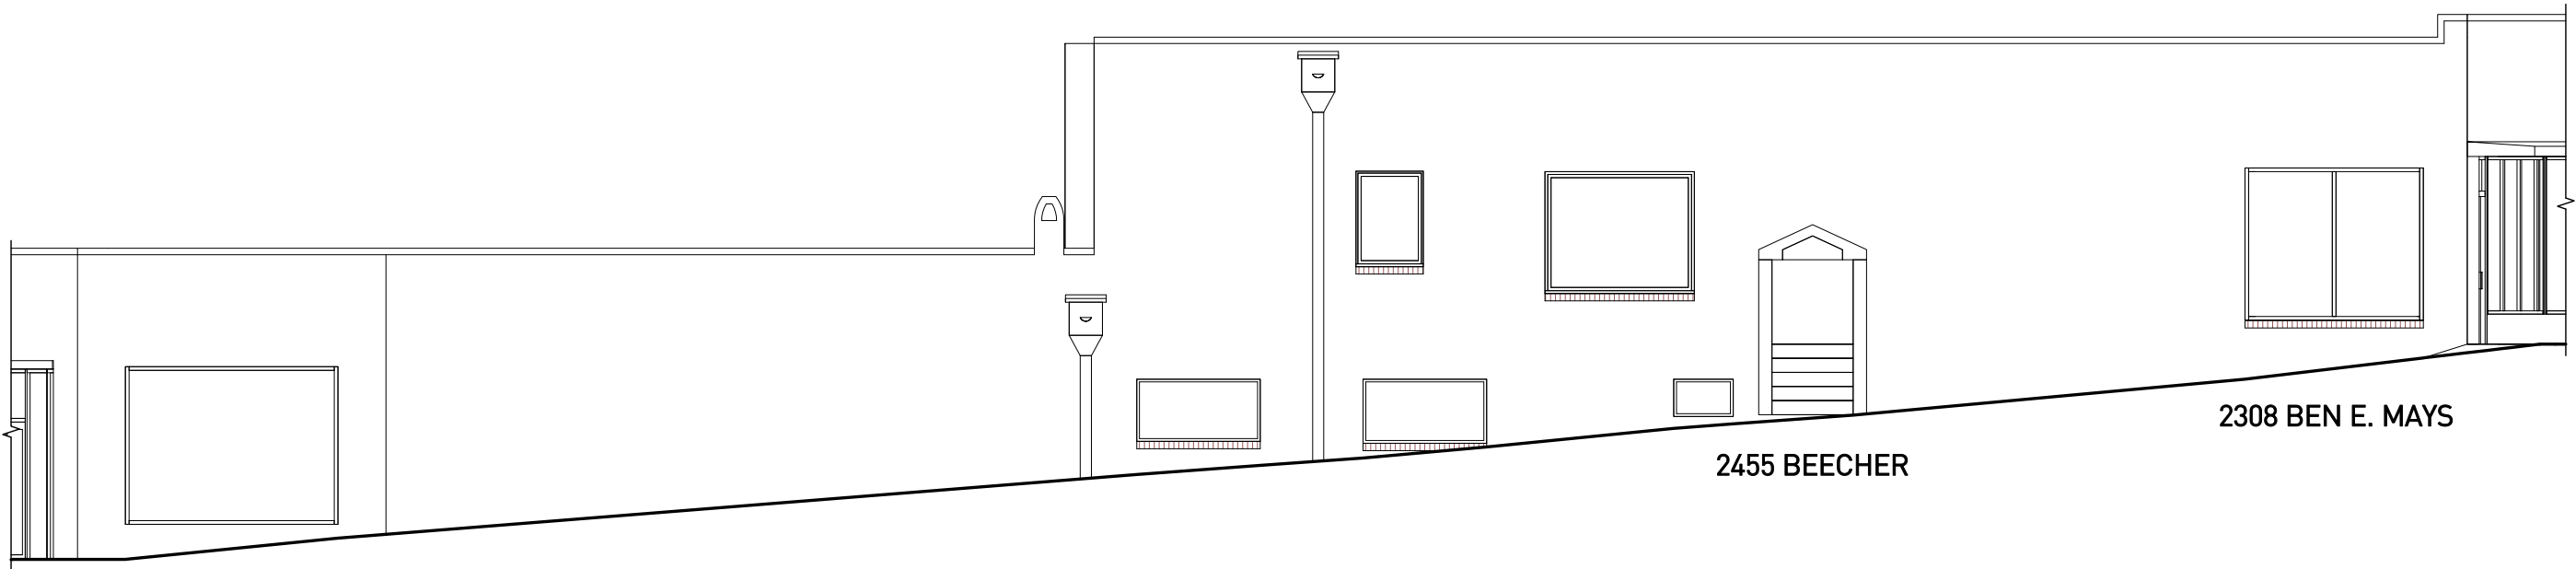

2311 CASCADE

2308 BEN E. MAYS

2455 BEECHER

3
AB-3.1 ELEVATION @ BEECHER
1/8" = 1'-0"



2308 BEN E. MAYS

2310 BEN E. MAYS


2312 BEN E. MAYS

4
AB-3.1 ELEVATION @ 2308-2312 BEN E. MAYS
1/8" = 1'-0"

POINT AT CASCADE
2287 & 2311 CASCADE RD
ATLANTA, GA 30311

Mark	Date	Description
	07.26.16	AS-BUILT
Project ID		1627
Drawn By		XLI
Checked By		LGE
Sheet Title		

ELEVATIONS

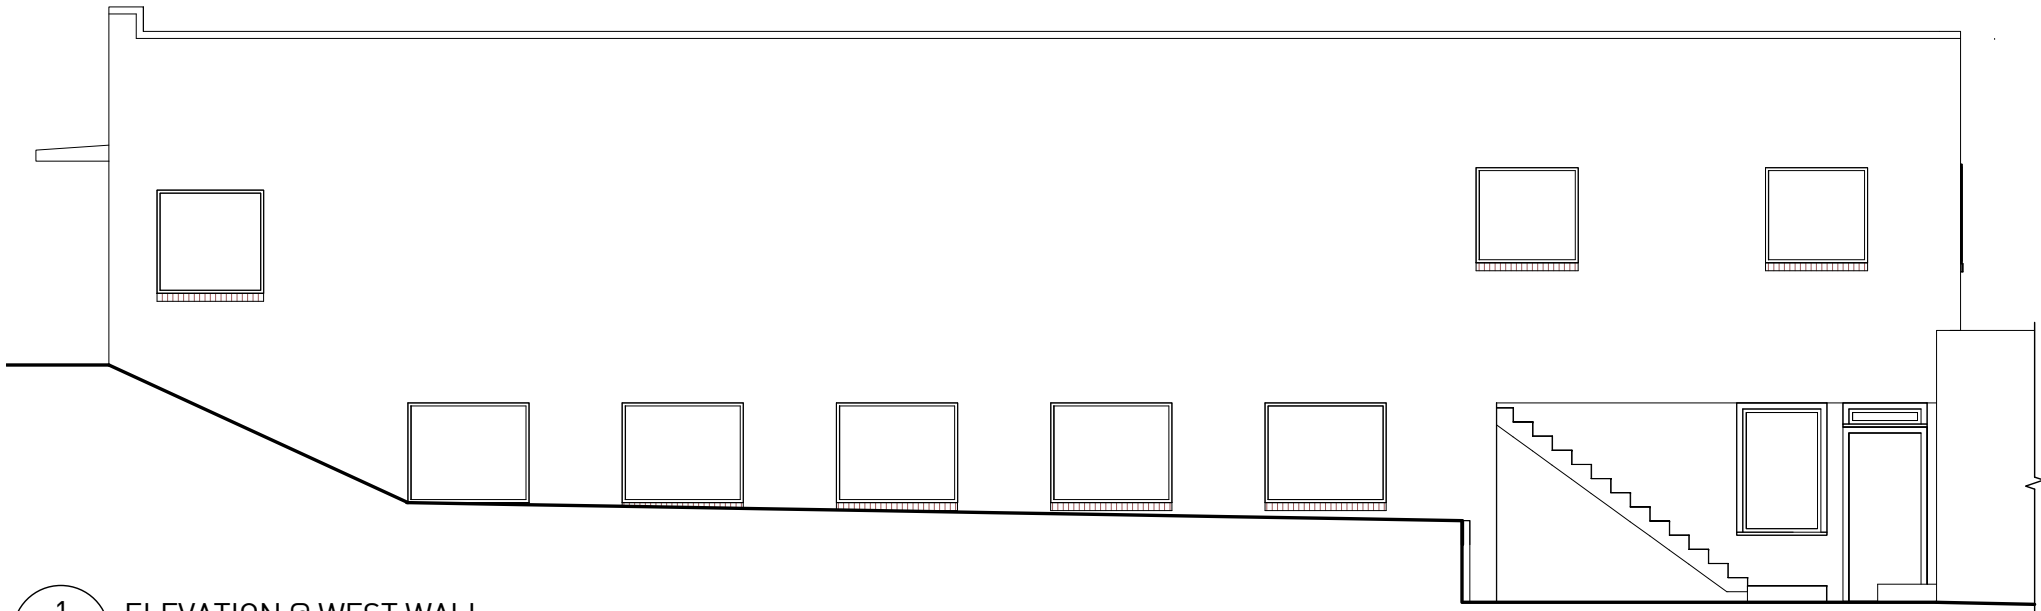

1

AB-3.2

ELEVATION @ WEST WALL

1/8" = 1'-0"



2

AB-3.2

ELEVATION @ WEST WALL

1/8" = 1'-0"

POINT AT CASCADE
2287 & 2311 CASCADE RD
ATLANTA, GA 30311

Mark	Date	Description
	07.26.16	AS-BUILT
Project ID		1627
Drawn By		XLI
Checked By		LGE
Sheet Title		

ELEVATIONS