




GENERAL NOTES

- [illegible]

SHEET NOTES

- | | |
|---|--|
| 1 | NEW STRUCTURAL COLUMN TO BE PAINTED - SEE STRUCTURAL |
| 2 | EXISTING STRUCTURAL COLUMN TO BE PAINTED |

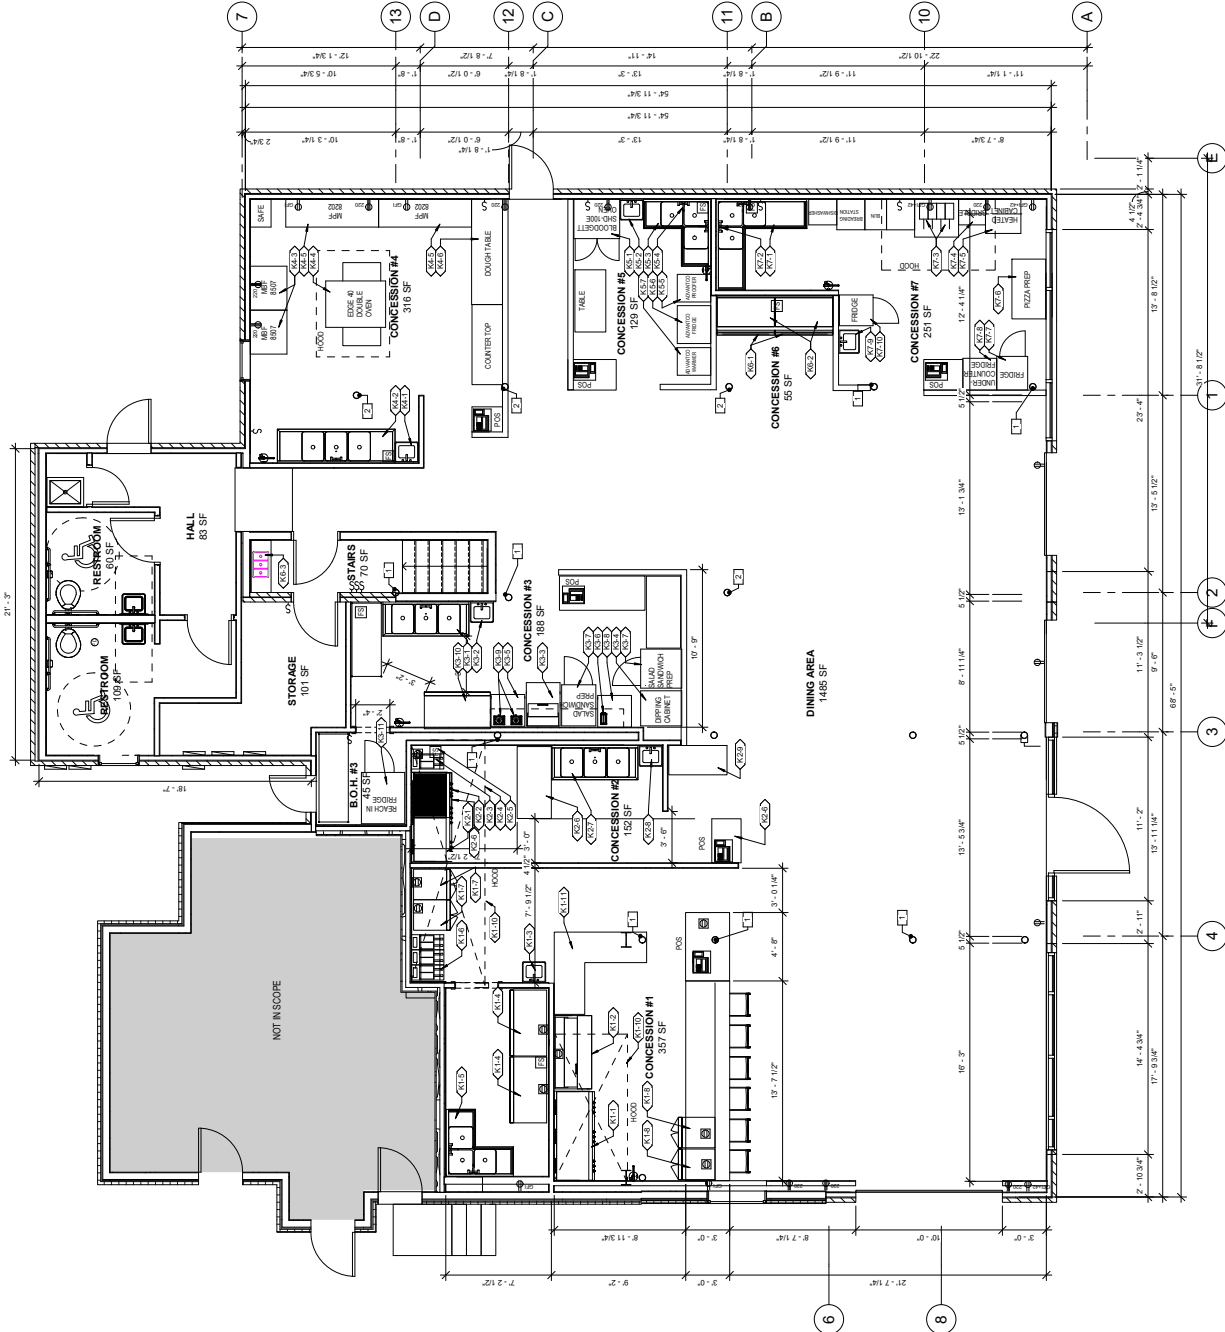

KITCHEN LAYOUT AS-BUILT
SCALE: 1/4" = 1'-0"
1