




580 Menlo Drive  
Rocklin, California 95765

ISSUED 10.15.25

SCALE 1/8" = 1'-0"

LEASE EXHIBIT

A

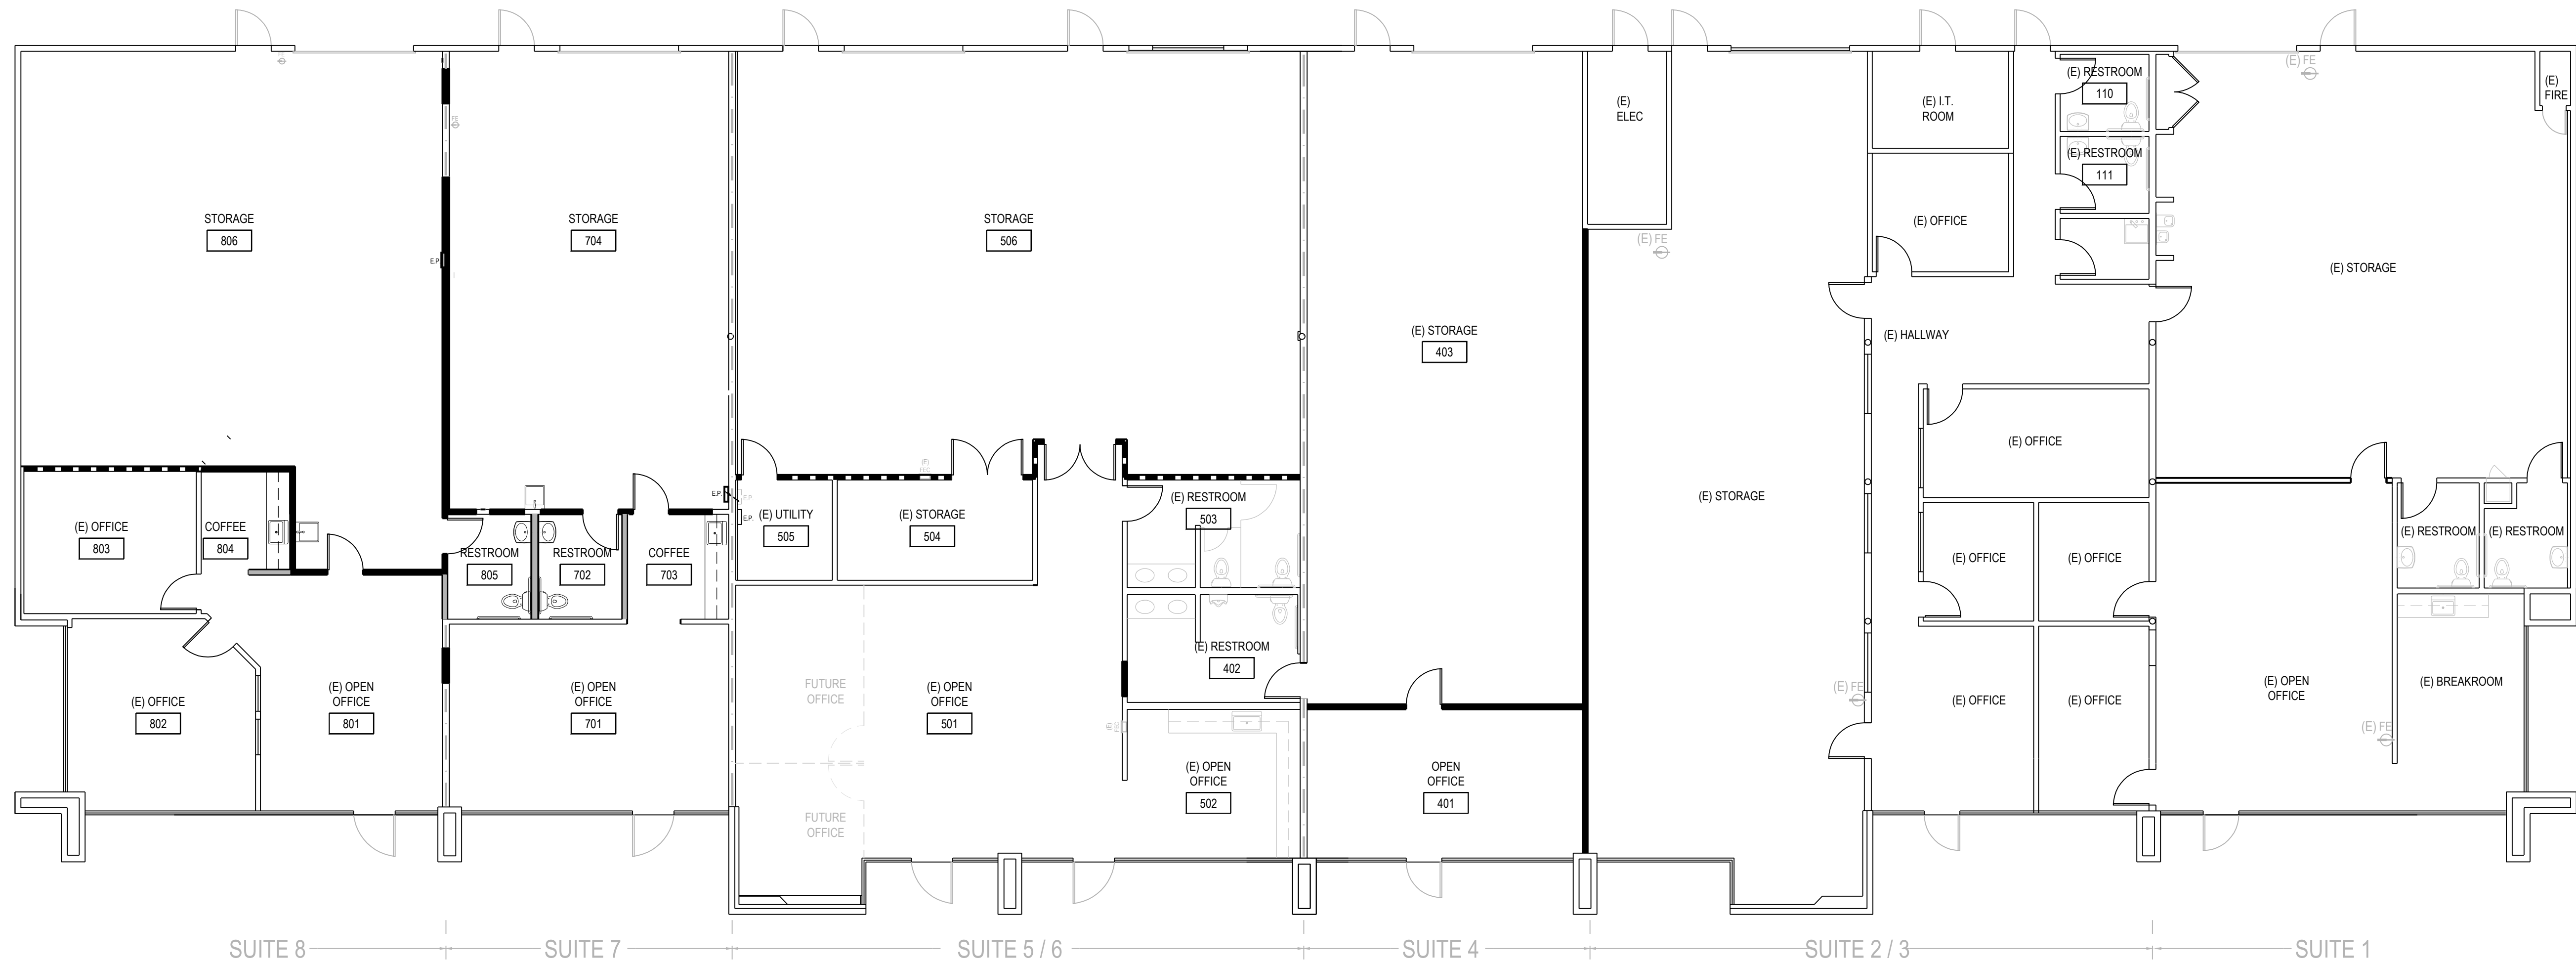

FLOOR PLAN

SCALE: 1/8" = 1'-0"

THESE RECORD DRAWINGS HAVE BEEN PREPARED BASED UPON INFORMATION SUBMITTED IN PART BY OTHERS. WHILE THIS INFORMATION IS BELIEVED TO BE RELIABLE, A1D IS NOT RESPONSIBLE FOR THE ACCURACY NOR FOR ERRORS OR OMISSIONS WHICH MAY HAVE BEEN INCORPORATED INTO THESE DOCUMENTS WHICH MAY HAVE BEEN INCORPORATED INTO THESE DOCUMENTS AS A RESULT. A1D EXPRESSLY RESERVES ITS COMMON LAW COPYRIGHT AND OTHER PROPERTY RIGHTS IN THESE PLANS. THESE PLANS ARE NOT TO BE REPRODUCED, CHANGED OR COPIED IN ANY FORM OR MANNER WITHOUT THE EXPRESSED WRITTEN CONSENT OF A1D.