

DATE ISSUED	5/2/2024		
#	DATE	REVISION	BY
1	07-05-24	PLAN CHECK	

CONCORDE ENTERPRISES
COLLABORATIVE DRAFTING CONSULTANT
 3895 CANNON DEL RIO SOUTH #432
 SAN DIEGO CA 92108
 PH: (619) 246-9574
 CONCORDECONSULT2@AOL.COM
 SERVING ALL OF CALIFORNIA




The contractor shall verify and be responsible for all dimensions and conditions on the job and this office must be notified in writing of any variation from the dimensions and conditions shown by these drawings.

PREPARED FOR:
 577 W LA CADENA DR RIVERSIDE CA 92501

SHEET TITLE
HOUSE DEMO PLAN

SCALE
 DRAWN BY HE-DM-GA
 CHECKED BY
 START DATE
 JOB NO.

SHEET NUMBER
A-4

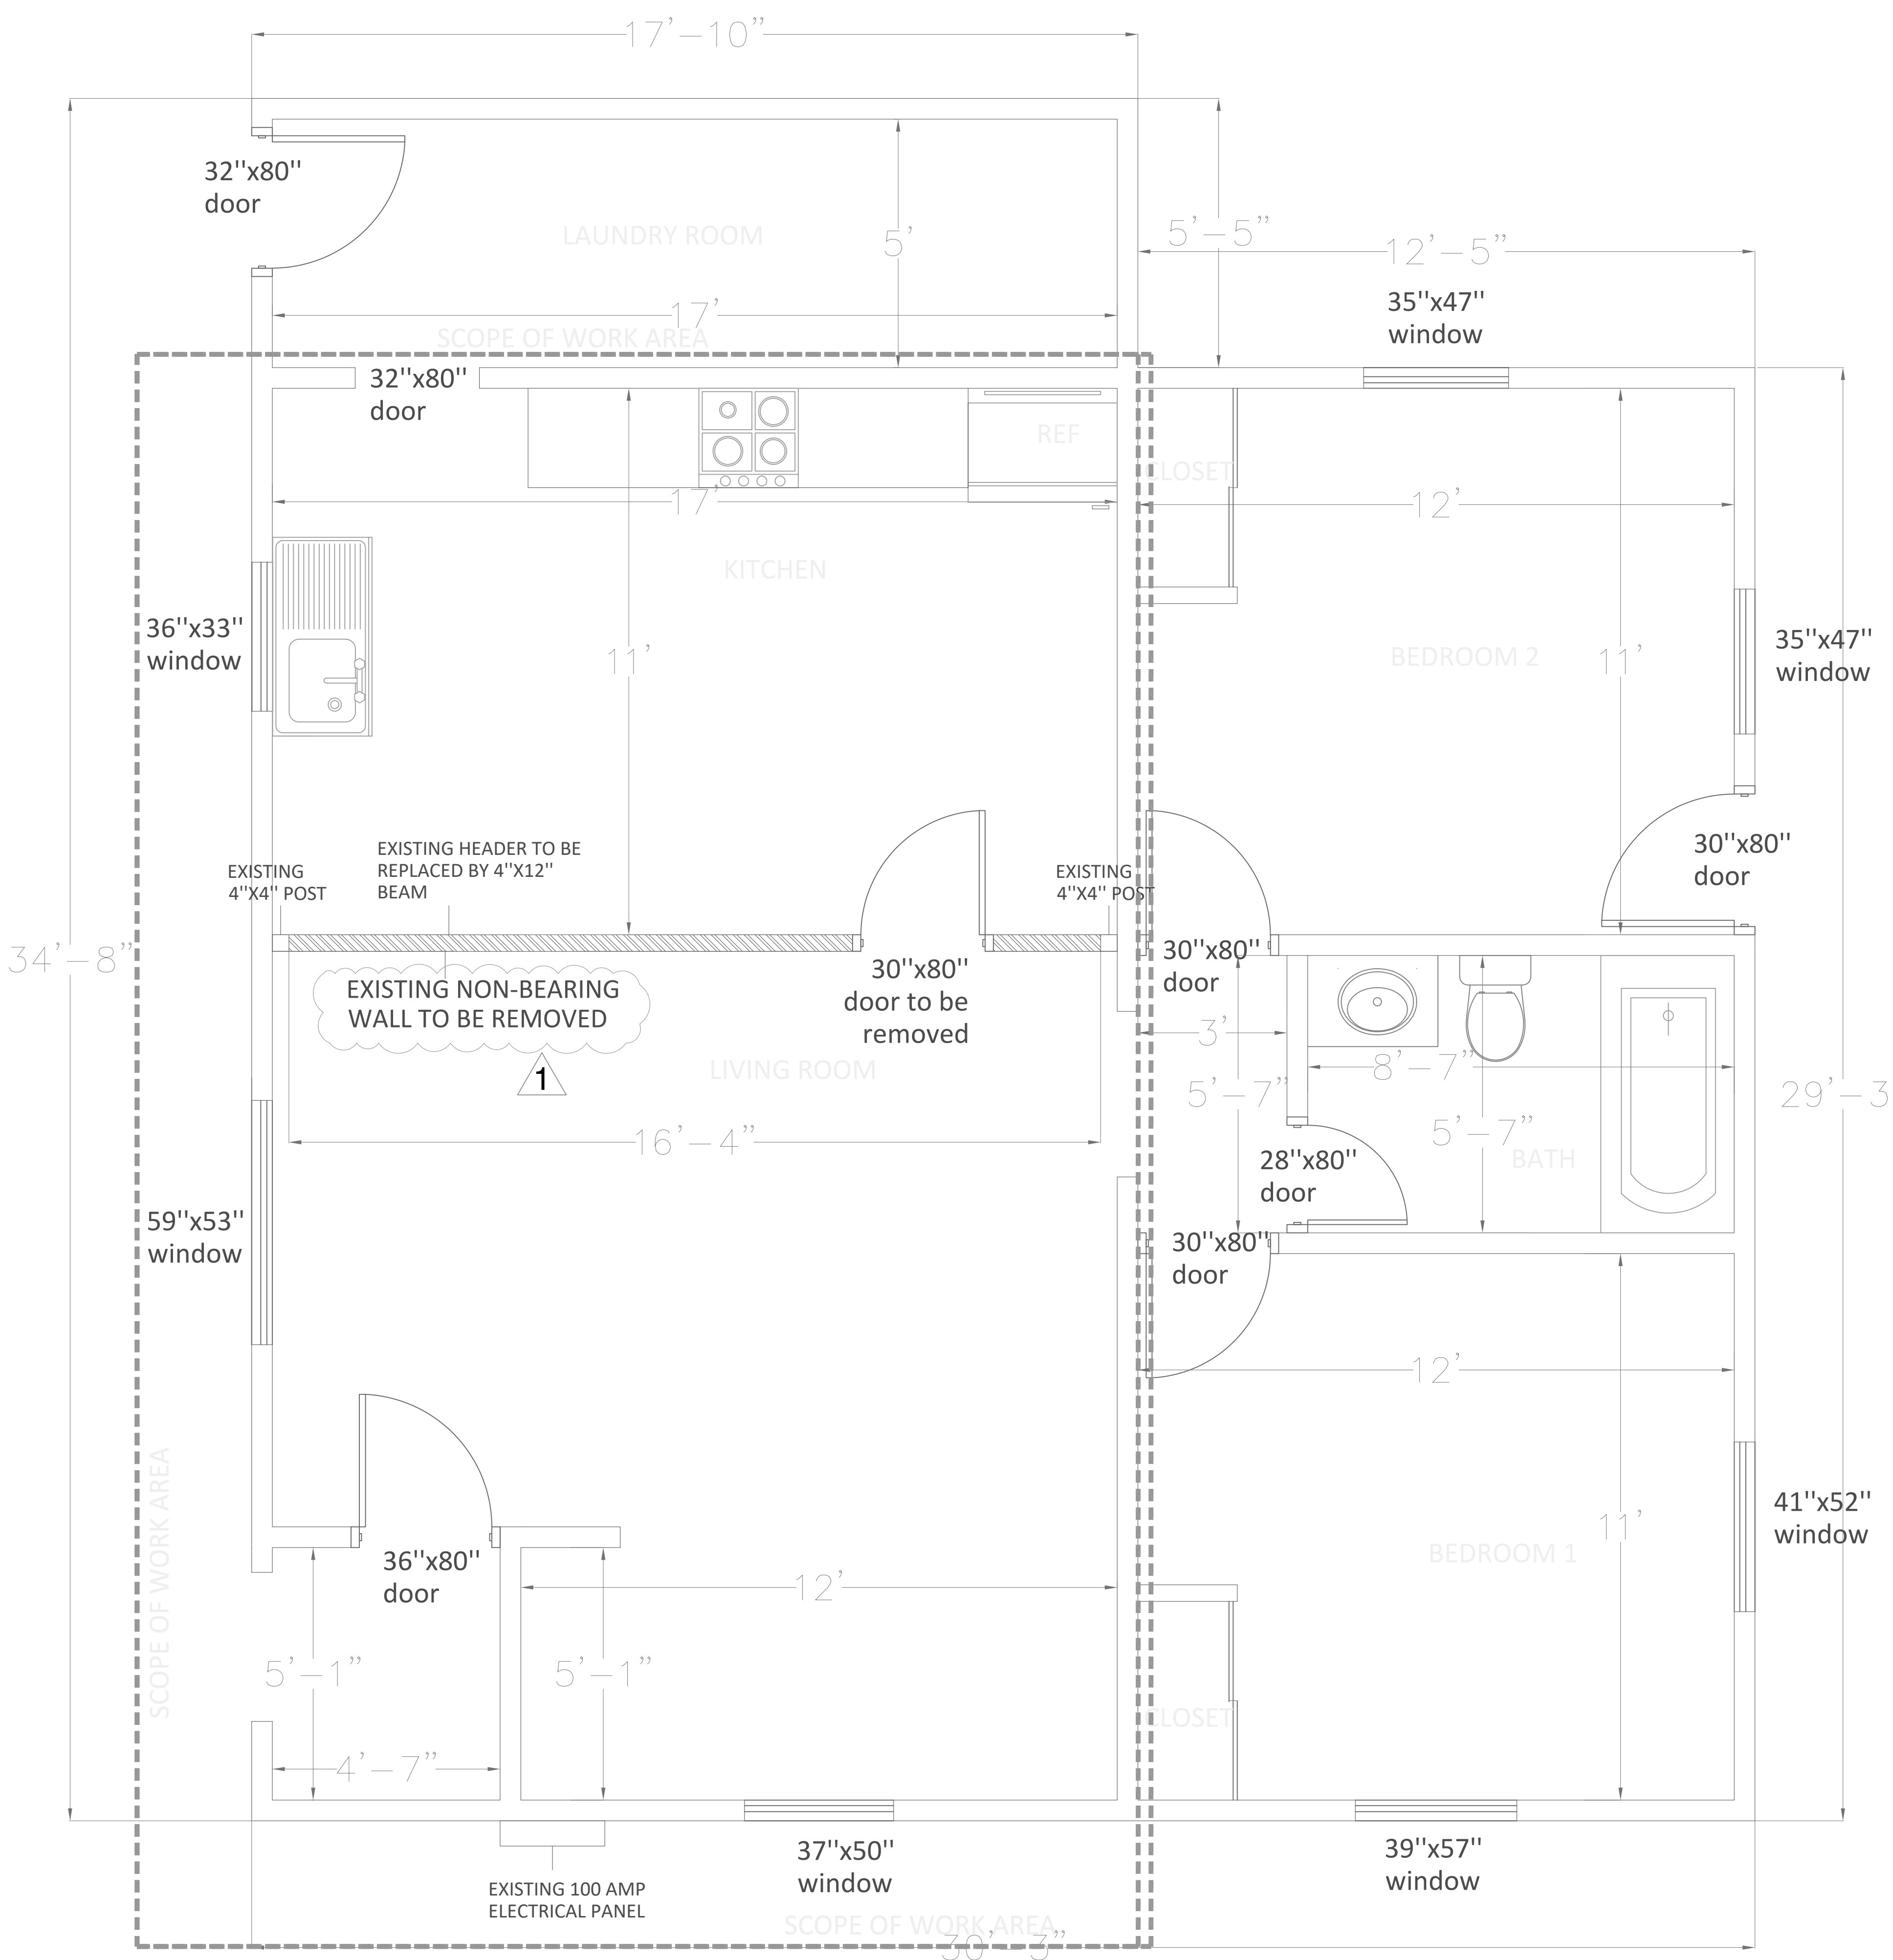

1 DEMO PLAN
SCALE 1/2"=1'0"

