


(E) GROUND LEVEL

SCALE: $\frac{3}{8}'' = 1'-0''$
 INDOOR FLOOR AREA = 3,364.00 sq.ft.
 OUTDOOR PATIO FLOOR AREA = 910.00 sq.ft.

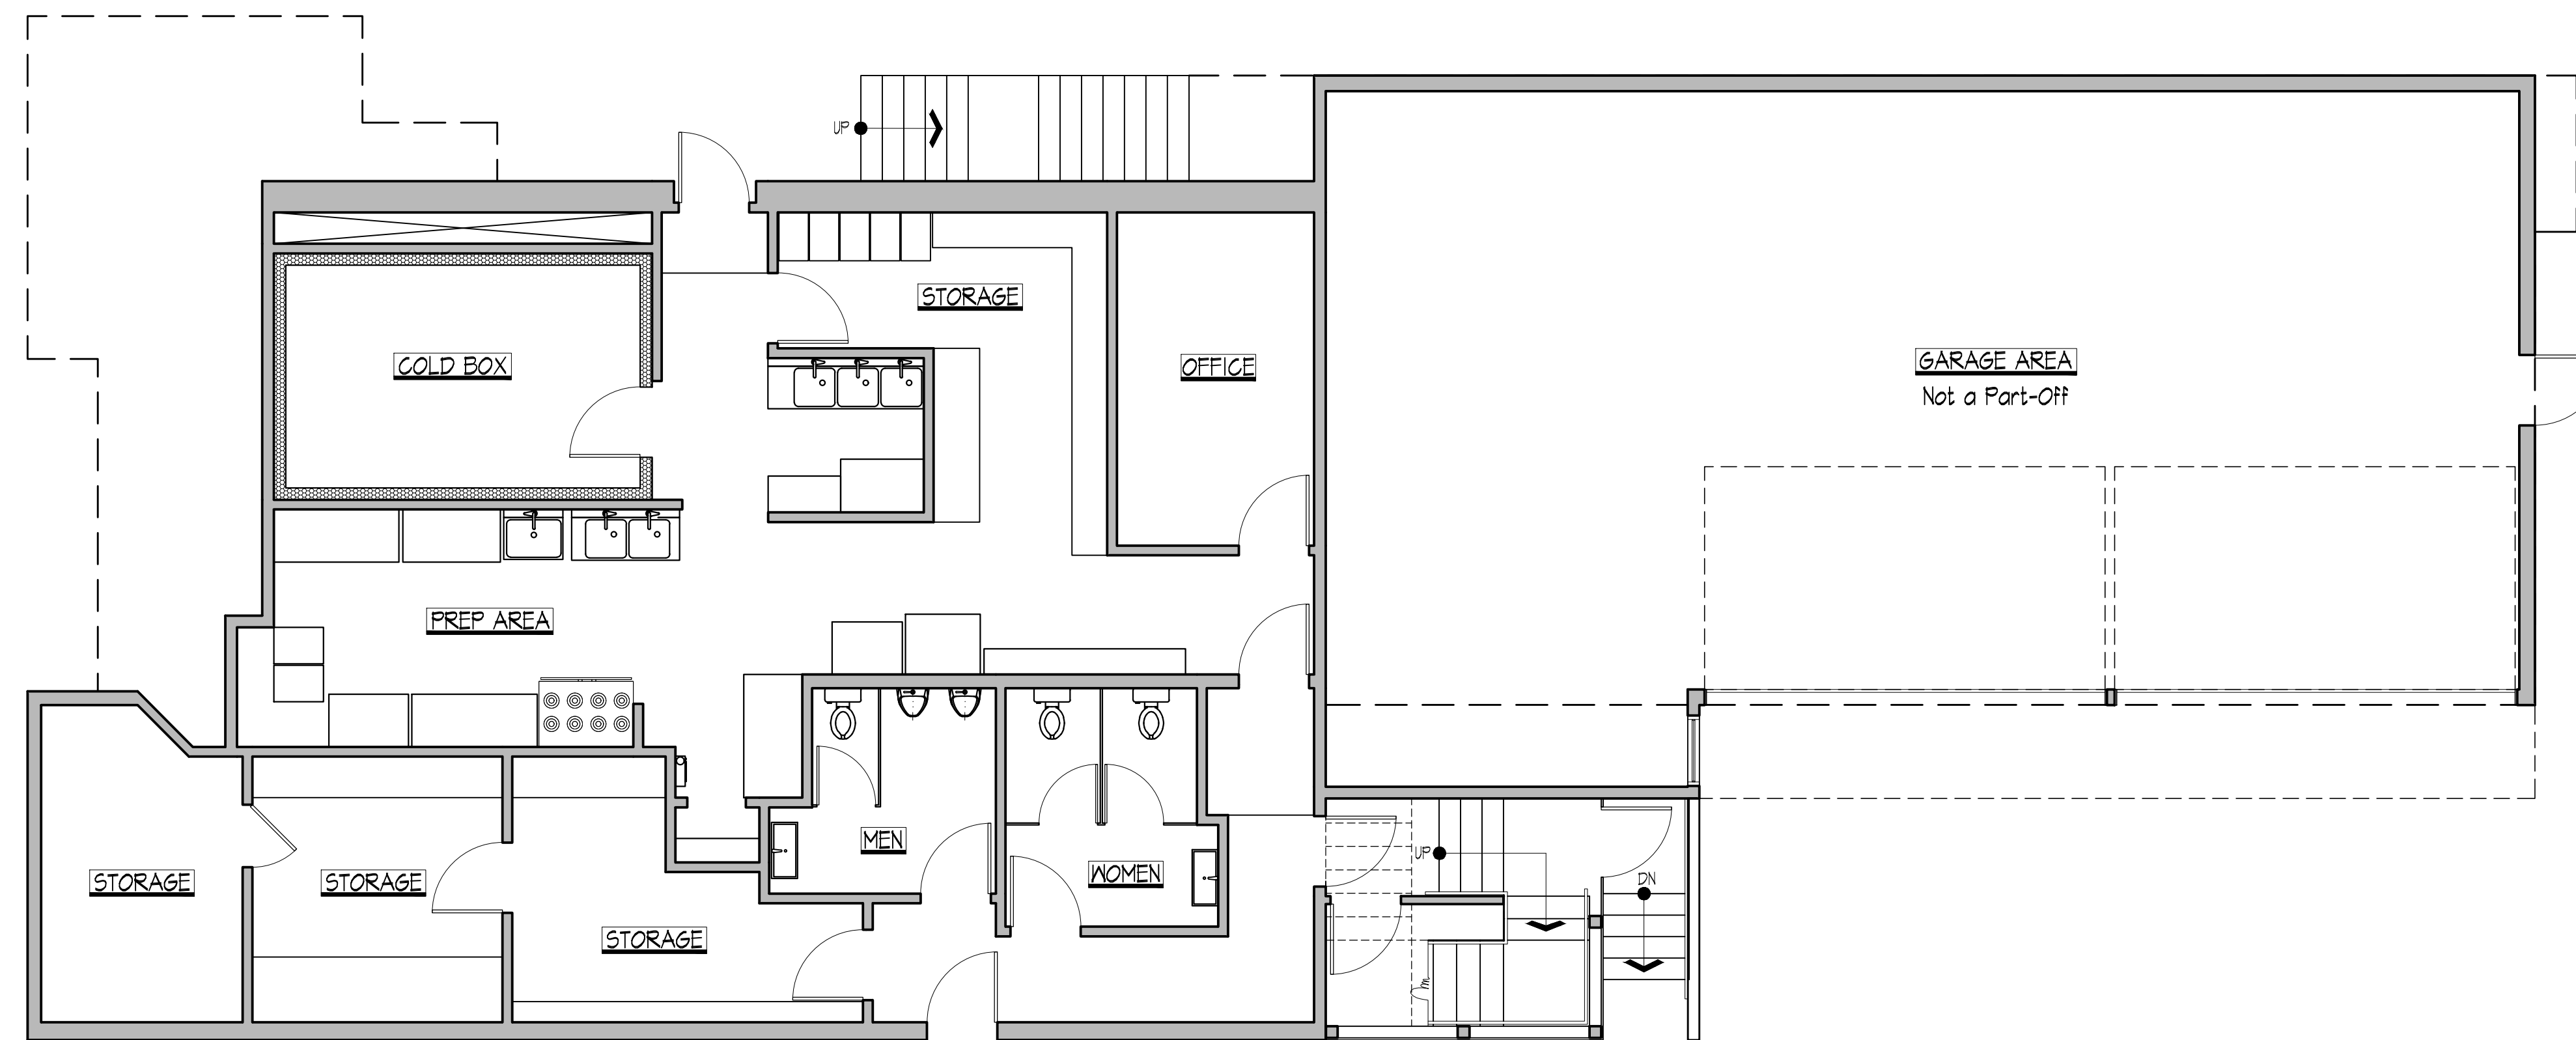

BASEMENT LEVEL

SCALE: $\frac{3}{8}'' = 1'-0''$
 INDOOR FLOOR AREA = 1,628.00 sq.ft.



E.B.E. associates, inc.

PLANNING . ARCHITECTURAL DESIGN . EXPEDITING
 3125 N. ANDRITA STREET
 GLASSSELL PARK, CA 90065
 (323) 550-8335 (323) 550-8337
 ebe@ebeassociates.com

OWNER:
DAVID SHANE ENTERPRISES, LLC
 8737 HOLLOWAY DRIVE
 WEST HOLLYWOOD, CA 90069
 310.666.7266

PROJECT:
**AS BUILT FLOOR PLANS
 OF (E) COMMERCIAL BUILDING**
 8752 SUNSET BLVD.
 WEST HOLLYWOOD, CA 90069

MARK	DATE	DESCRIPTION
1		
2		
3		
4		
5		

AS BUILT FLOOR PLANS
 PROJECT NUMBER: 24-3594DSE
 DRAWN BY: EDEL G. VERA
 DATE: 07/25/2024
 ALL RIGHTS RESERVED. NOT PART OF THESE DOCUMENTS
 MAY BE REPRODUCED OR UTILIZED IN ANY FORM WITHOUT
 THE PRIOR WRITTEN AUTHORIZATION OF E.B.E. ASSOC. INC.
 SHEET NUMBER
A-1.0

I HEREBY CERTIFY THAT THESE CONSTRUCTION
 DOCUMENTS WERE PREPARED BY ME, OR UNDER
 MY SUPERVISION.
 EDEL VERA - DESIGNER
 B-72460

THE DRAWINGS, SPECIFICATIONS, IDEAS AND ARRANGEMENTS ARE AND SHALL REMAIN PROPERTY OF E.B.E. ASSOCIATES, INC. NO PART THEREOF SHALL BE COPIED OR USED IN CONNECTION WITH ANY PROJECT OTHER THAN THE SPECIFIC ONE FOR WHICH THEY HAVE BEEN PREPARED WITHOUT THE COMPANY'S WRITTEN CONSENT. VISUAL CONTACT WITH THESE DRAWINGS OR SPECIFICATIONS SHALL CONSTITUTE EVIDENCE OF ACCEPTANCE OF THESE RESTRICTIONS.