

3148 EL CAMINO REAL

SANTA CLARA, CA 95051

STE 203

2,096 SQFT

AX-12


CORR: 148 SF

SUITE 203A: 457 SF

SUITE 203B: 705 SF

SUITE 203C: 499 SF

SUITE 203D: 287 SF

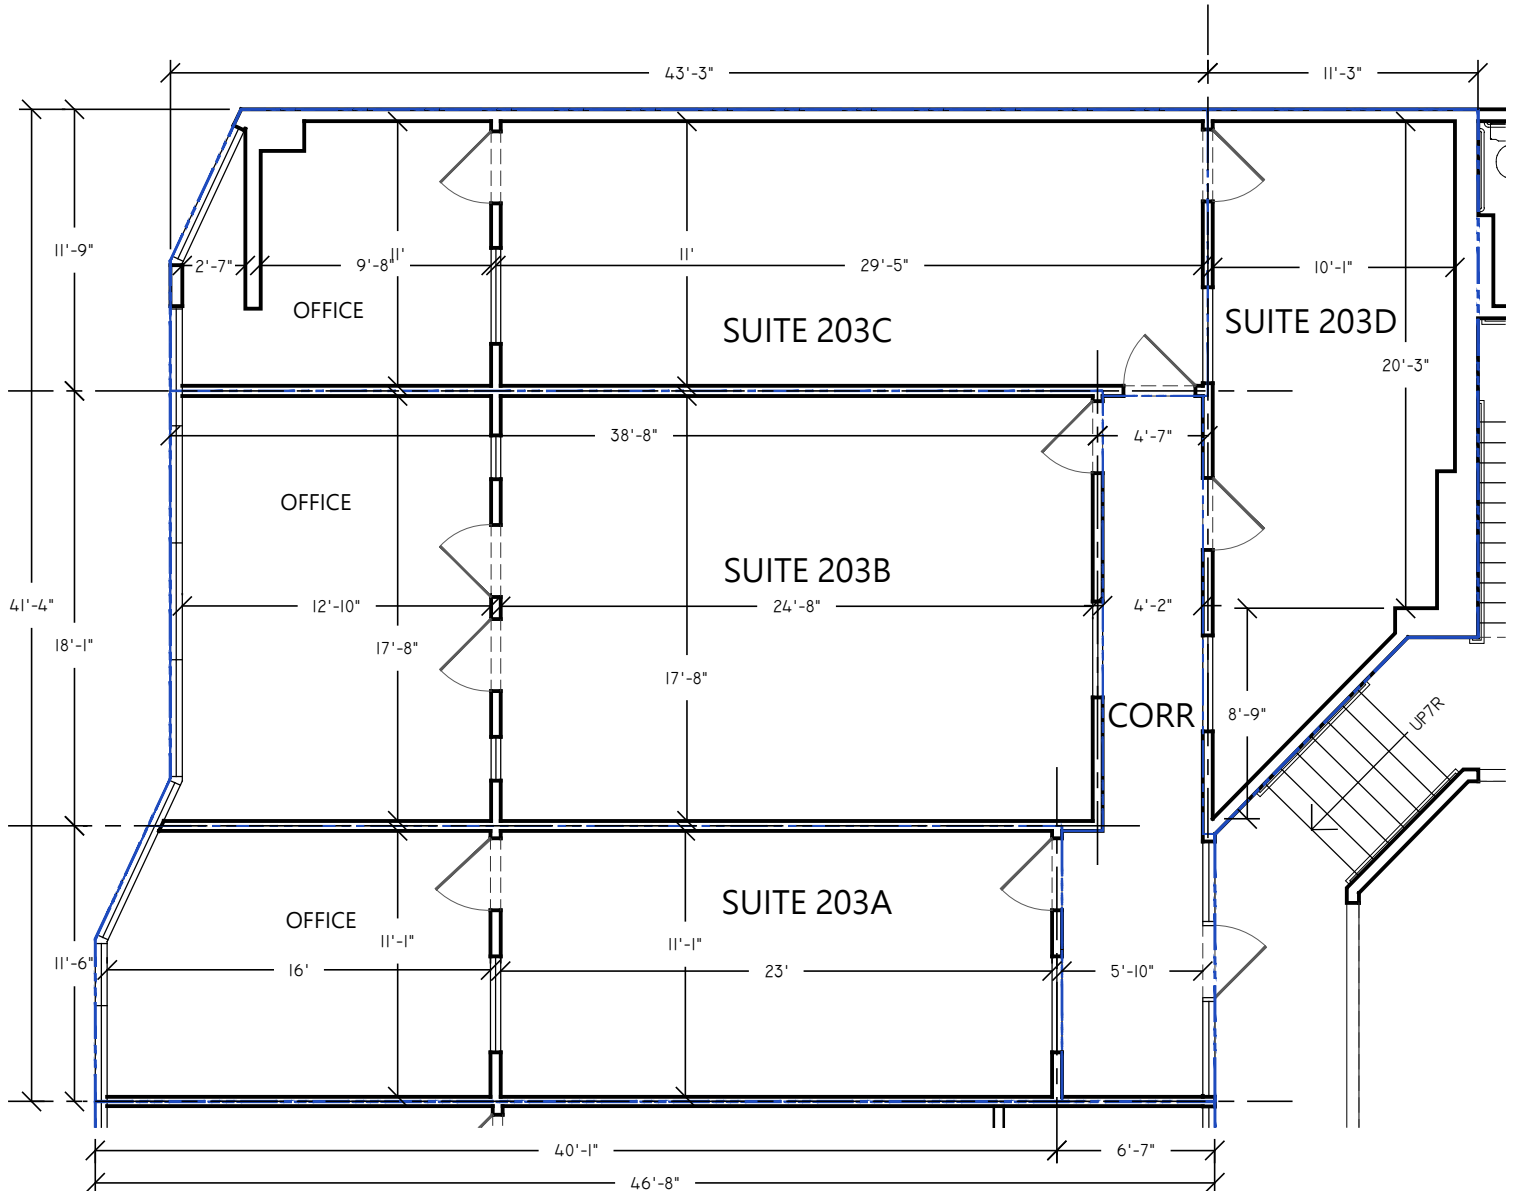

THIS DRAWING IS A RECORD OF REAL PROPERTY THAT IS GENERALLY ACCEPTED TO BE SUITABLE FOR USE IN PLANNING, DESIGN, LEASE, AND GENERAL ASSET MANAGEMENT. IT SHOULD NOT BE USED TO DETERMINE EXACT MEASUREMENTS OF SPACES OR ARTIFACTS FOUND HEREIN FOR ANY PURPOSE.


EXTERIOR ELEMENTS HAVE BEEN MEASURED AND DRAFTED FOR REFERENCE ONLY - THIS IS NOT A SURVEY.

REF: 3148SF-1_SantaClara_OFC

REV: 0

DRAWN BY: CS

AUDITED BY: TL

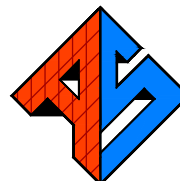FIELD MEASURE:
2/03/2025SCALE:
1/8"=1'-0"**ASBUILT
SERVICES**

FOR THE RECORD SINCE 1990

1-800-318-0099 ASBUILTSERVICES.COM