



AS-BUILT DRAWING OF SEWAGE DISPOSAL SYSTEM

7102 W. Okanogan Pl.
Kennewick, WA 99336
Phone: (509) 460-4205

BENTON-FRANKLIN HEALTH DISTRICT ENVIRONMENTAL HEALTH DIVISION

310 7th Avenue
Prosser, WA 99350
Phone: (509) 786-1633

JURISDICTION: Franklin PERMIT #: 20828 DATE OF INSTALLATION: 12/14/11
TYPE OF SYSTEM: Conventional Gravity Flow TREATMENT STANDARD: Level E TYPE OF PERMIT: Repair
TYPE OF STRUCTURE: Residential DESIGN CAPACITY: 4 BEDROOMS Gpd
Building sewer connected to sewage system at the time of inspection: Yes


PARCEL ID: 118-571-056


LEGAL DESCRIPTION OF PROPERTY: W 184.5' of E 532.93' of S 425' of N2SE4NWN4 22-9-29

PROPERTY ADDRESS: 6109 W Richardson Road, Pasco

Permittee: John & Catherine Franklin

Installer: C & E Trenching

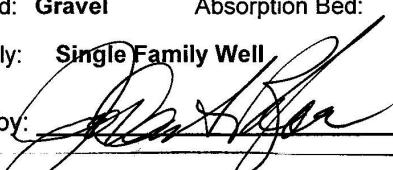Septic Tank: 1000 Gal. Type: Concrete Depth: 19" GPS Coordinates: N46.25097° W119.17088°
Pump Chamber: n/a Dose Volume: n/a Pump Make and Model: n/a
D-Box: depth to access: Drainfield: 660 sq. ft. Depth to Top of Field: 24"
Type of Field: Gravel Absorption Bed: sq. ft. Other: sq. ft.
Water Supply: Single Family Well GPS Location if SFW: N46.25130° W119.17088°
Inspected by:  Date of Approval: 12/19/11

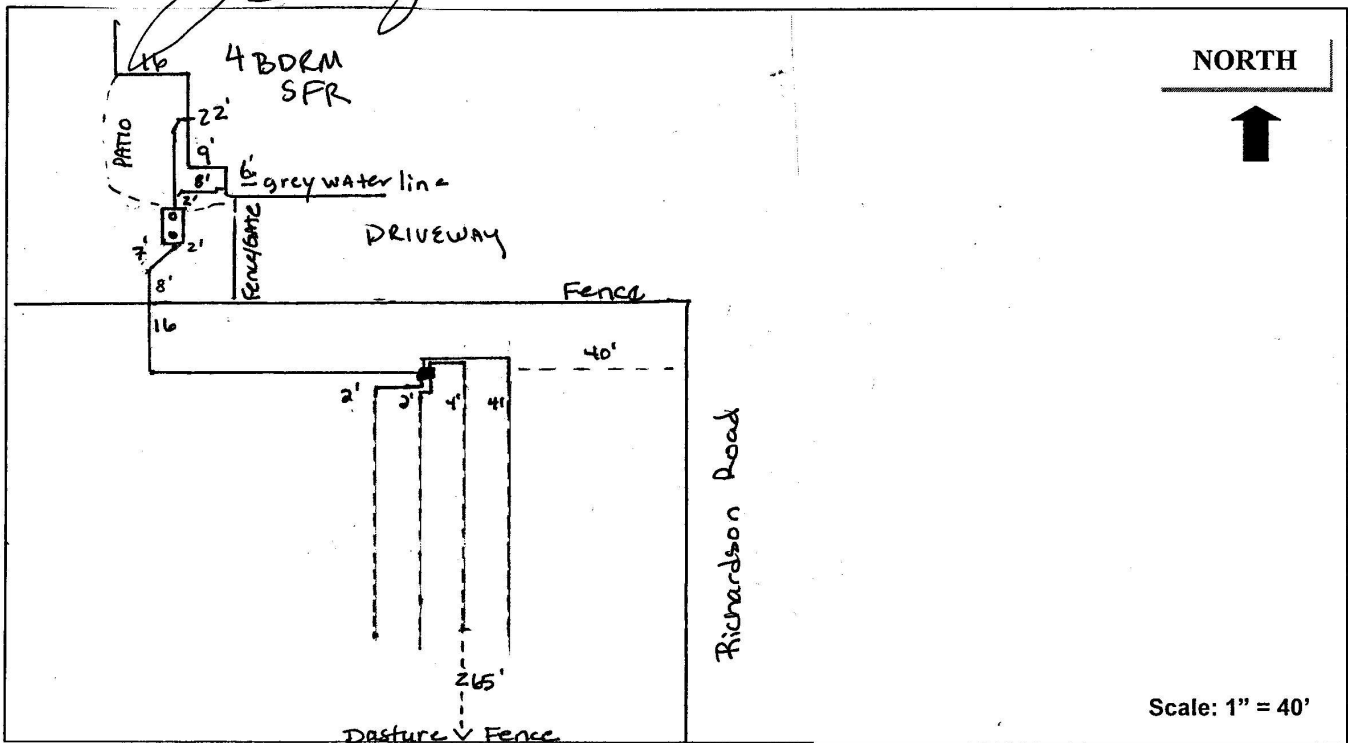

Copies to: John & Catherine Franklin; C & E Trenching; FCBD