


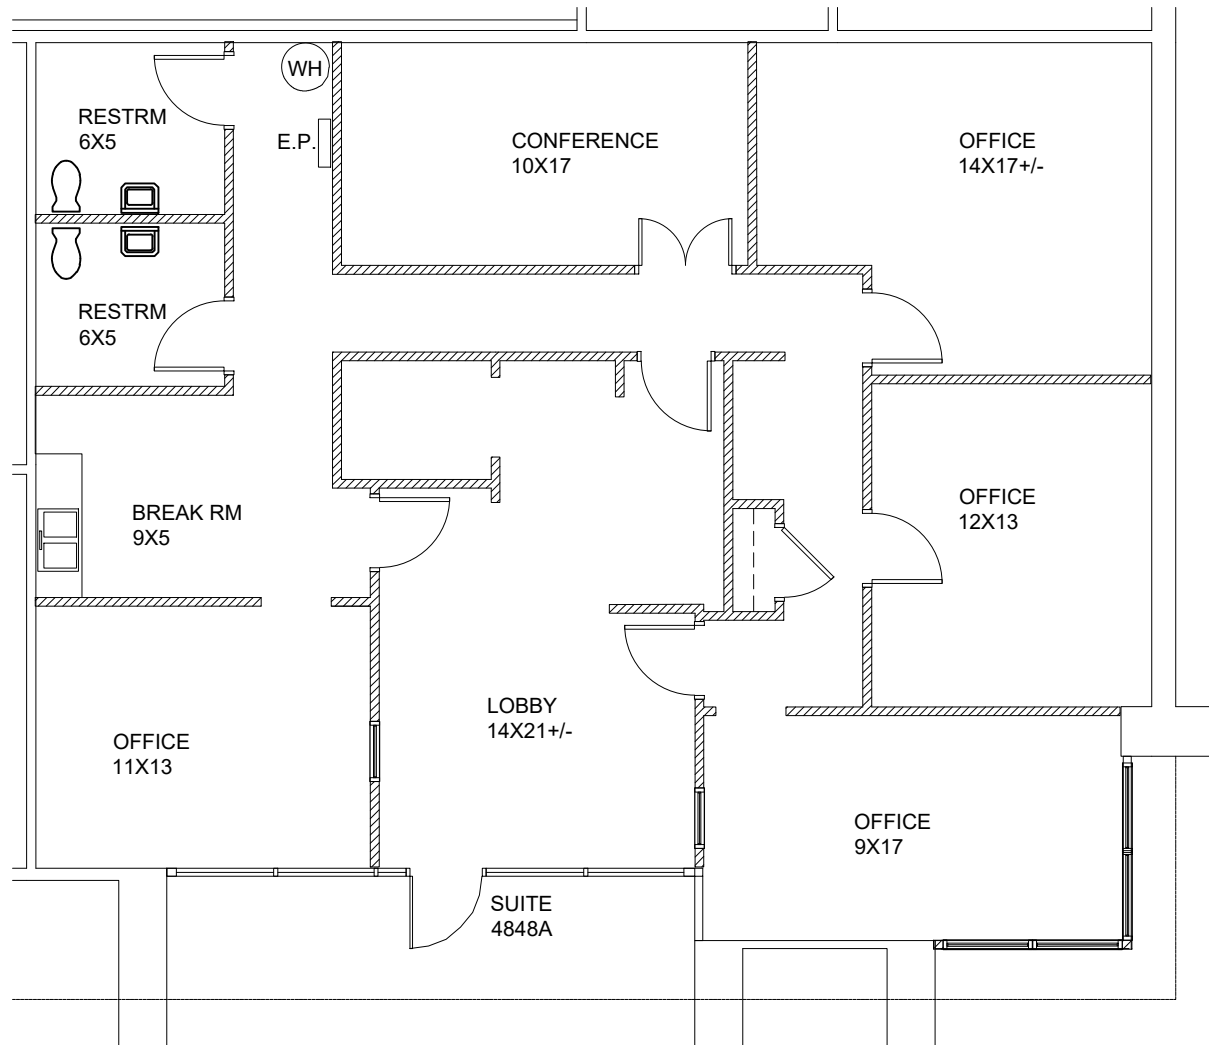

SCALE: N.T.S.

AS-BUILT PLAN SUITE 4848A
1,943 RSF

4848 OLD NATIONAL HWY
COLLEGE PARK, GA 30337