



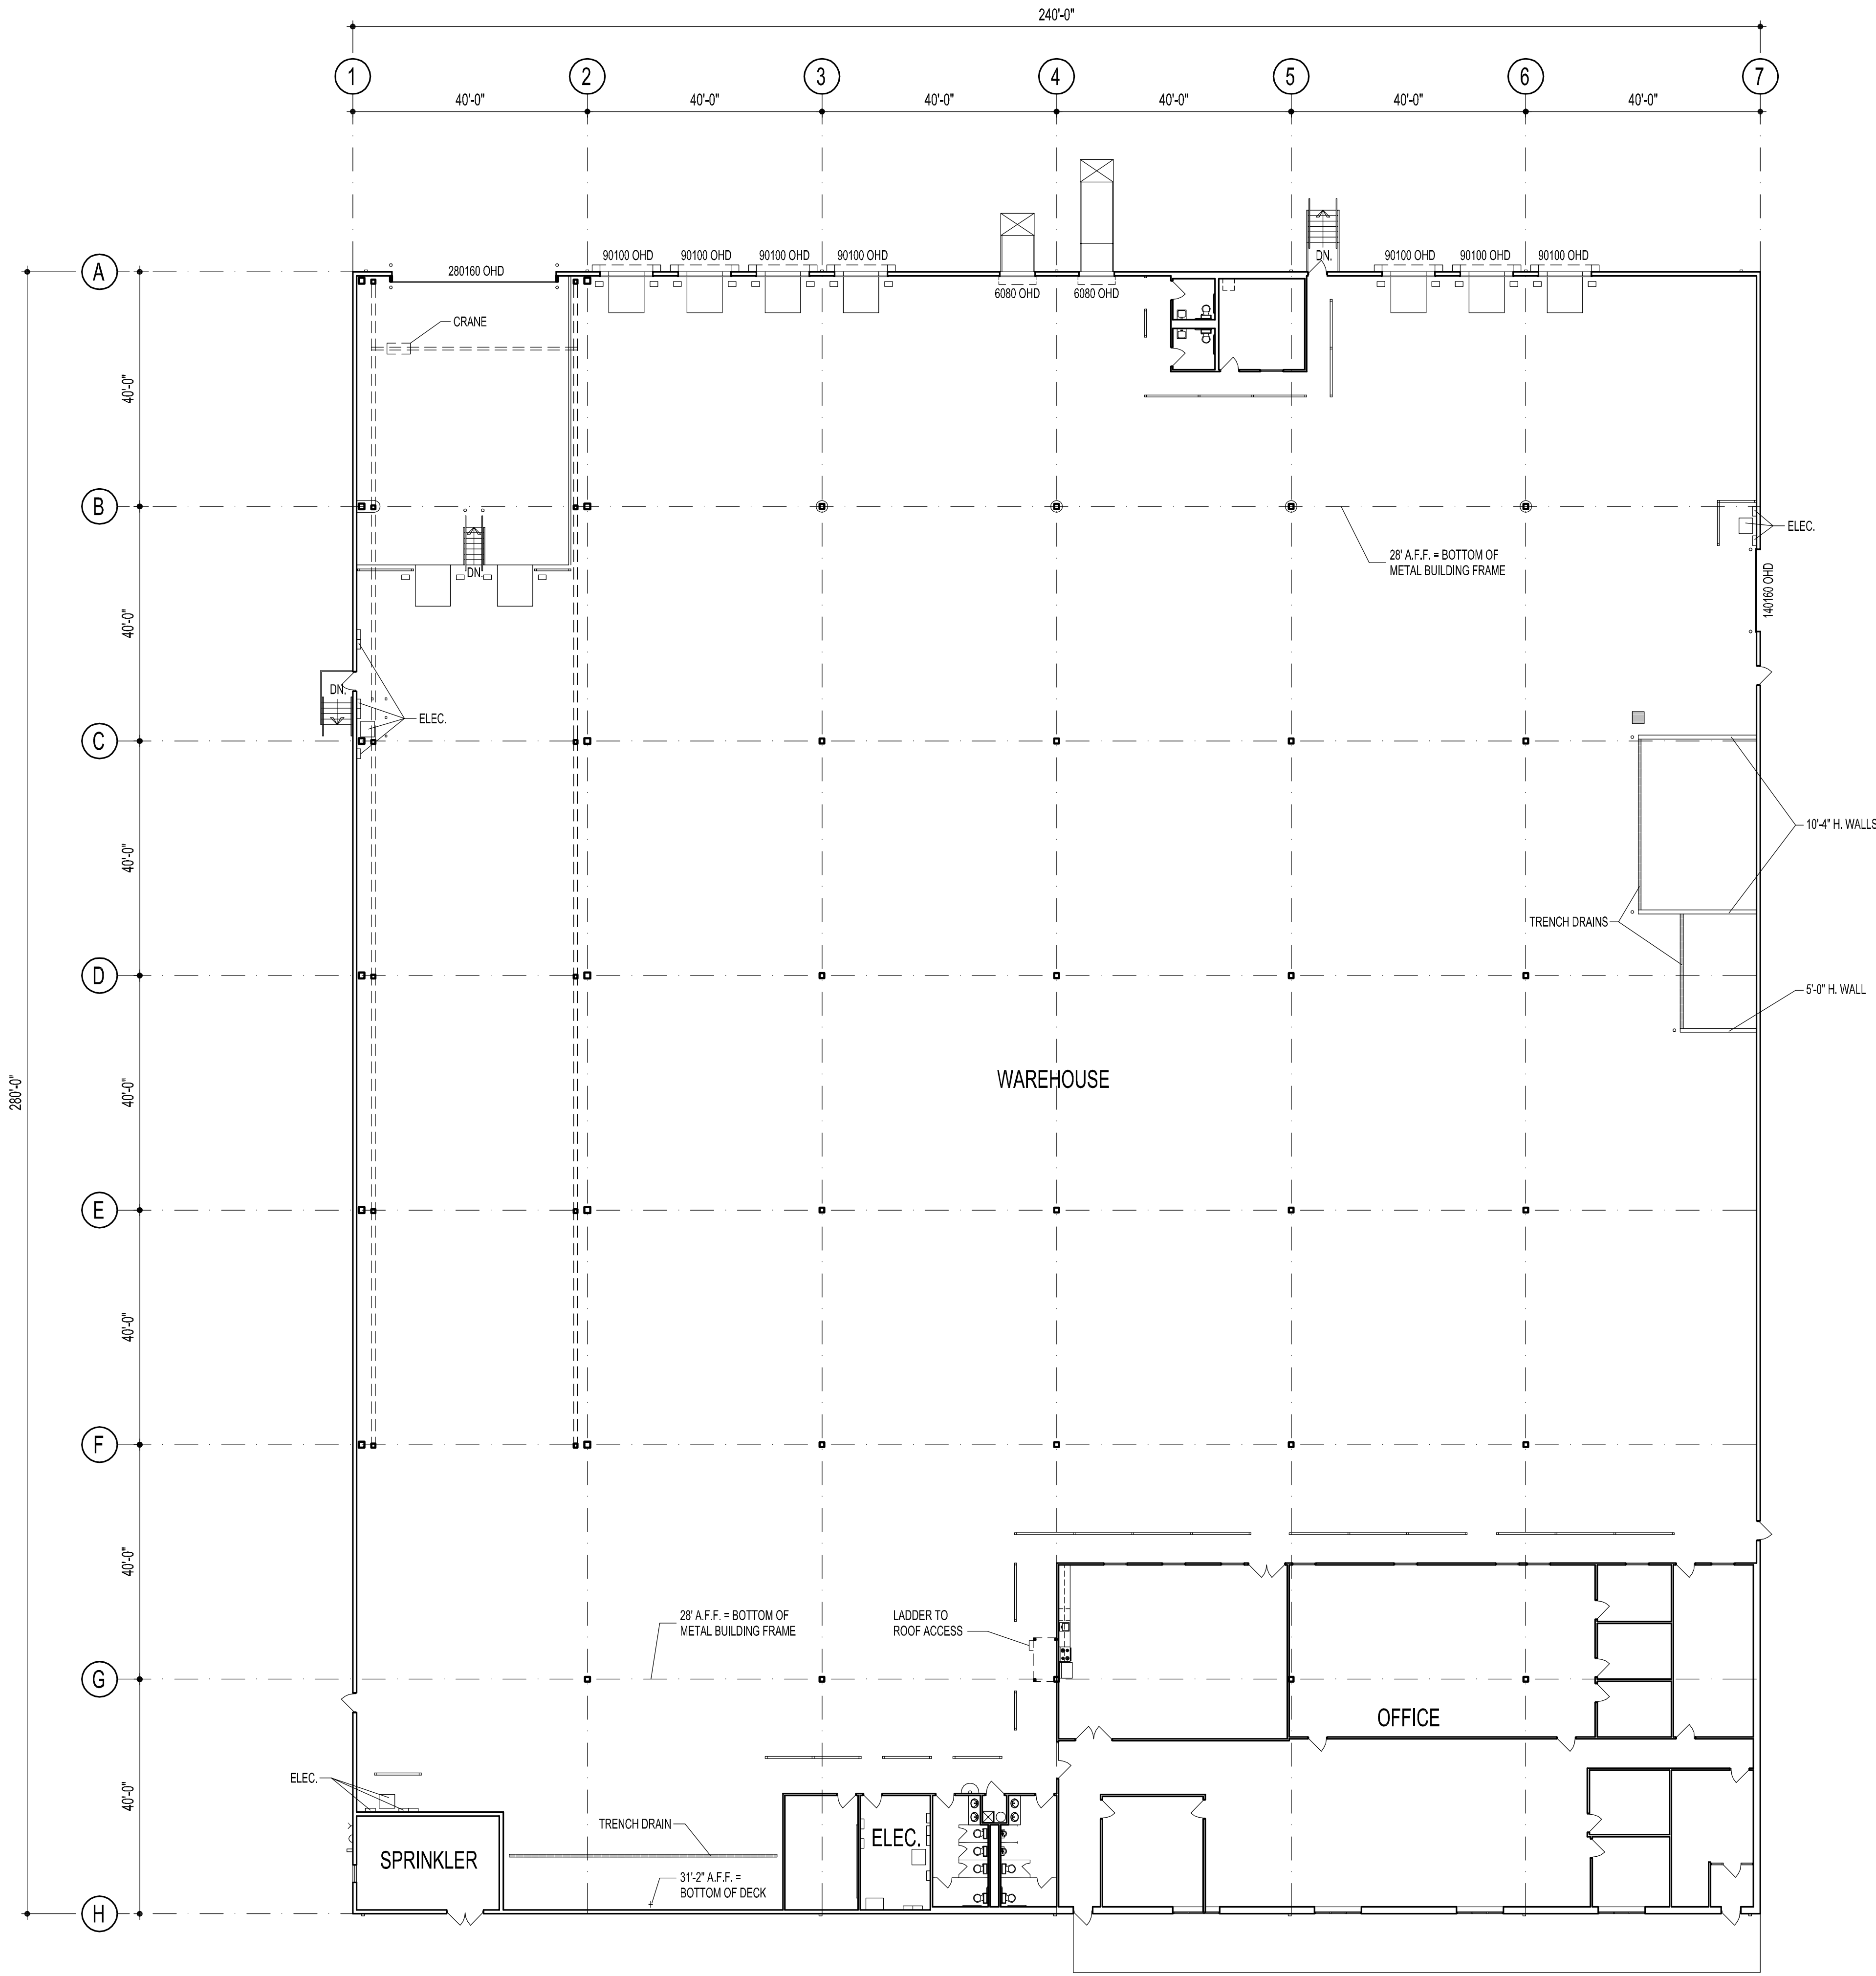

- LEGEND:
- EXISTING WALL TO REMAIN
 - EXISTING WALL TO BE REMOVED
 - NEW WALL
 - TERMINATE WALL @ UNDERSIDE OF DECK ABOVE
 - EXISTING DOOR TO REMAIN
 - EXISTING DOOR TO BE REMOVED
 - NEW DOOR
 - EGRESS PATH/EXIT DOOR
 - FIRE EXTINGUISHER

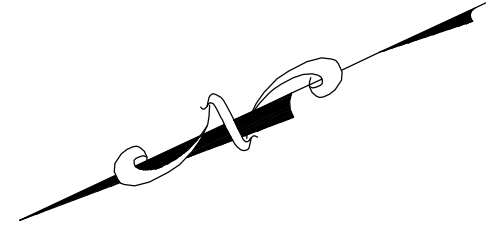

OFFICE = 7,180 G.S.F.
WAREHOUSE = 60,020 G.S.F.
TOTAL = 67,200 G.S.F.

ARCHITECTURE
PLANNING • CONSULTING

Alsip
ASSOCIATES PC

119 KING STREET
HAGERSTOWN, MD 21740

301-991-3554
chip@alsipassociates.com

PROFESSIONAL CERTIFICATION:
I CERTIFY THAT THESE DOCUMENTS WERE PREPARED OR APPROVED BY ME, & THAT I AM A DULY LICENSED ARCHITECT UNDER THE LAWS OF THE STATE OF WEST VIRGINIA, LICENSE #3873 EXPIRATION DATE 6-30-25.

SEAL

A+A Project #250250
As-Built for:
EXISTING BUILDING
5158 Williamsport Pike
Martinsburg, West Virginia 25404

DATE	#	REVISION

DATE: 5-23-25
DRAWN BY: SD
DRAWING TITLE:
AS-BUILT FLOOR PLAN



A1.1
COPYRIGHT 2025

[illegible]

DATE:	5-23-25
DRAWN BY:	SD
DRAWING TITLE:	
PARTIAL FIRST FLOOR PLAN OFFICE	

LEGEND:

	EXISTING WALL TO REMAIN
	EXISTING WALL TO BE REMOVED
	NEW WALL
	TERMINATE WALL @ UNDERSIDE OF DECK ABOVE
	EXISTING DOOR TO REMAIN
	EXISTING DOOR TO BE REMOVED
	NEW DOOR
	EGRESS PATH/EXIT DOOR
	FIRE EXTINGUISHER

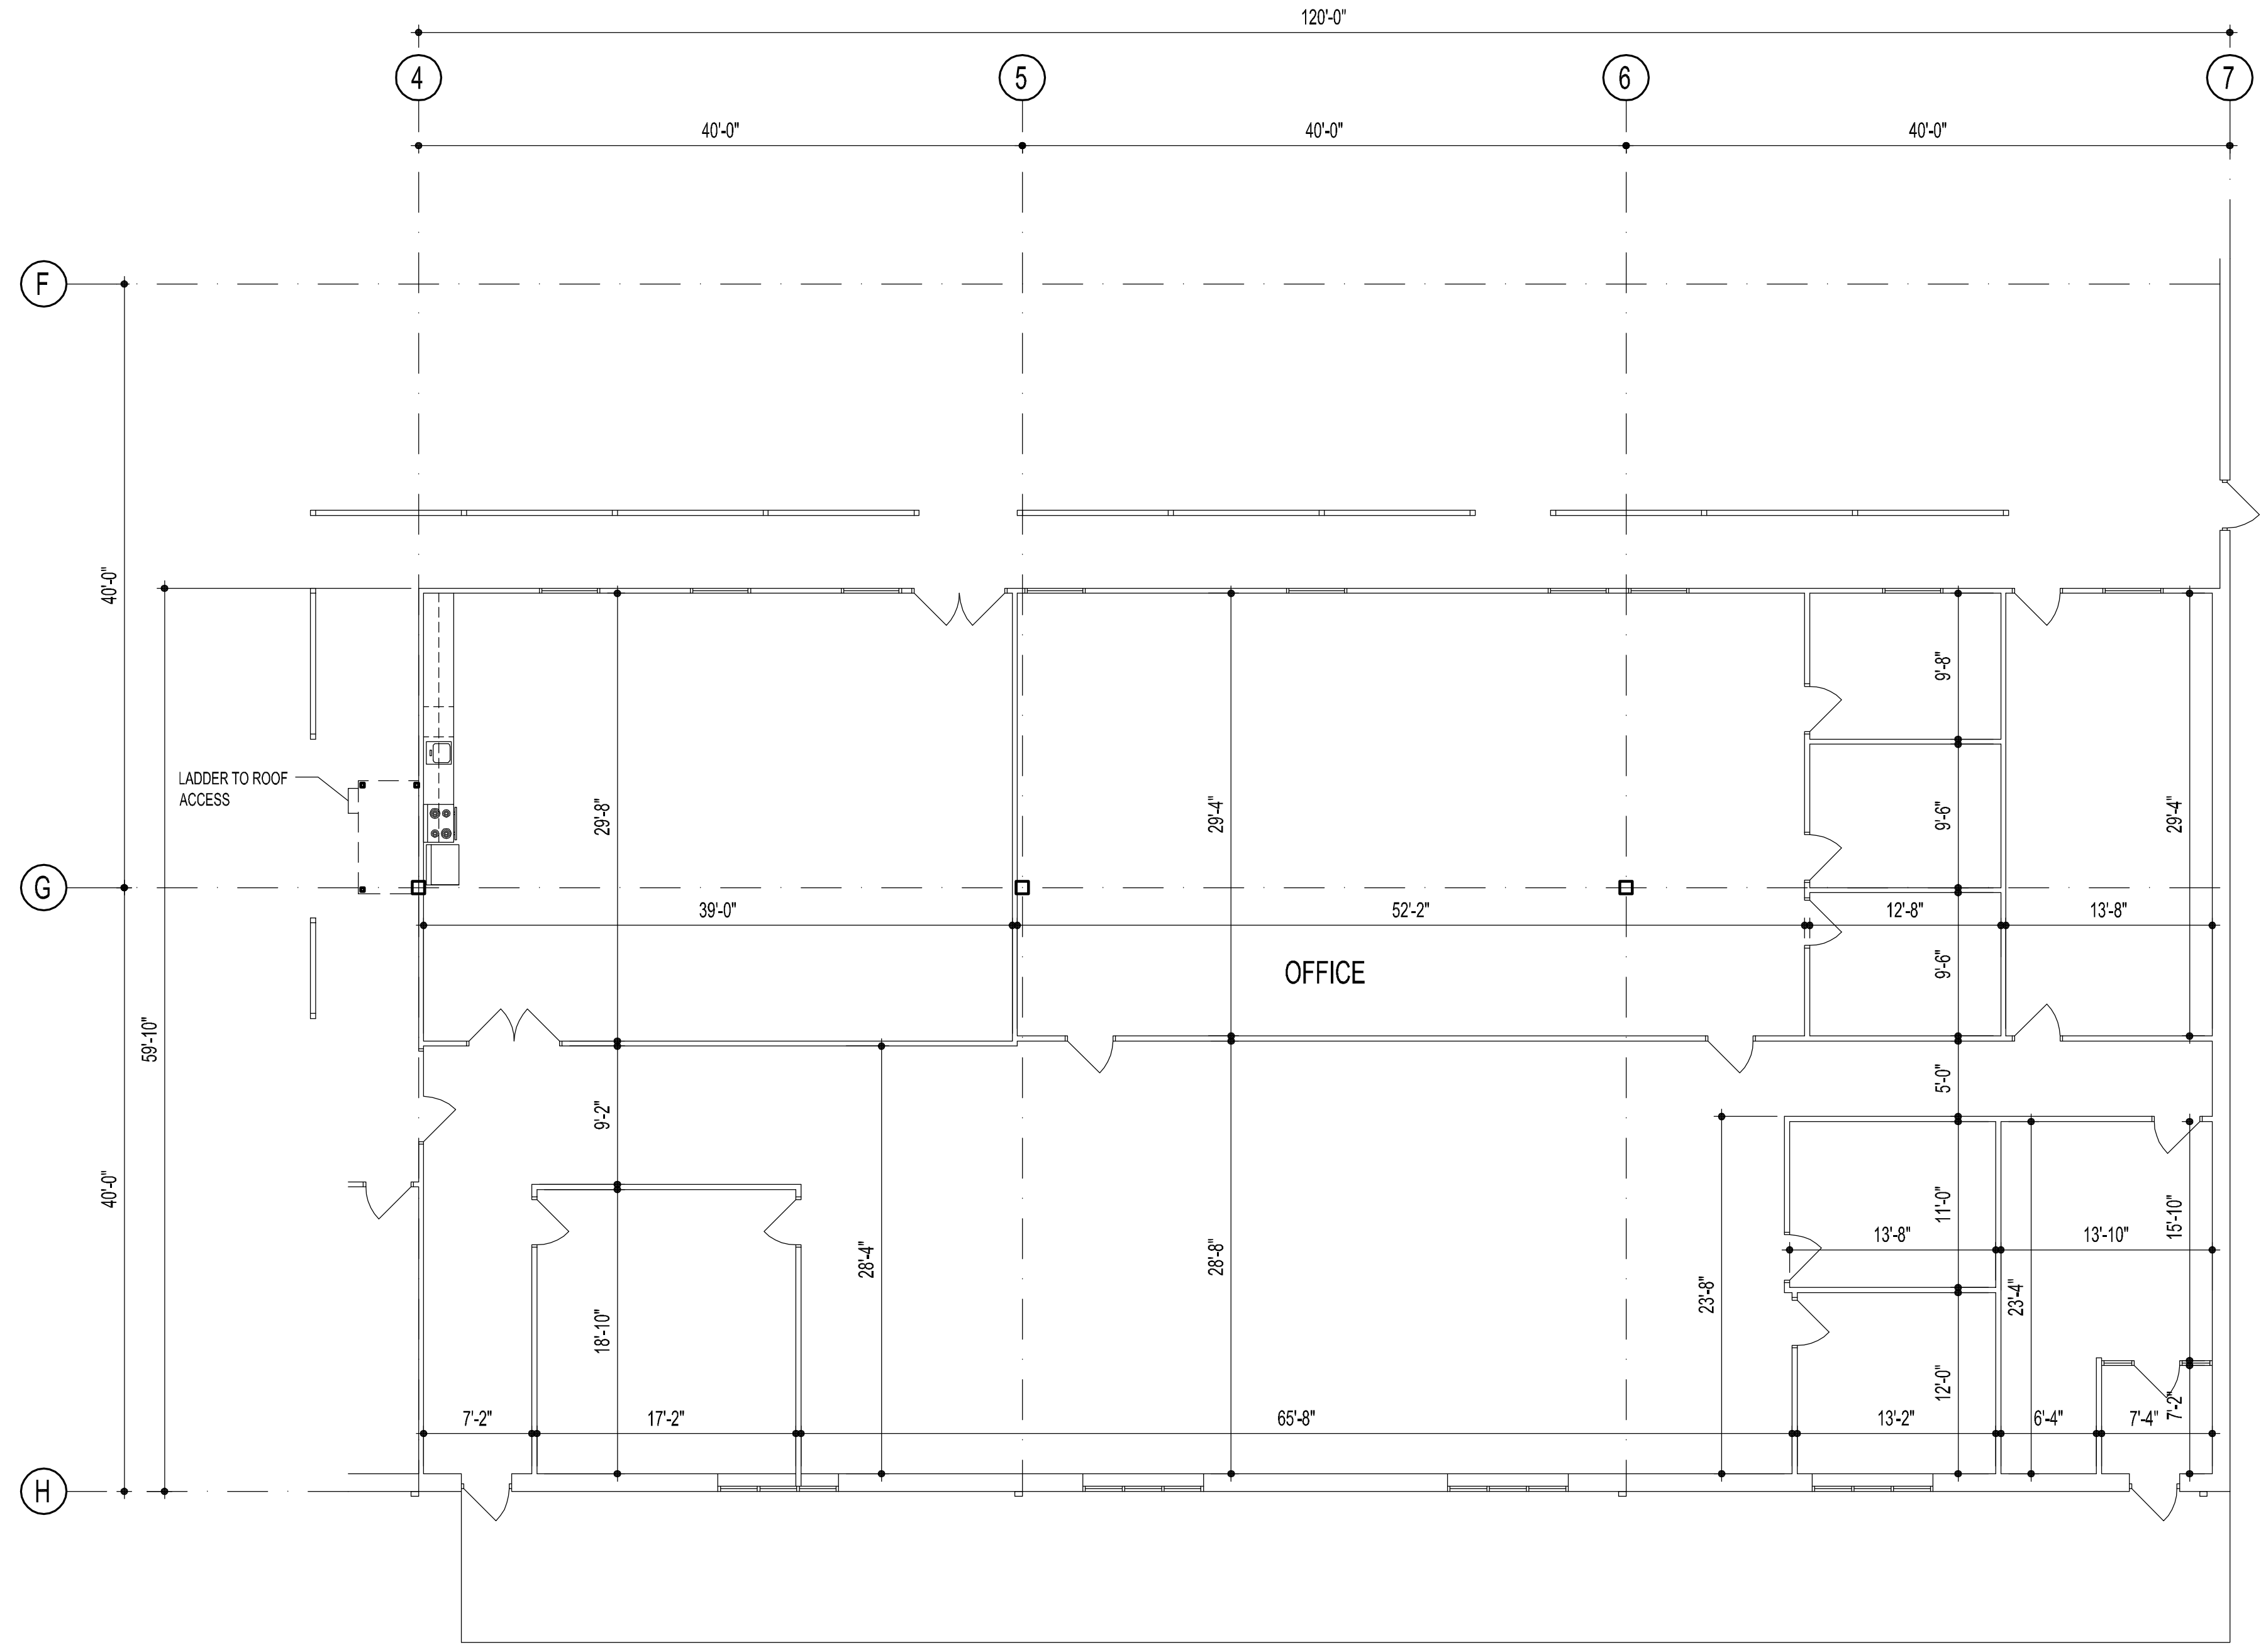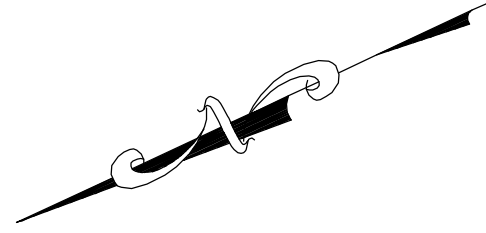

OFFICE = 7,180 G.S.F.

1
1.2

FIRST FLOOR PLAN - OFFICE

1/8" = 1'-0"