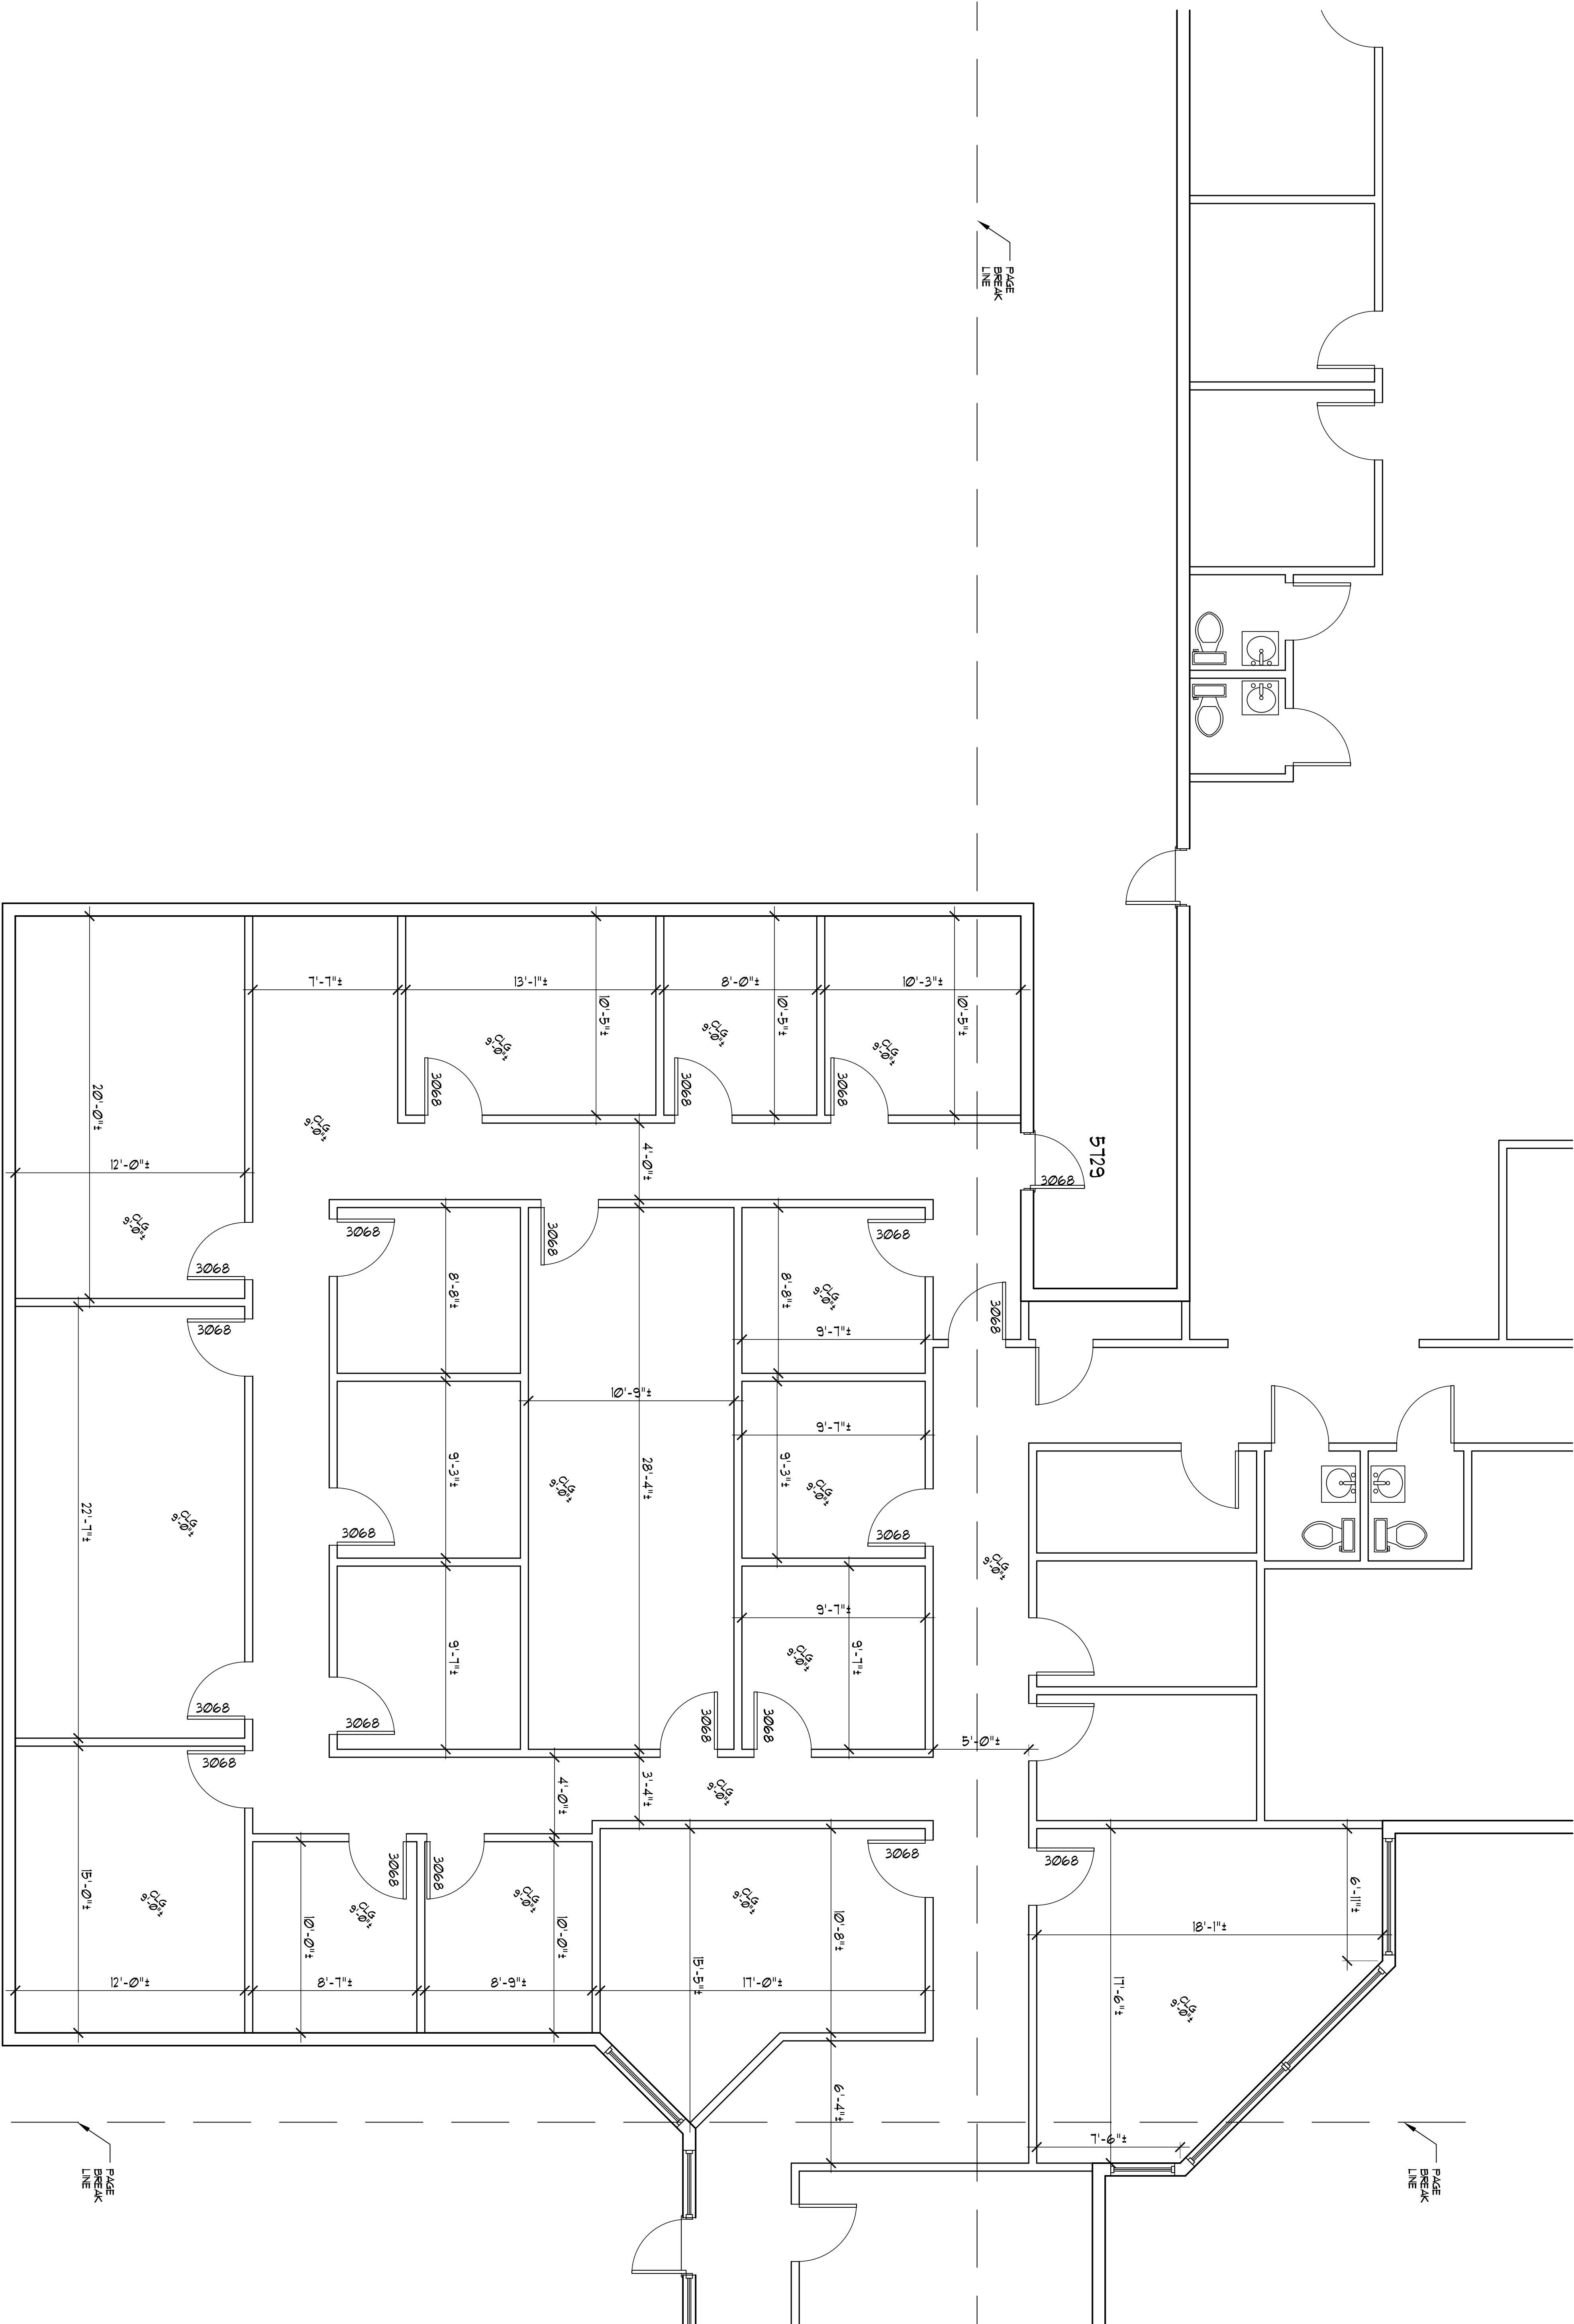



PAGE
BREAK
LINE

PAGE
BREAK
LINE

PAGE
BREAK
LINE

5129 = 17616 Sq. Ft. ±.

NOTE: ALL DIMENSIONS ARE APPROXIMATE BASED ON THE SKETCH PROVIDED AND THE AS-BUILT CONDITIONS MEASURED IN PLACE. EXACT MEASUREMENTS MUST BE FIELD VERIFIED.

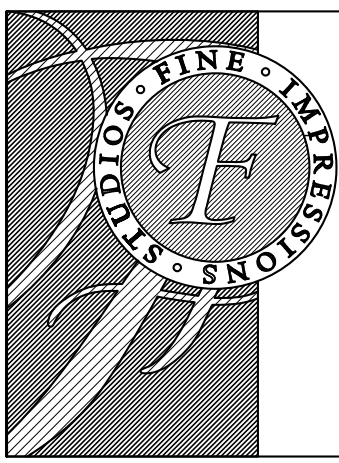SHEET # 2 2 OF 4		FINE IMPRESSIONS STUDIOS DRAFTING & DESIGN Jeffrey M. Wilson 920 59th Street West Bradenton, FL 34209 941.526.6508	TITLE: 5729 Manatee Avenue West Bradenton, FL 34209	TO THE BEST OF THE DESIGNER'S KNOWLEDGE, THE DESIGN REPRESENTED BY THESE DRAWINGS CONTAINS ALL PERTINENT INFORMATION AS REQUESTED BY THE CLIENT AND FOUND EXISTING ON SITE. ALL RIGHTS RESERVED. REPRODUCTION OR ANY PORTION OF THESE PLANS IS PROHIBITED. THESE DRAWINGS WERE PREPARED FOR THE USE OF THE CLIENT AND ARE NOT TO BE USED FOR ANY OTHER PURPOSE. THE DESIGNER'S APPROVAL OF THE WORK IS NOT A GUARANTEE OF THE ACCURACY OF THE INFORMATION PROVIDED.	CLIENT:				
					AS-BUILT DATE: 1/17/25	FINAL DRAFT:	SCALE: 1/4"=1'		
					REVISIONS:	REVISIONS:	DRAFTED BY: J.M.W.		