


# 10043 Lincoln Highway

Frankfort, Illinois 60423

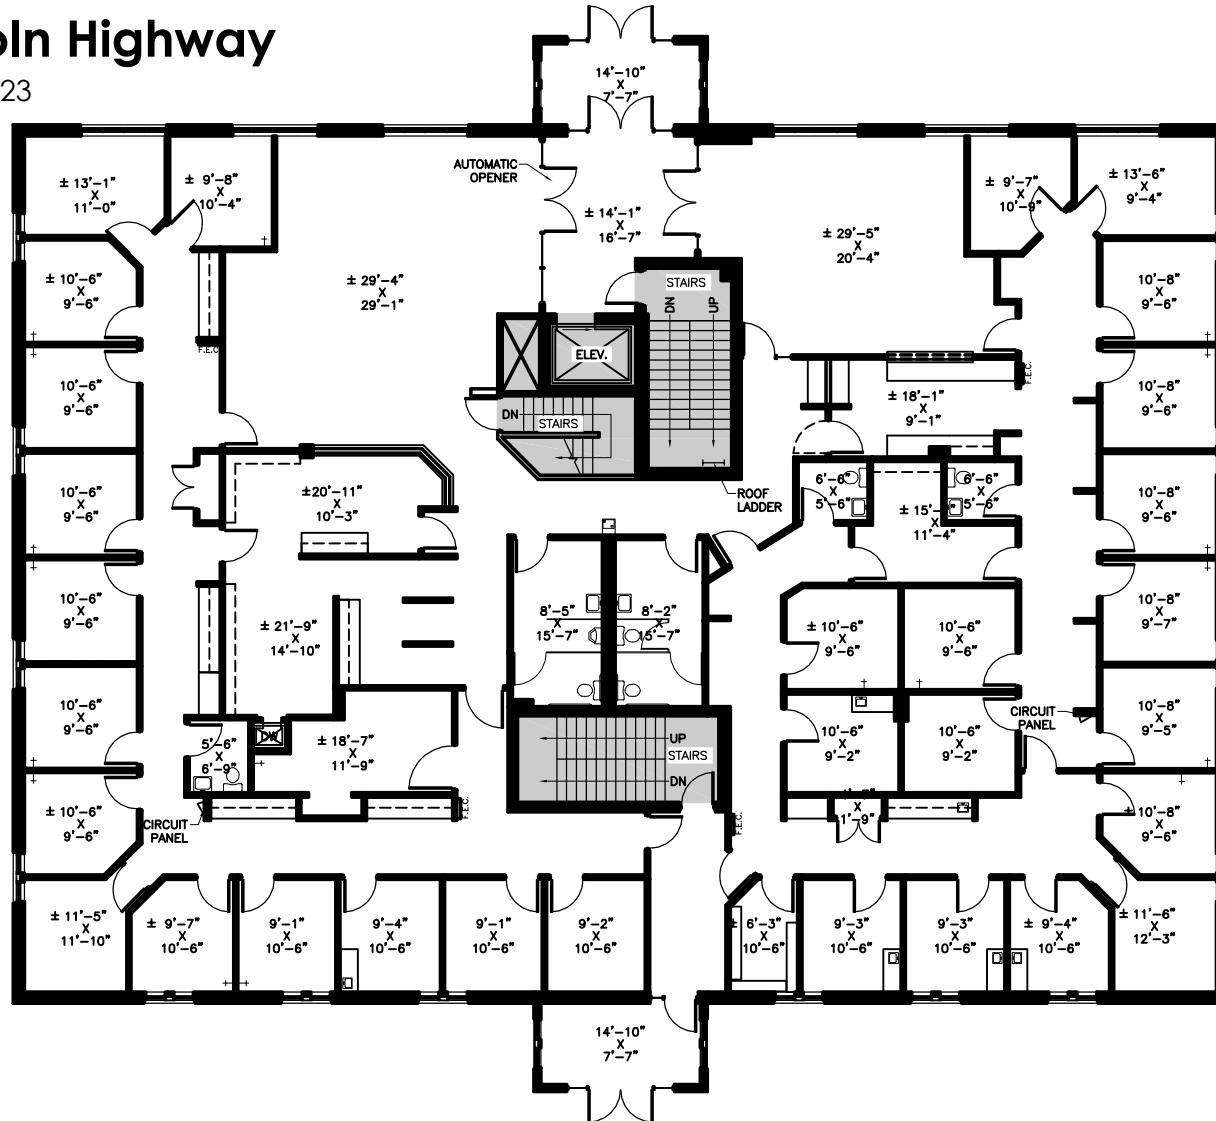

## First Floor - As-Built Conditions

First Floor: 8,782 Rentable Square Feet  
 Building Total: 24,125 Rentable Square Feet

Scale:

N.T.S.

