



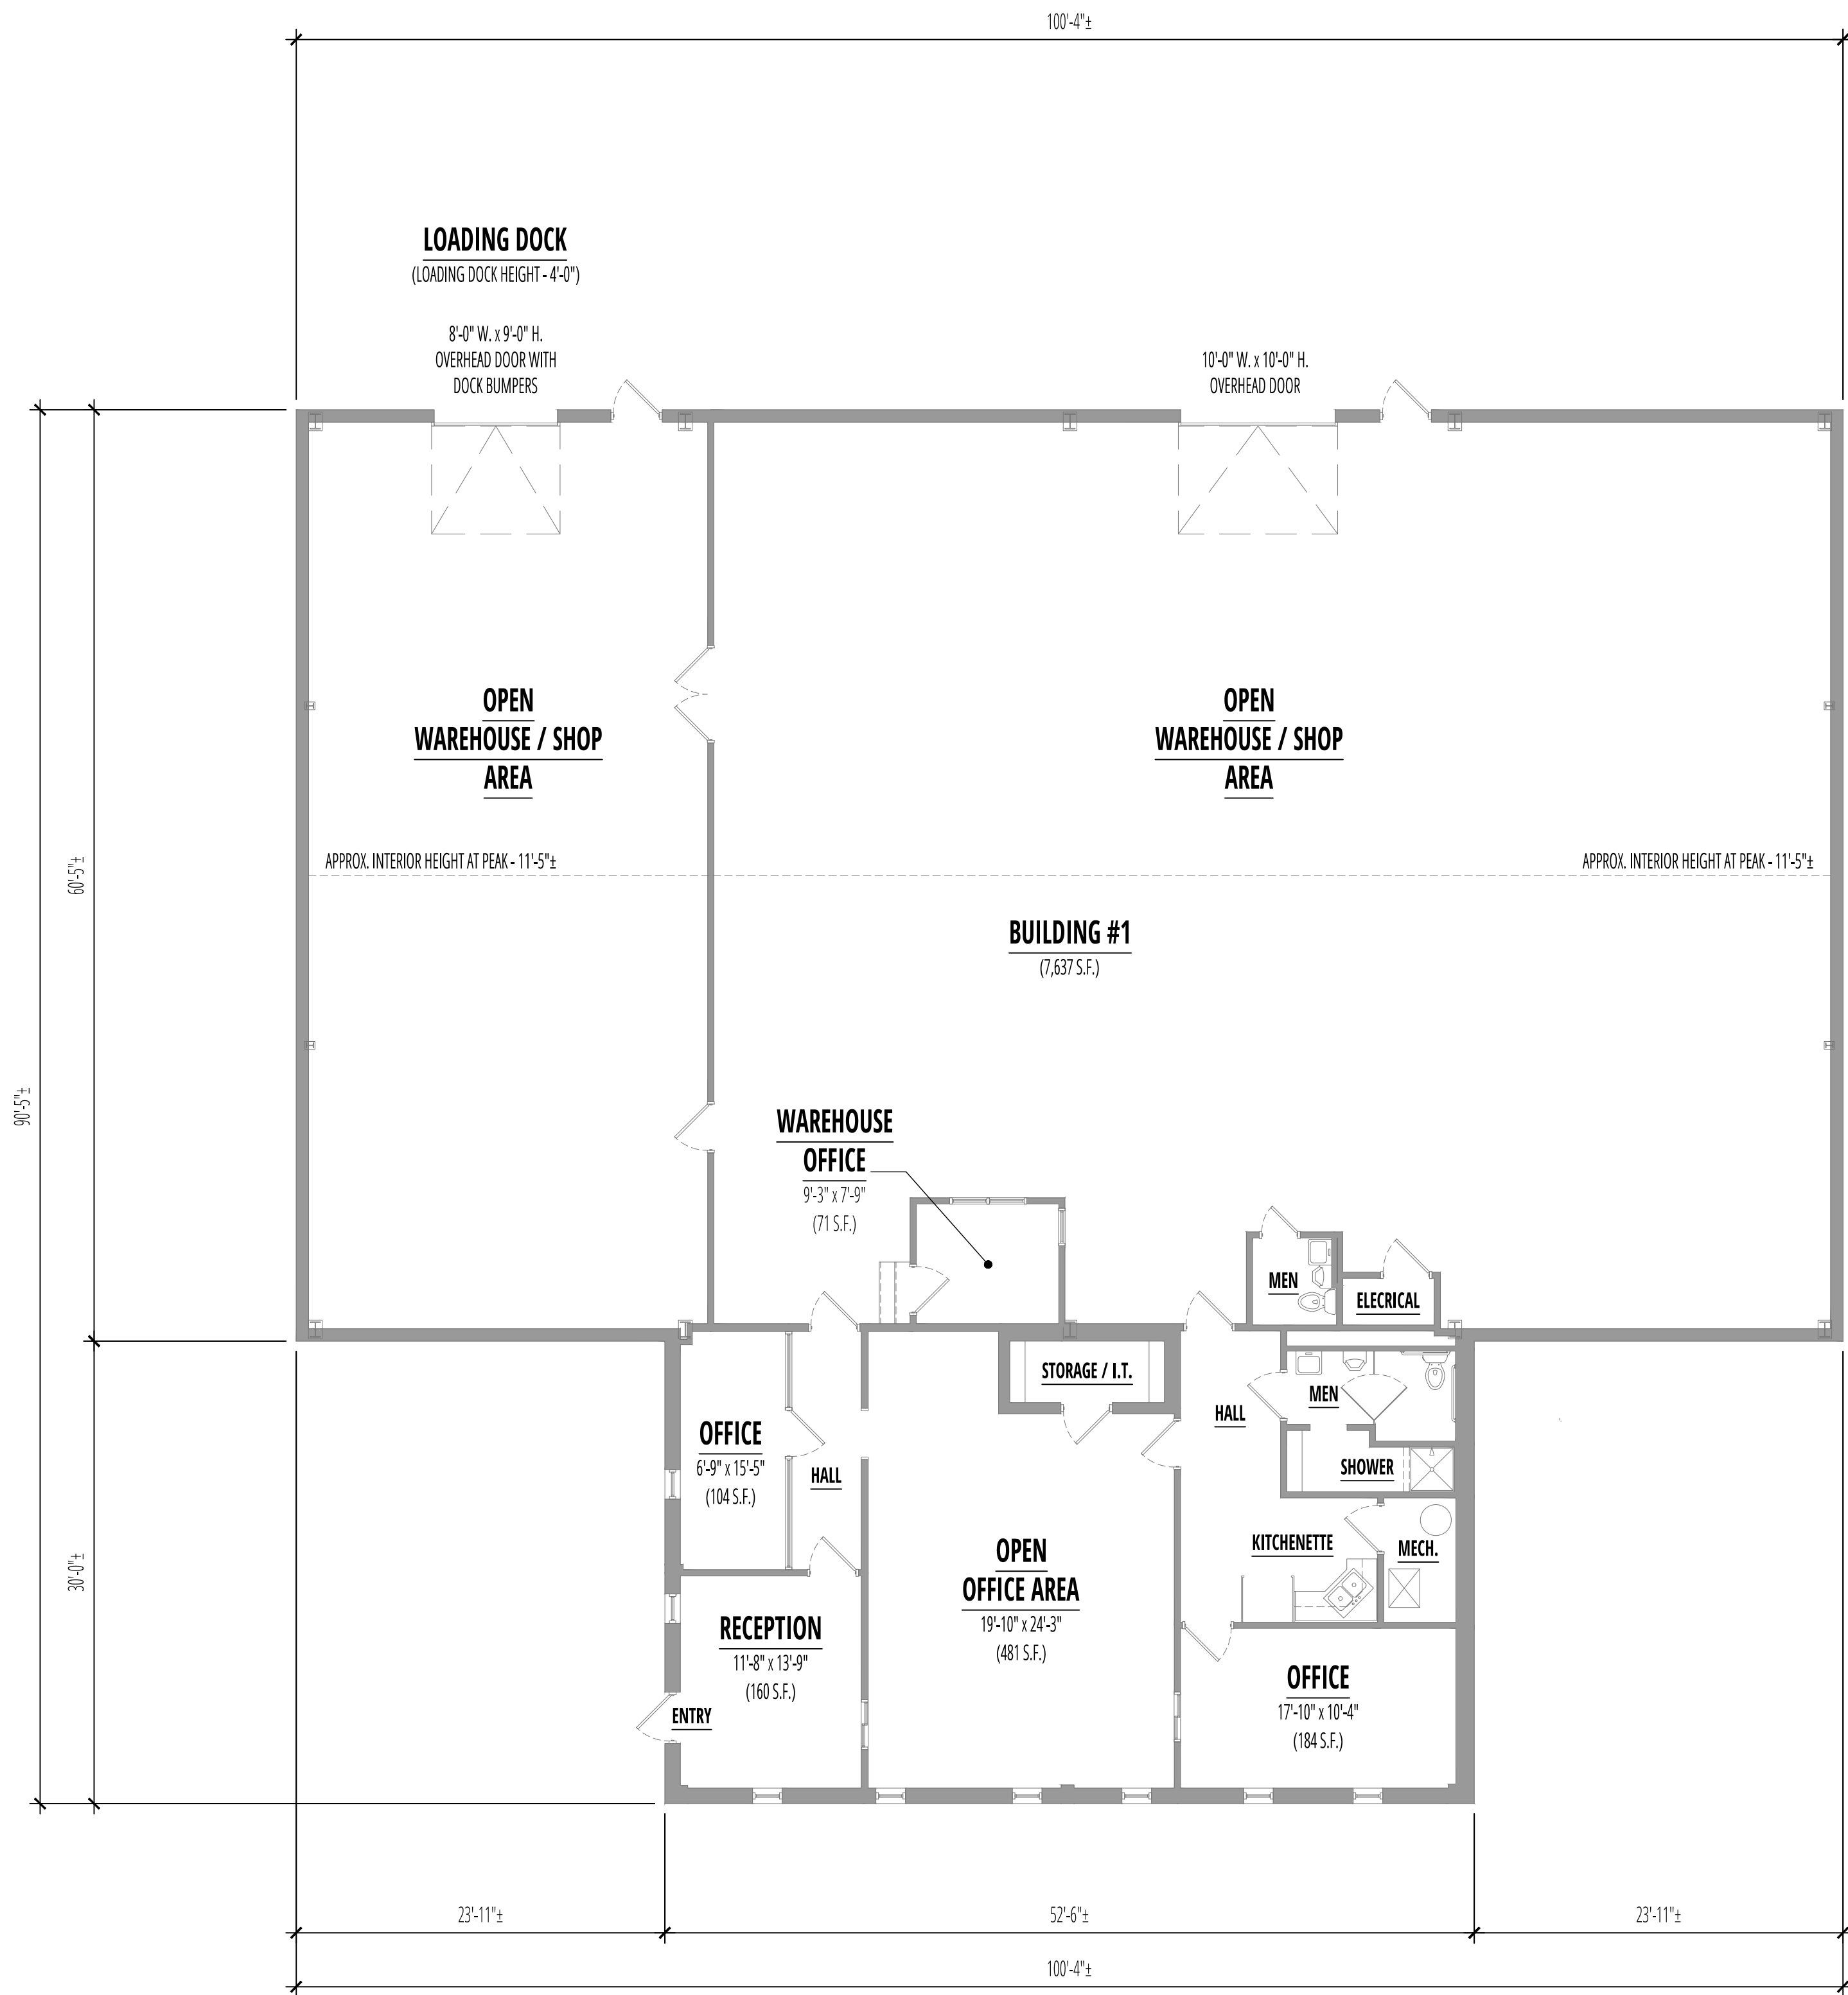

SQUARE FOOTAGES :

BUILDING #1:	7,637 SF
BUILDING #2:	7,225 SF
TOTAL SQUARE FOOTAGE	14,862 SF

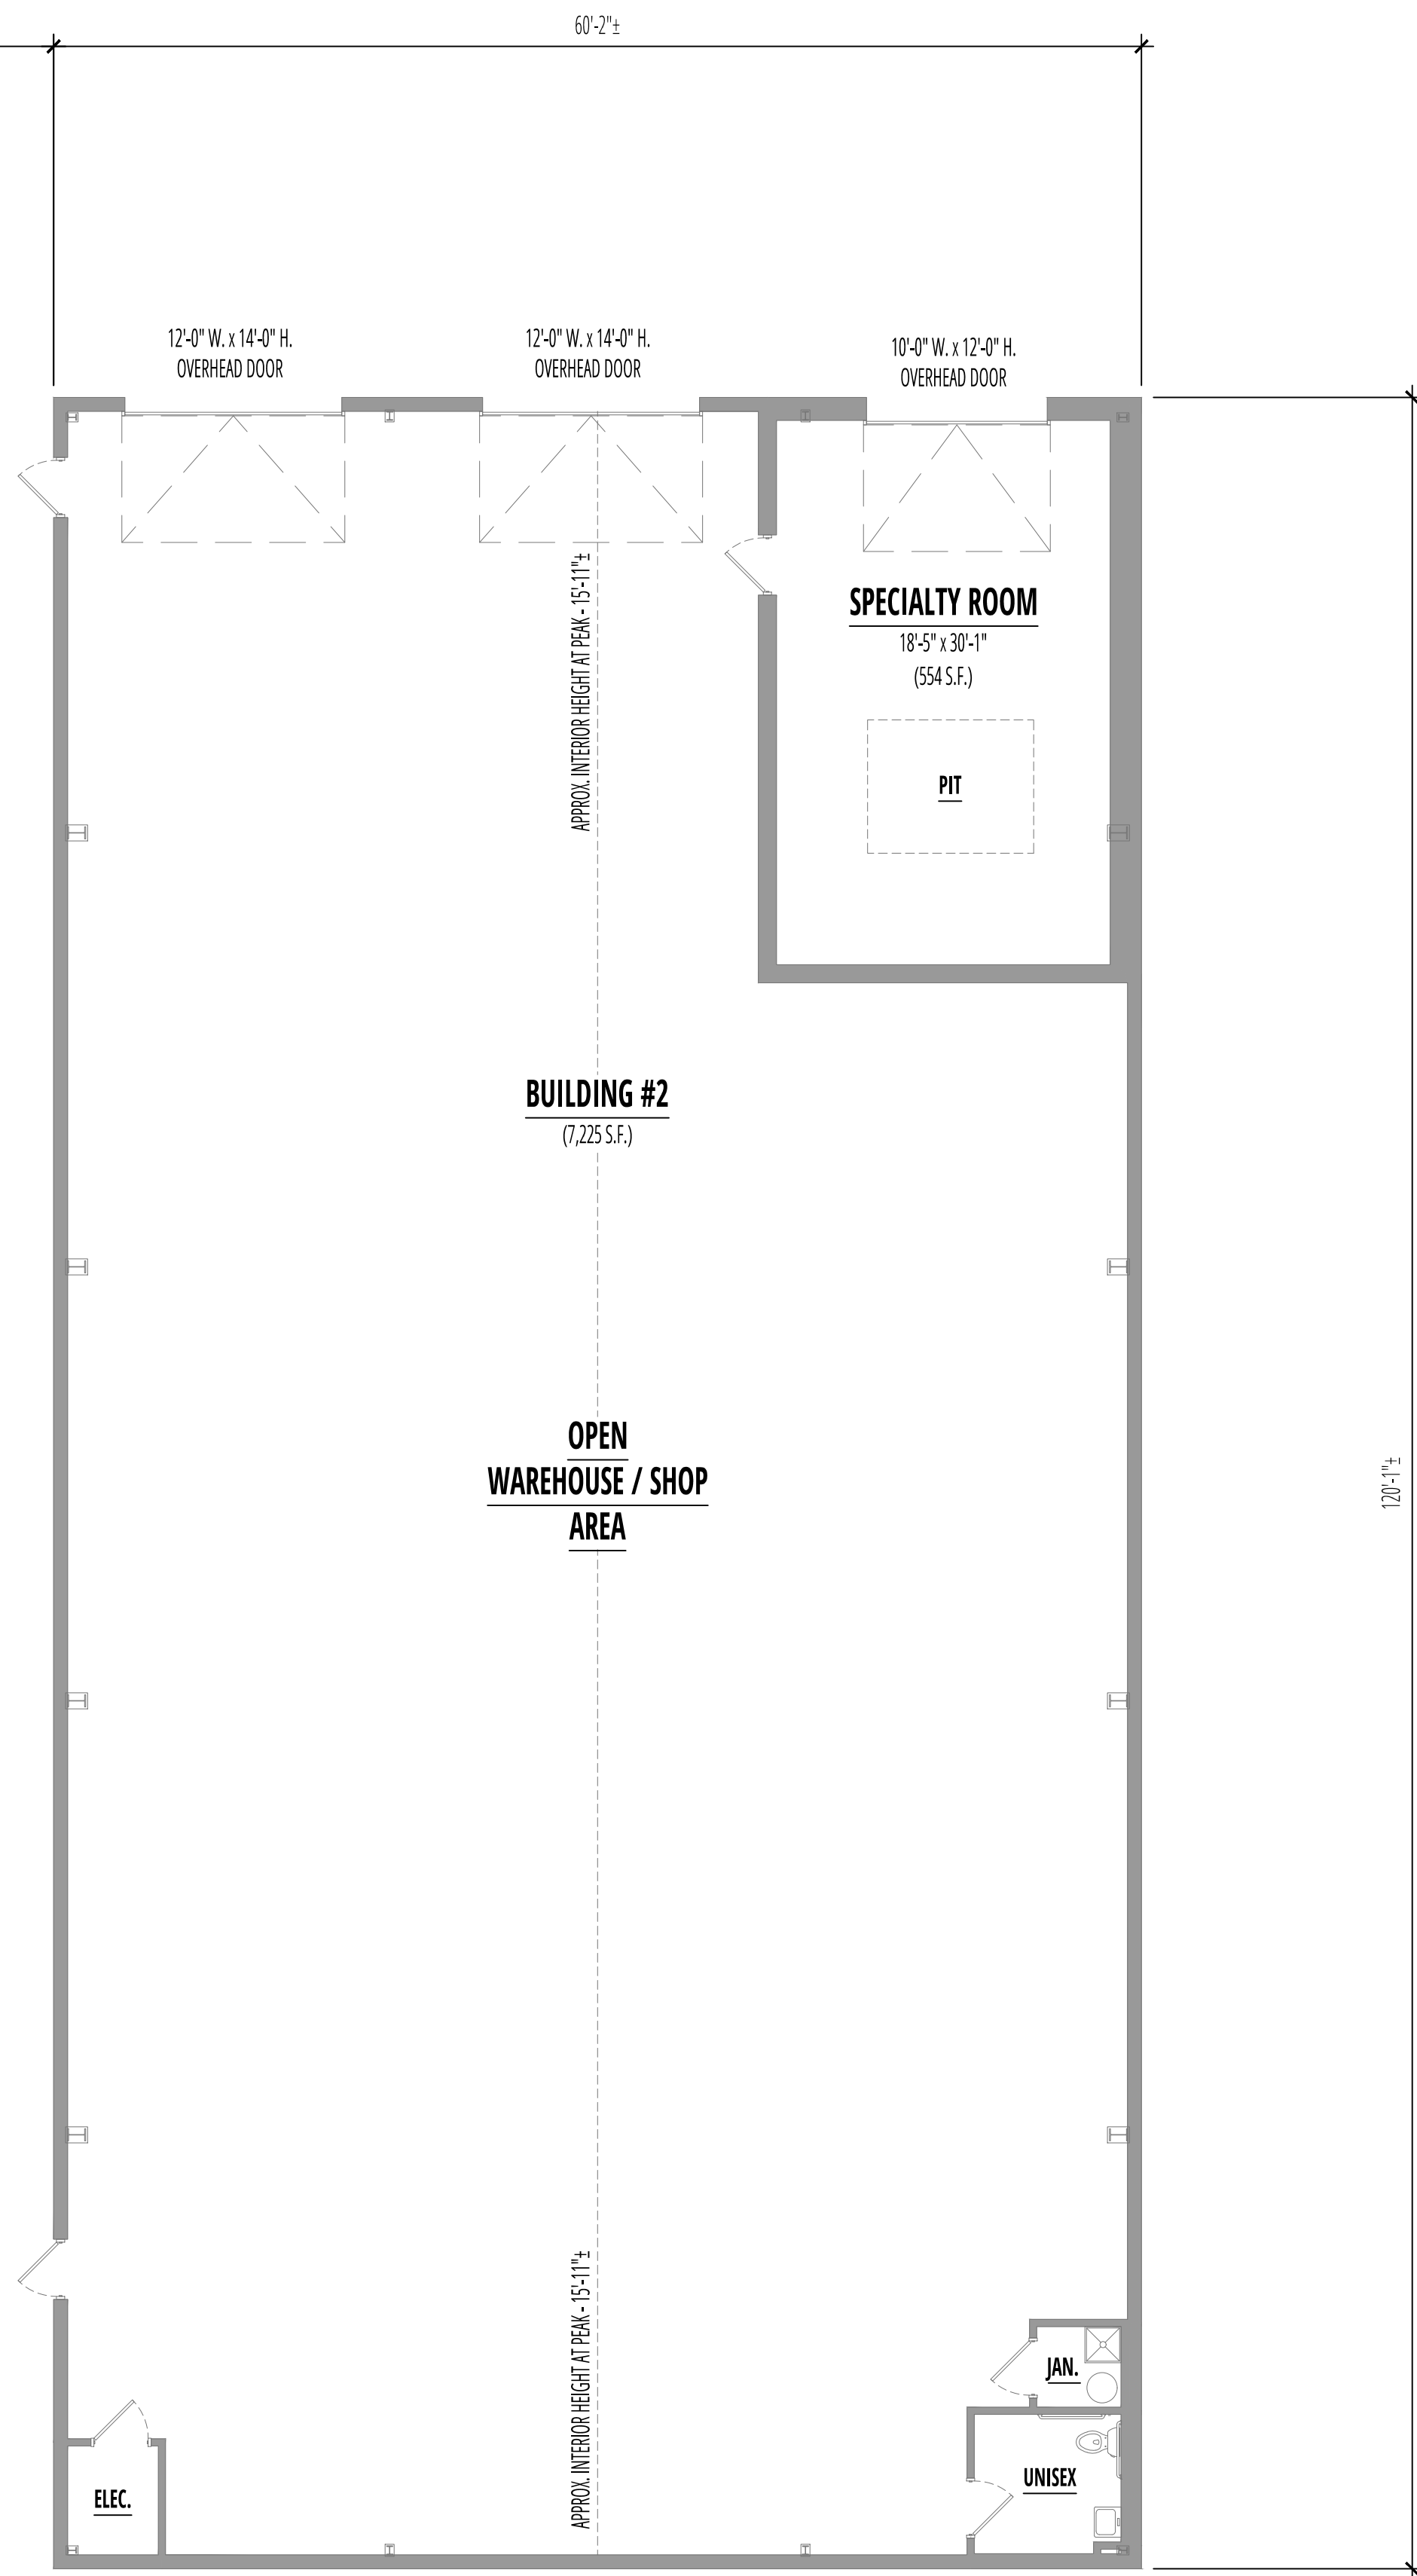

FLOOR PLAN - MAIN LEVEL - AS-BUILT

SCALE: 1/8" = 1'-0"



SHAH DEVELOPMENT, LLC

180 TEEL STREET
CHRISTIANSBURG, VA 24073
(540) 260-9939
mneebble@shelcor.com

MICHAEL W. NEEBLE, AIA

AS-BUILT DOCUMENTATION FOR
4085 PEPPERELL WAY

4085 PEPPERELL WAY, DUBLIN, VIRGINIA 24084

FLOOR PLAN - MAIN LEVEL - AS-BUILT

Revisions

Project No.	25-002
Date	01/15/2025
Design	SHAH
Drawing	MVN
Check	MVN
File	25-002 - AB101-AB102.DWG

AB101

SHAH DEVELOPMENT, LLC
© COPYRIGHT 2025



ARCHITECTURAL SITE PLAN - AS-BUILT

SCALE 1/8" = 1'-0"



SHAH DEVELOPMENT, LLC

180 TEEL STREET
CHRISTIANSBURG, VA 24073
(540) 260-9939
mneebble@shelcor.com

MICHAEL W. NEEBLE, AIA

AS-BUILT DOCUMENTATION FOR
4085 PEPPERELL WAY

4085 PEPPERELL WAY, DUBLIN, VIRGINIA 24084

ARCHITECTURAL SITE PLAN - AS-BUILT

Revisions

Project No.	25-002
Date	01/15/2025
Design	SHAH
Drawing	MVN
Check	MVN
File	25-002 - AB101-AB102.DWG

AB102

SHAH DEVELOPMENT, LLC

© COPYRIGHT 2025