




triad design group
Architecture | Engineering | Interior Design


Triad Design Group, P.C.
4807-C Koger Boulevard
Greensboro, NC 27407
Telephone 336-218-8282
Facsimile 336-218-8010
www.triad-designgroup.com
NC Architecture Reg. 50709
NC Engineering Lic. C-1108

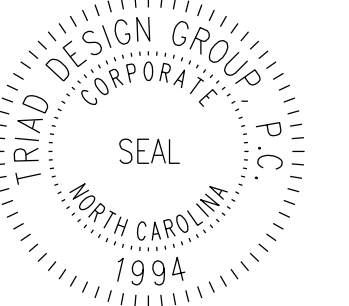

PRELIMINARY

NOT FOR CONSTRUCTION

Wingate Building
ORP Management
4900 Koger Boulevard
Greensboro, North Carolina 27407

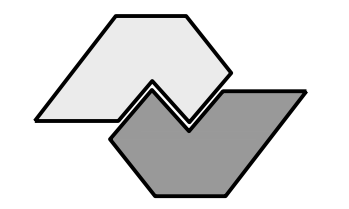

SUBMITTALS:

DATE DESCRIPTION

REVISIONS:

NO DATE DESCRIPTION

SHEET TITLE:

AS-BUILT

OVERALL

SECOND FLOOR


Date: JANUARY 22, 2021

Drawn: Check: MTM

Job Number: 22-006

Sheet:

A102

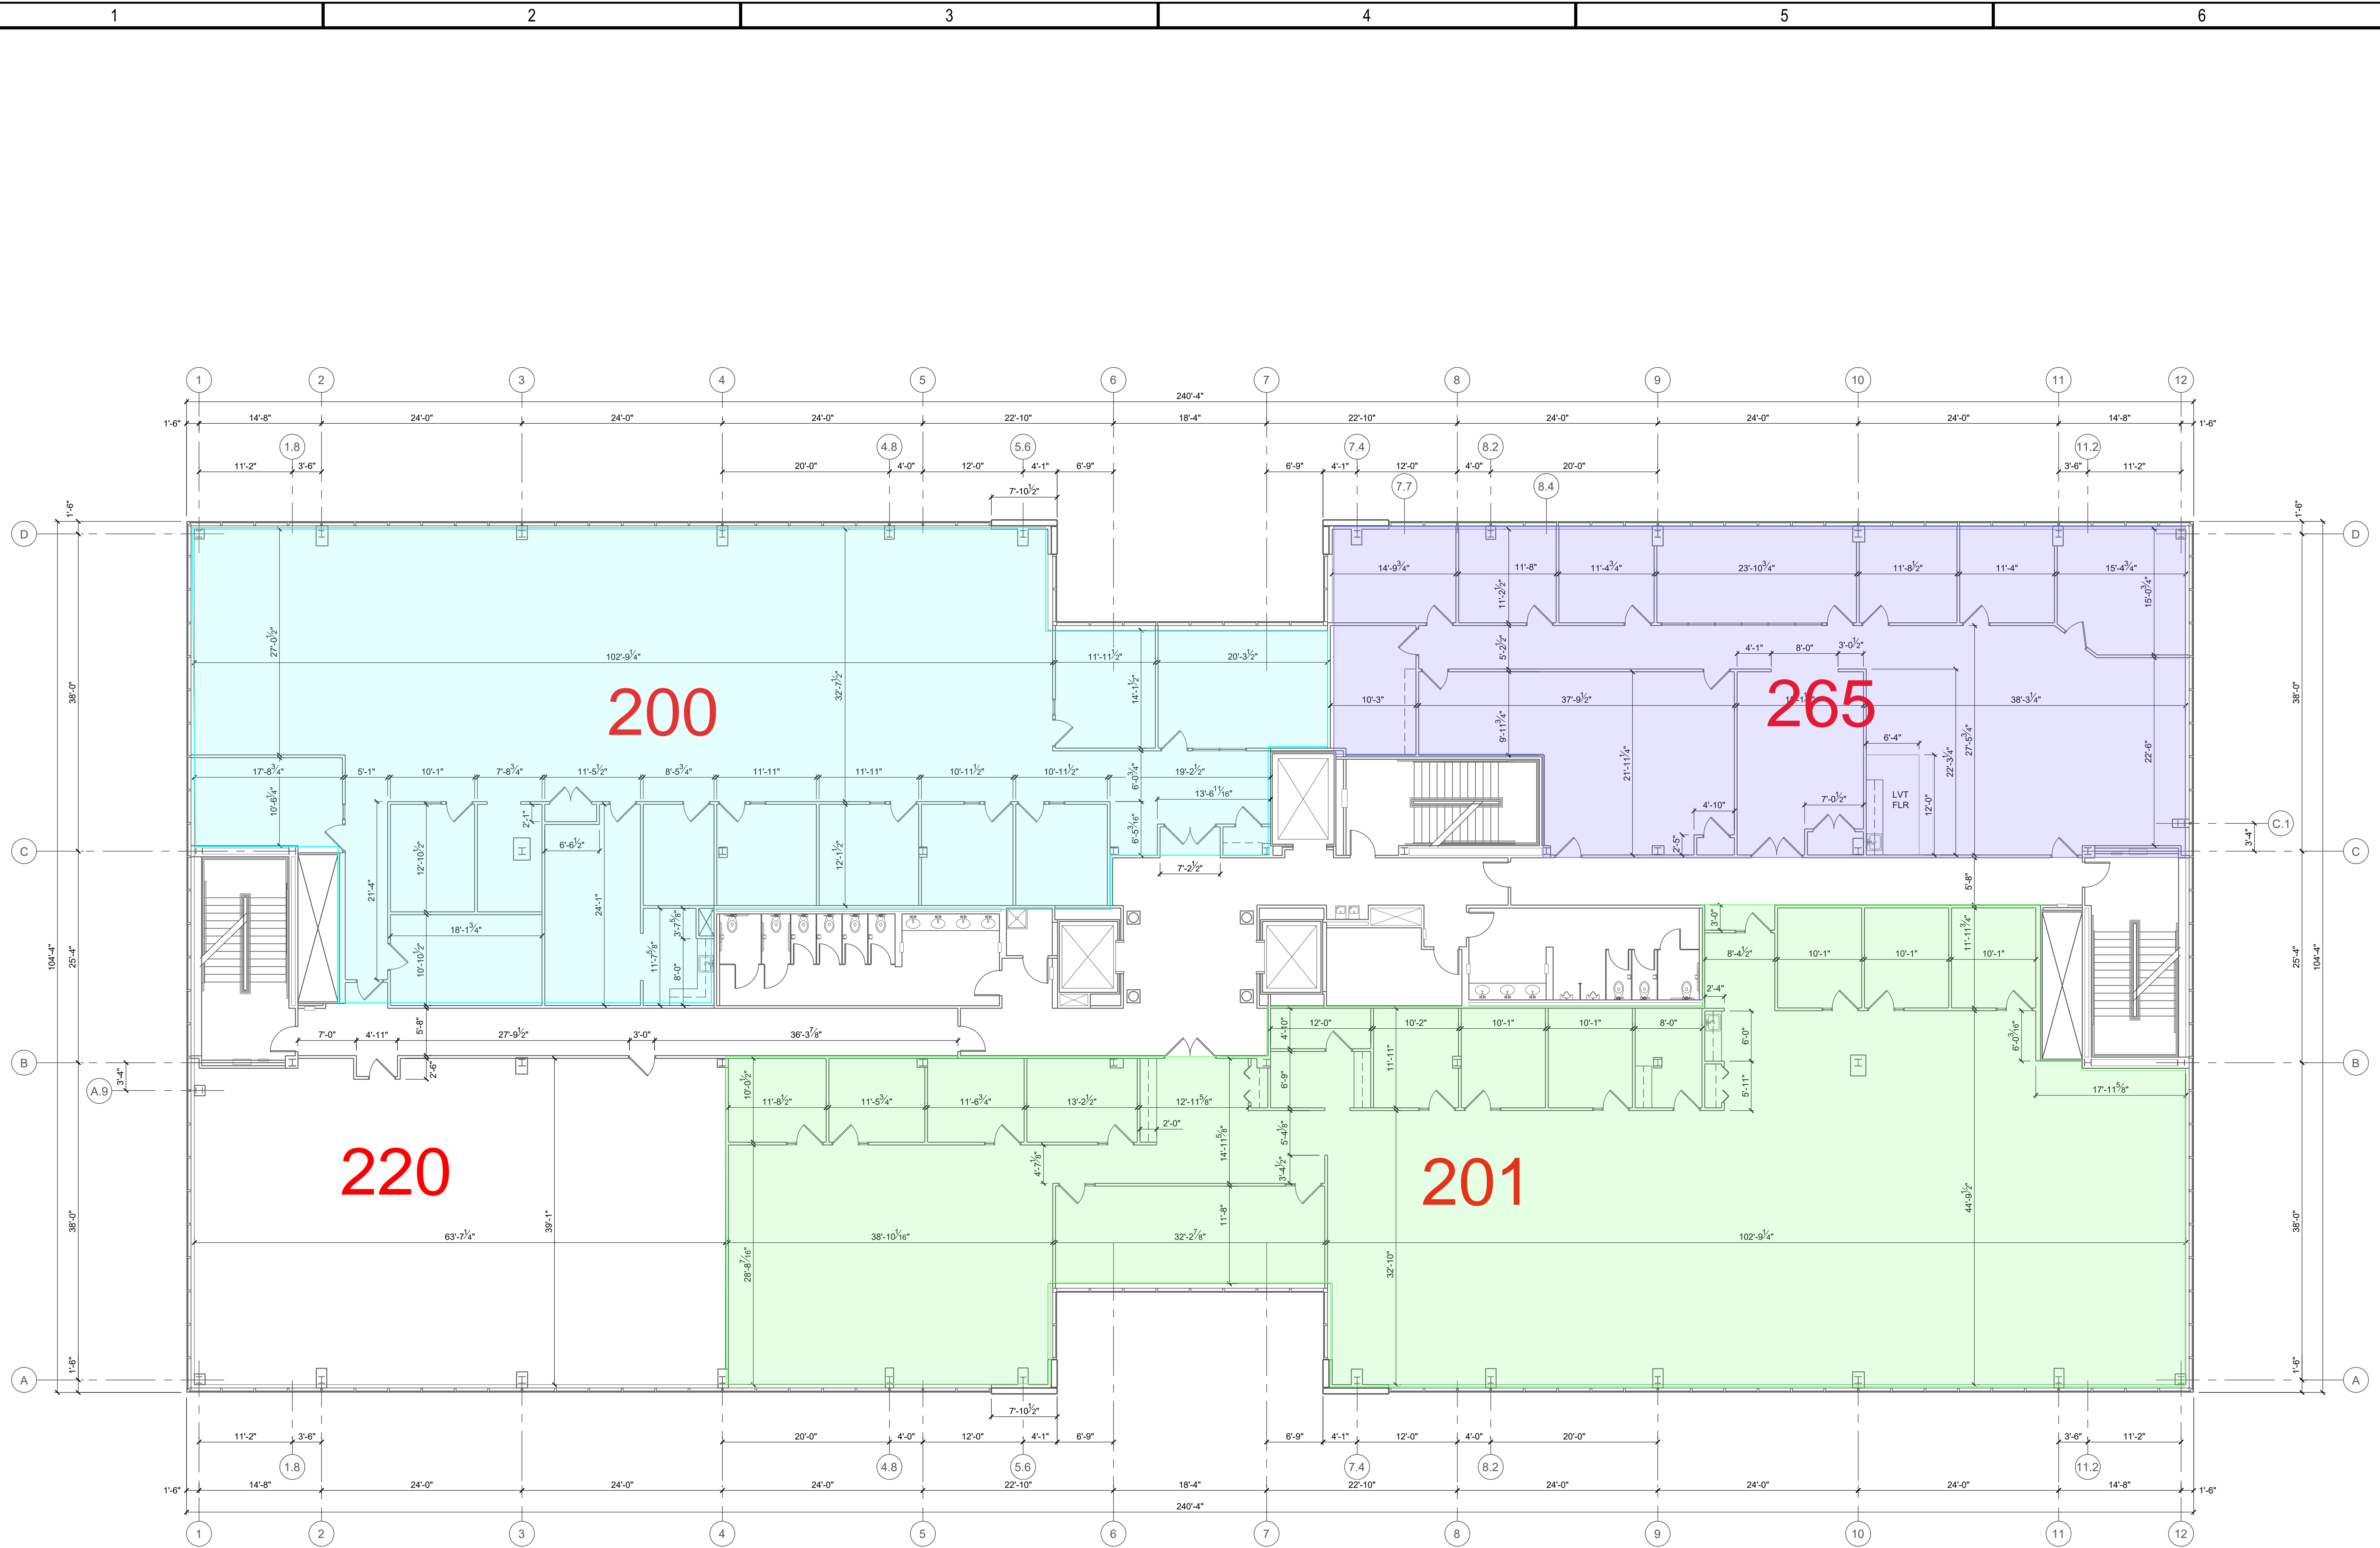

A1 EXISTING SECOND FLOOR PLAN
SCALE: 1/8"=1'-0"

DRAWING NAME: C:\Users\jvetchick\Desktop\Projects\ORP Management\Arch\Wingate Bldg - 2nd Floor_30 x 42 - 1/23/2022 10:00 AM