



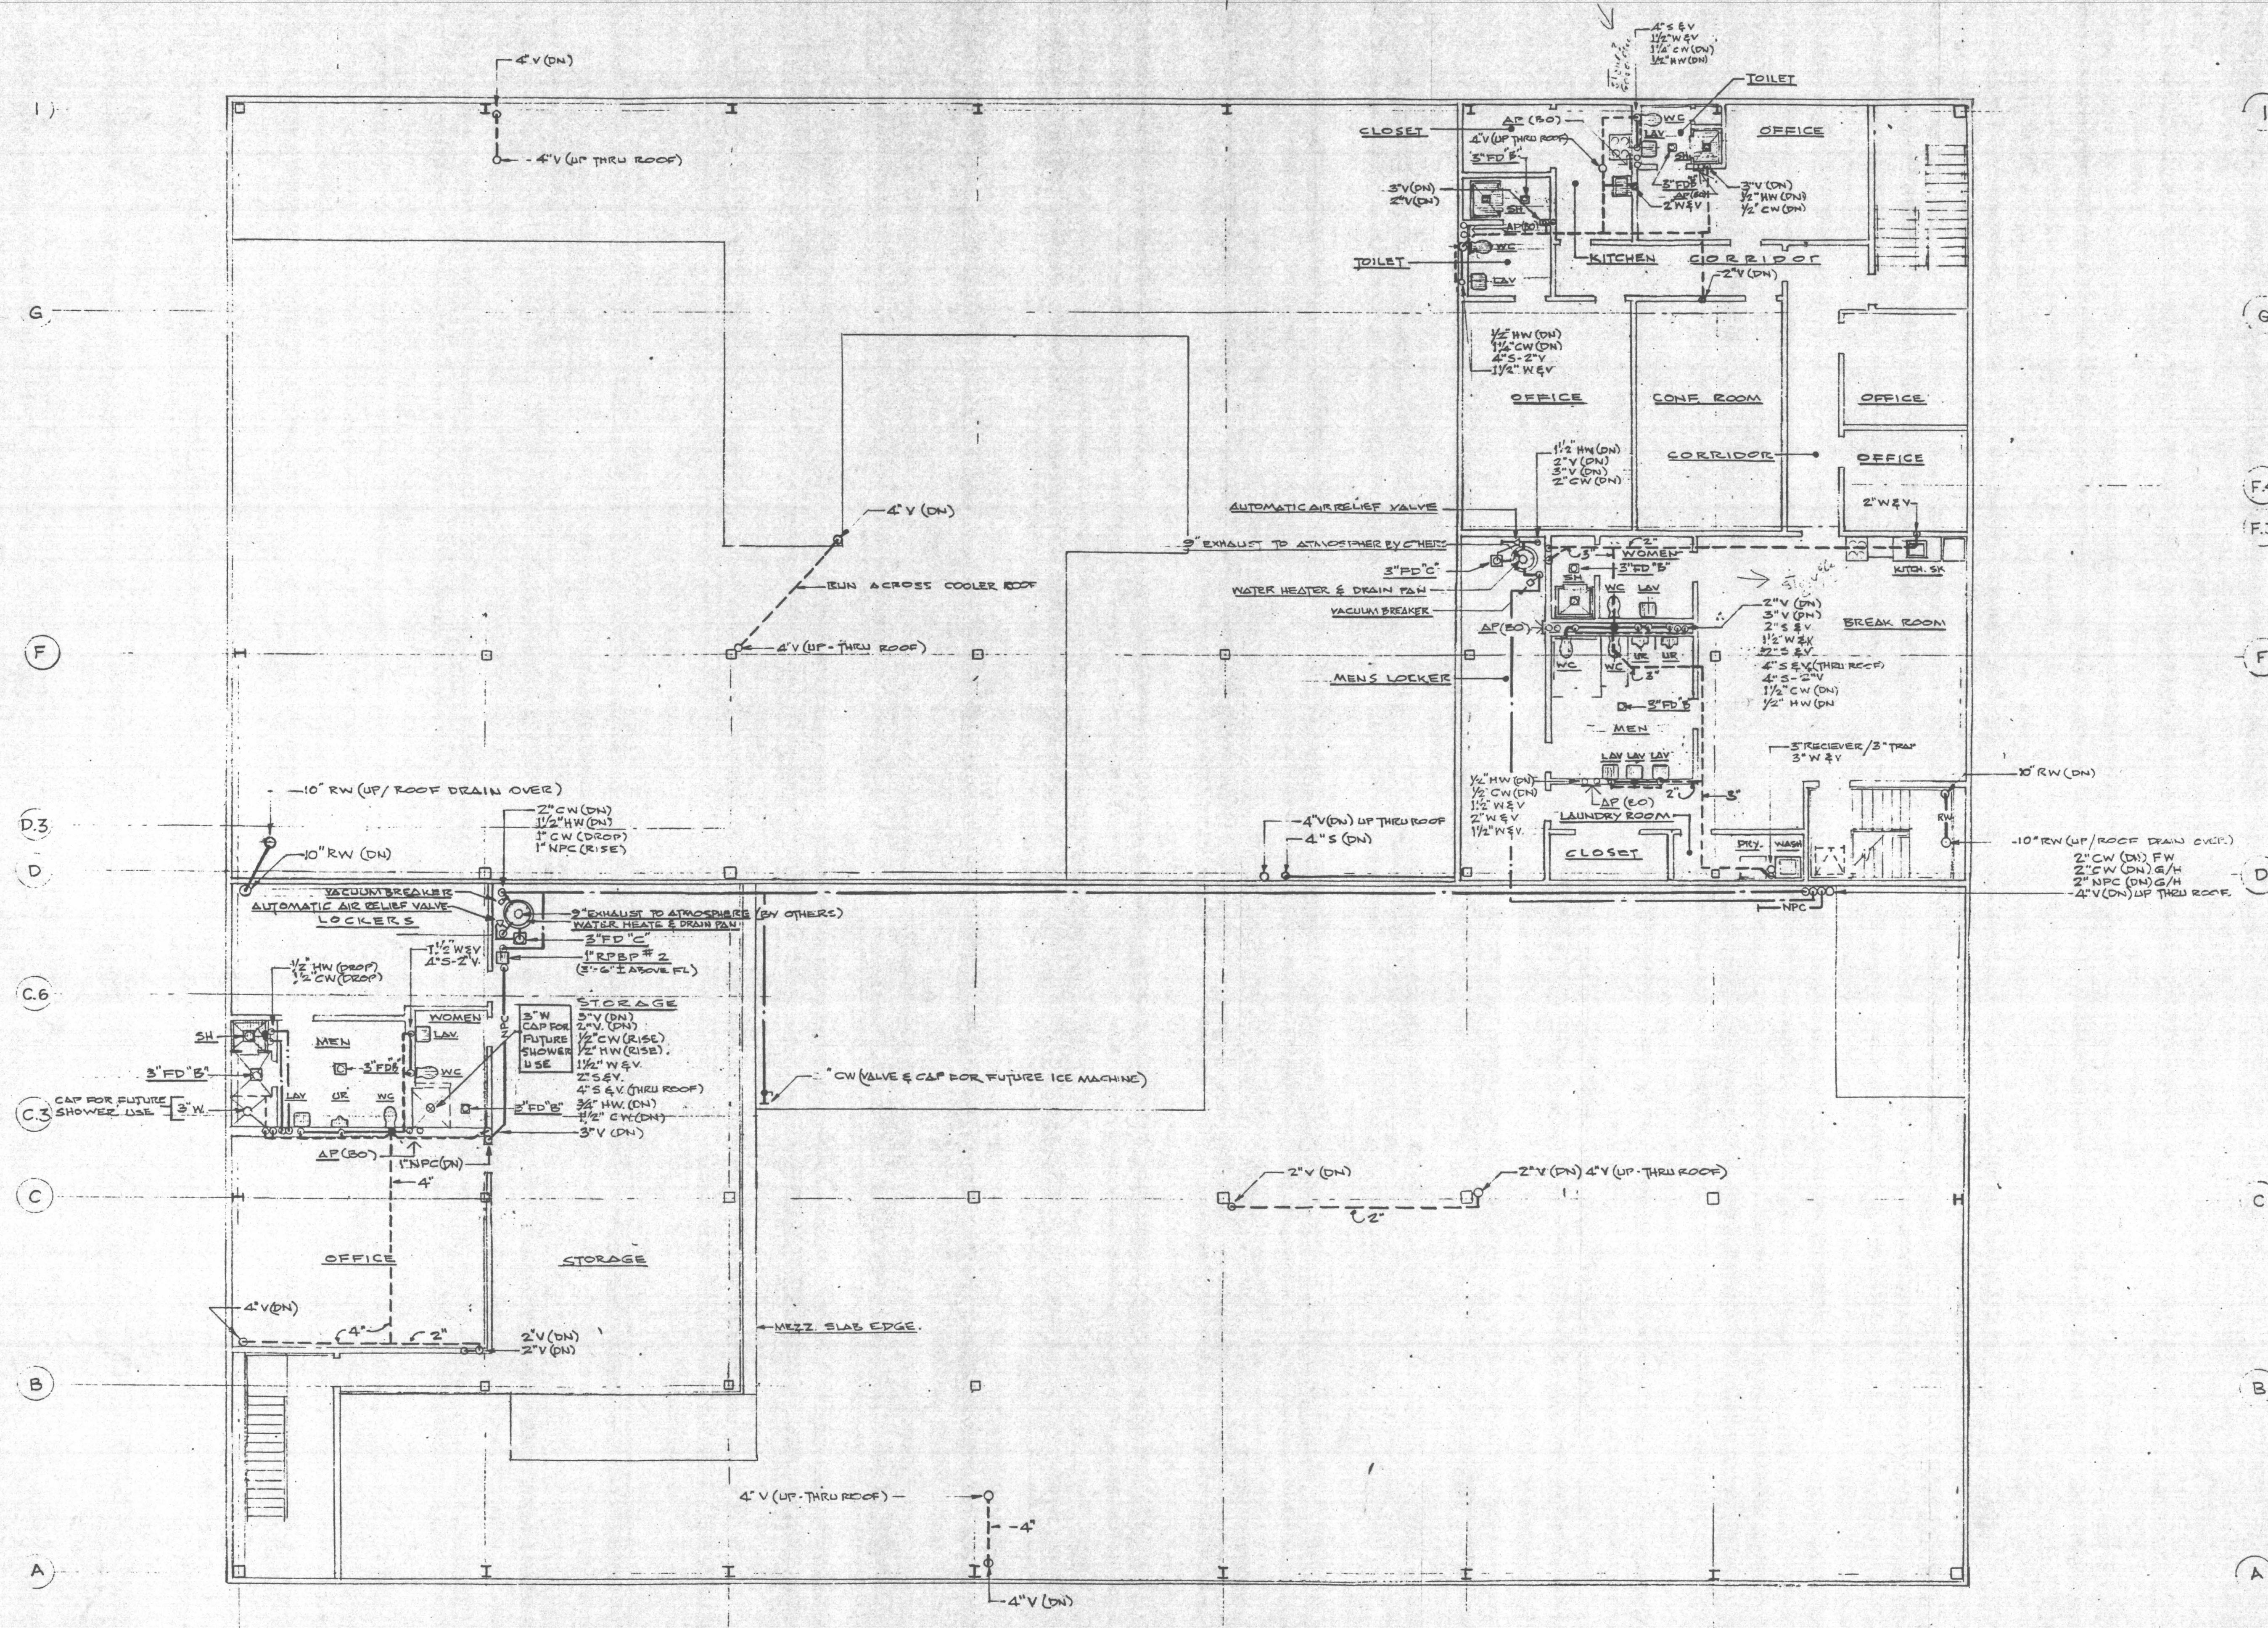

MEZZANINE FLOOR PLAN
BUILDING #1
SCALE: 1/8" = 1'-0"

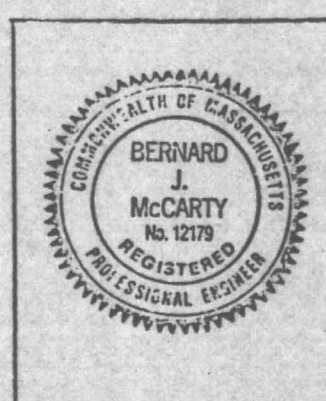

It shall be understood by all concerned that the above registration stamp acknowledges an engineered design for Phase I of this "Design Build" project.

NEW BOSTON SEAFOOD
EDIC'S MARINE INDUSTRIAL PARK
SOUTH BOSTON, MA

As-Built

10-22-97
~~6-11-97~~
~~5-5-97~~
~~4-2-97~~
PRELIMINARY ~~2-25-97~~

J.F. CHINE MECHANICAL, INC.