


OWNER:
V. CASSEL ADAMSON, JR.
6510 THREE CHOPT RD.
RICHMOND, VA 23233

THE CROZET HOUSE
100 E. MAIN ST.
RICHMOND, VIRGINIA 23219


DATE: DECEMBER 1997

6

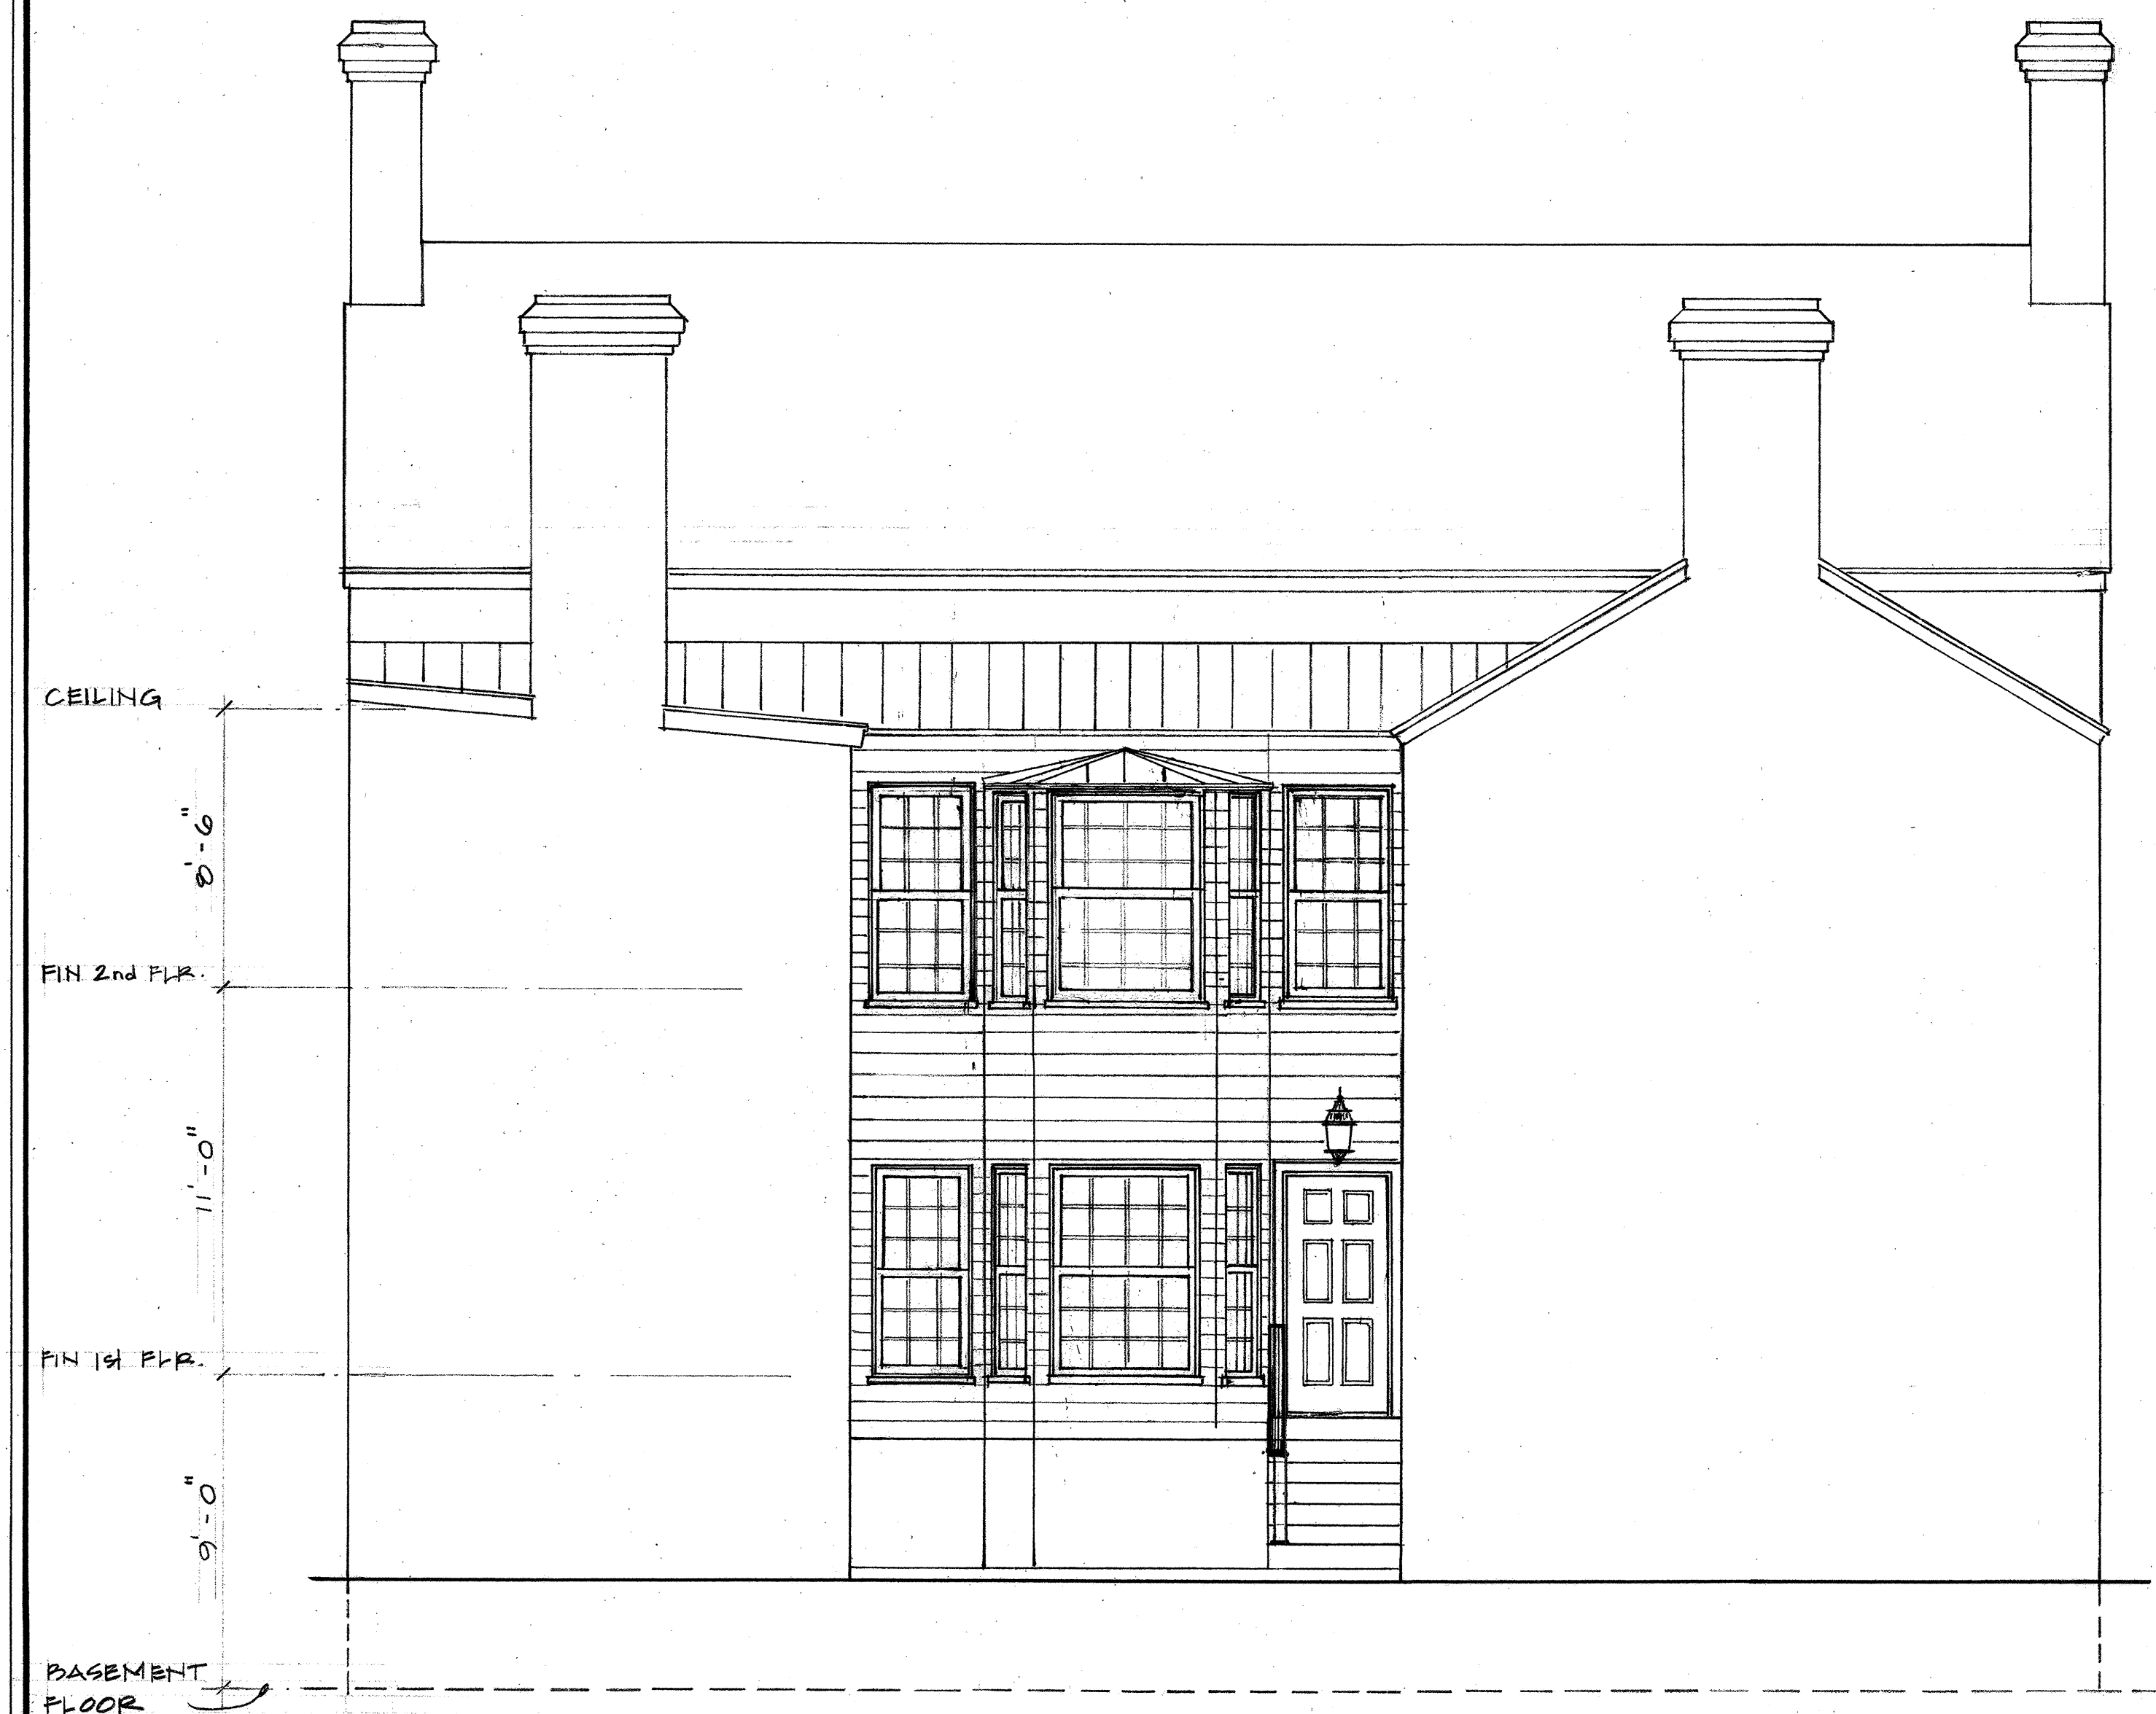

north elevation

SCALE: 1/4" = 1'-0"

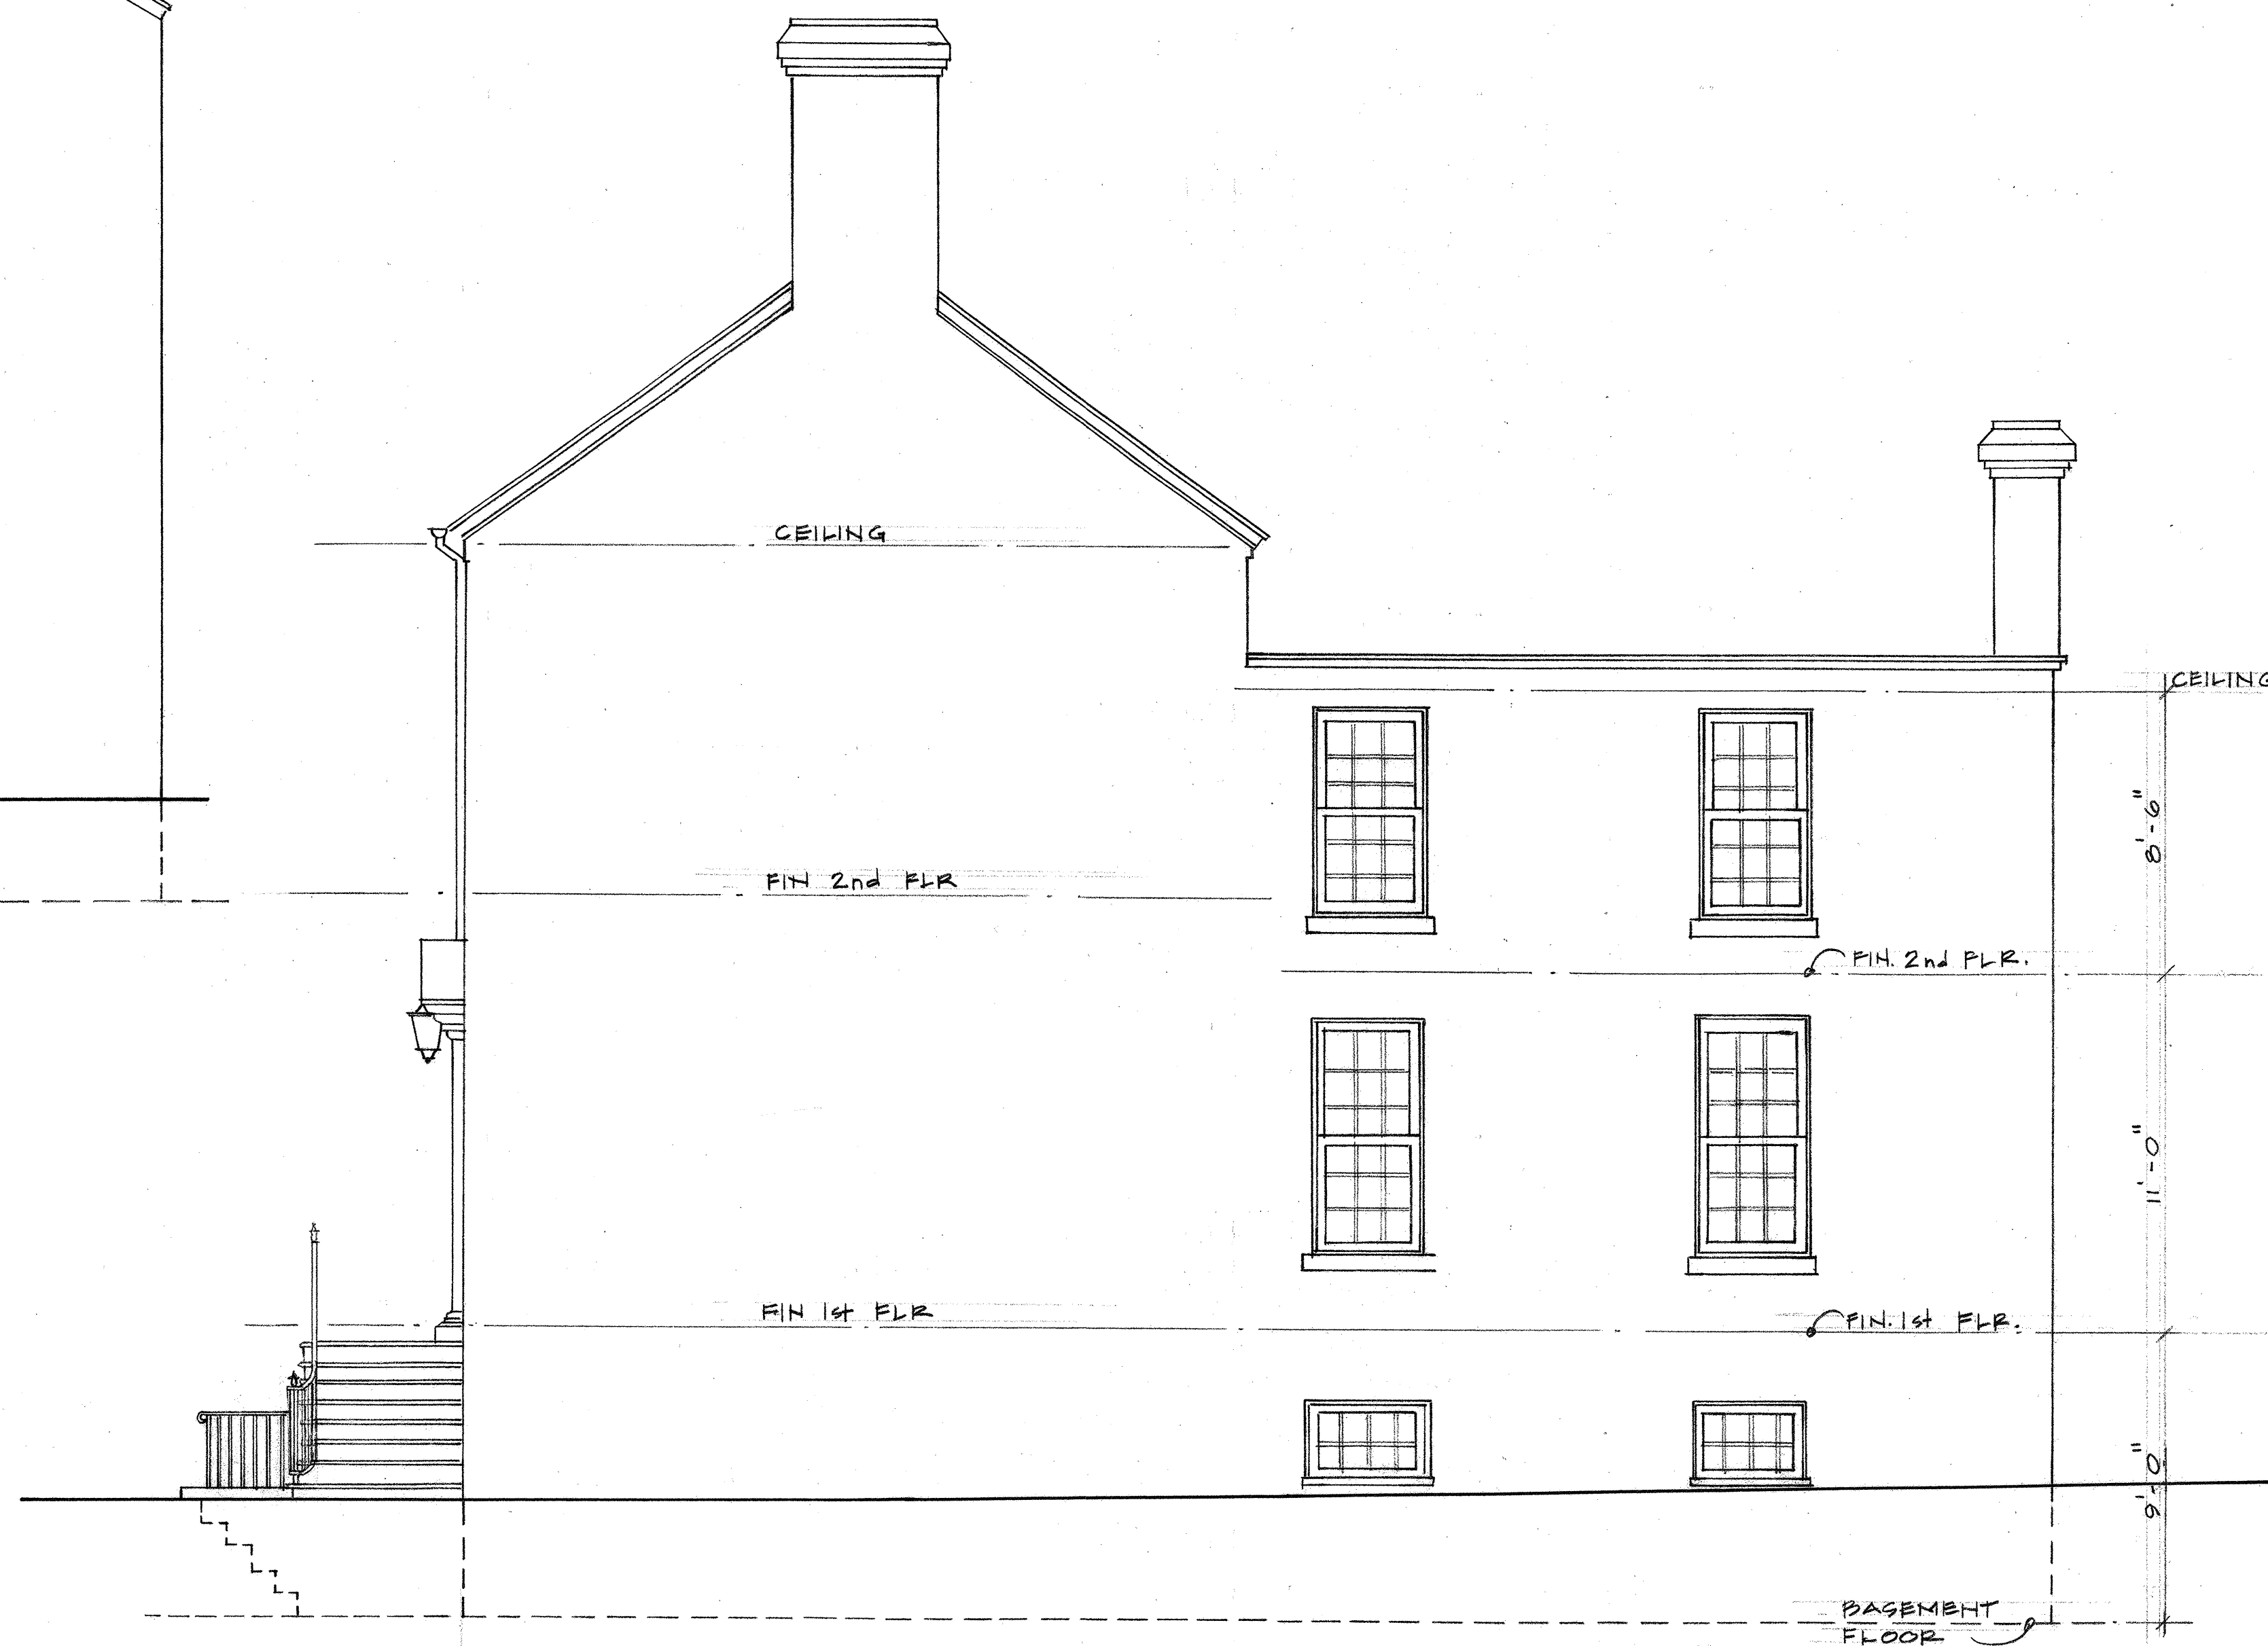

east elevation

SCALE: 1/4" = 1'-0"

as-built drawings