


- 32,000 SF
- 8,000 SF
- 87,200 SF
- 49,407 SF
- 6,500 SF

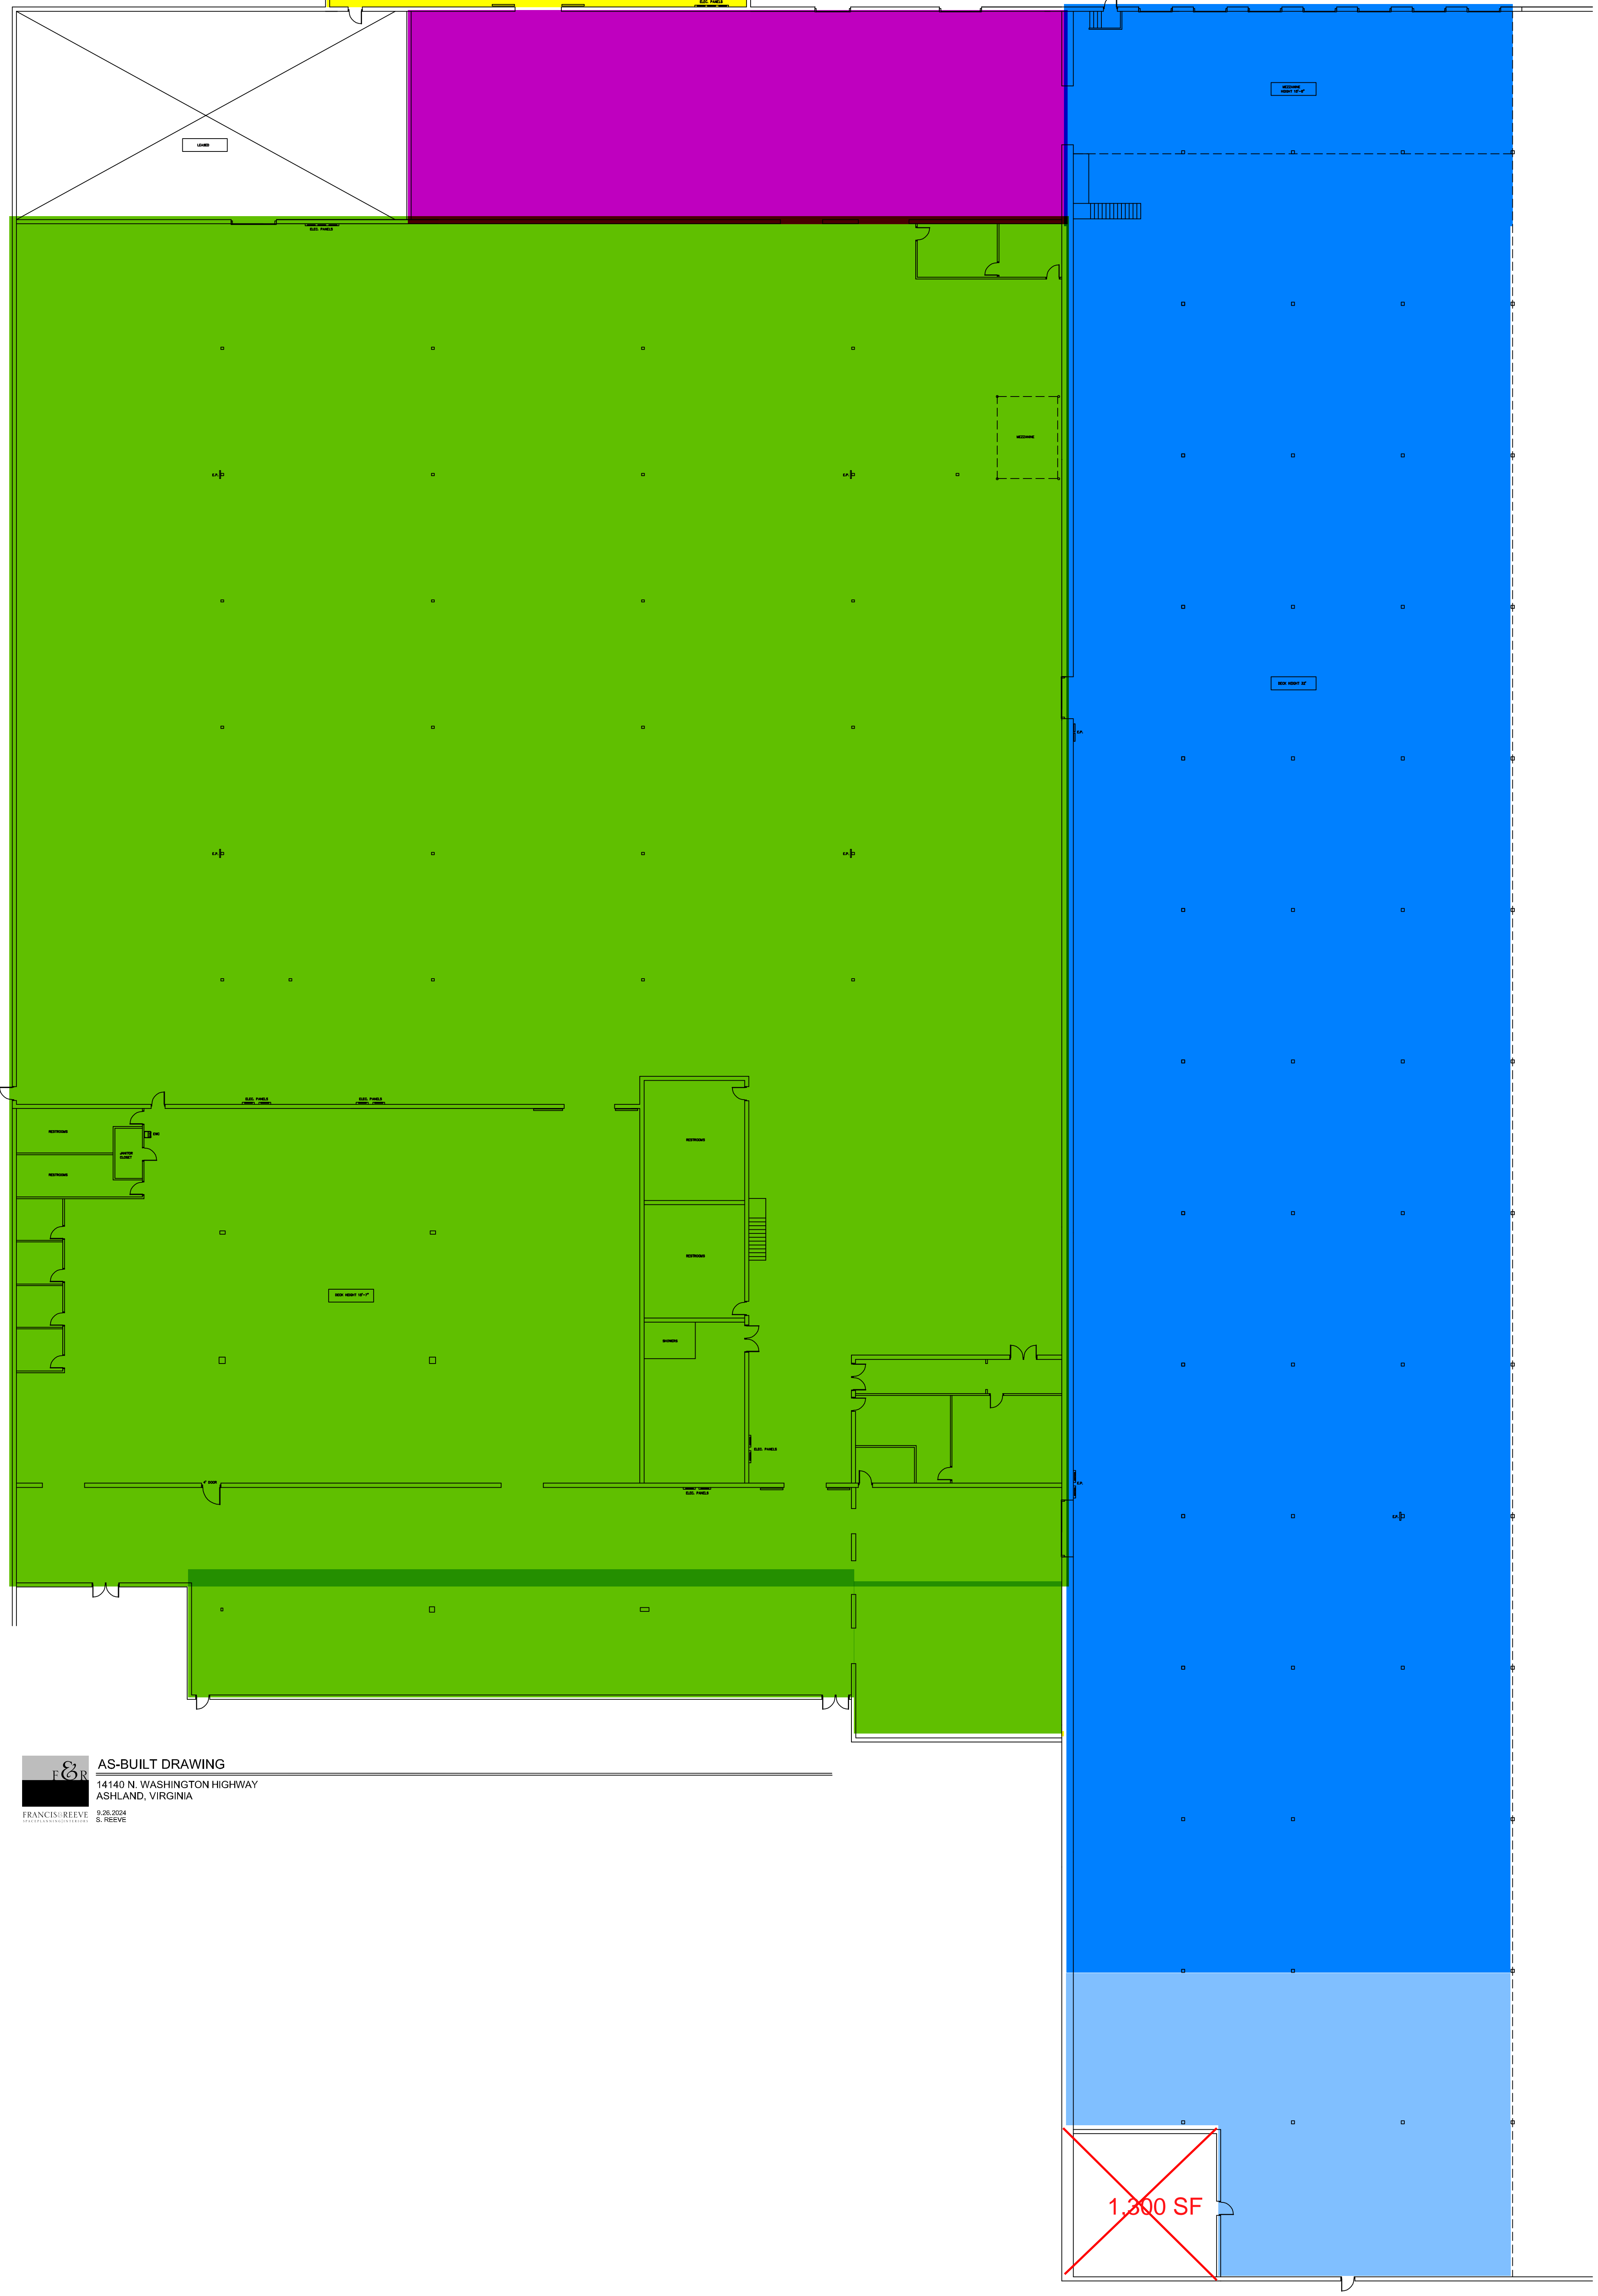

AS-BUILT DRAWING  
14140 N. WASHINGTON HIGHWAY  
ASHLAND, VIRGINIA  
FRANCIS REEVE 8/25/2014 8/28/2014

1,300 SF