


SUITE 3310
18' - 3 1/2"

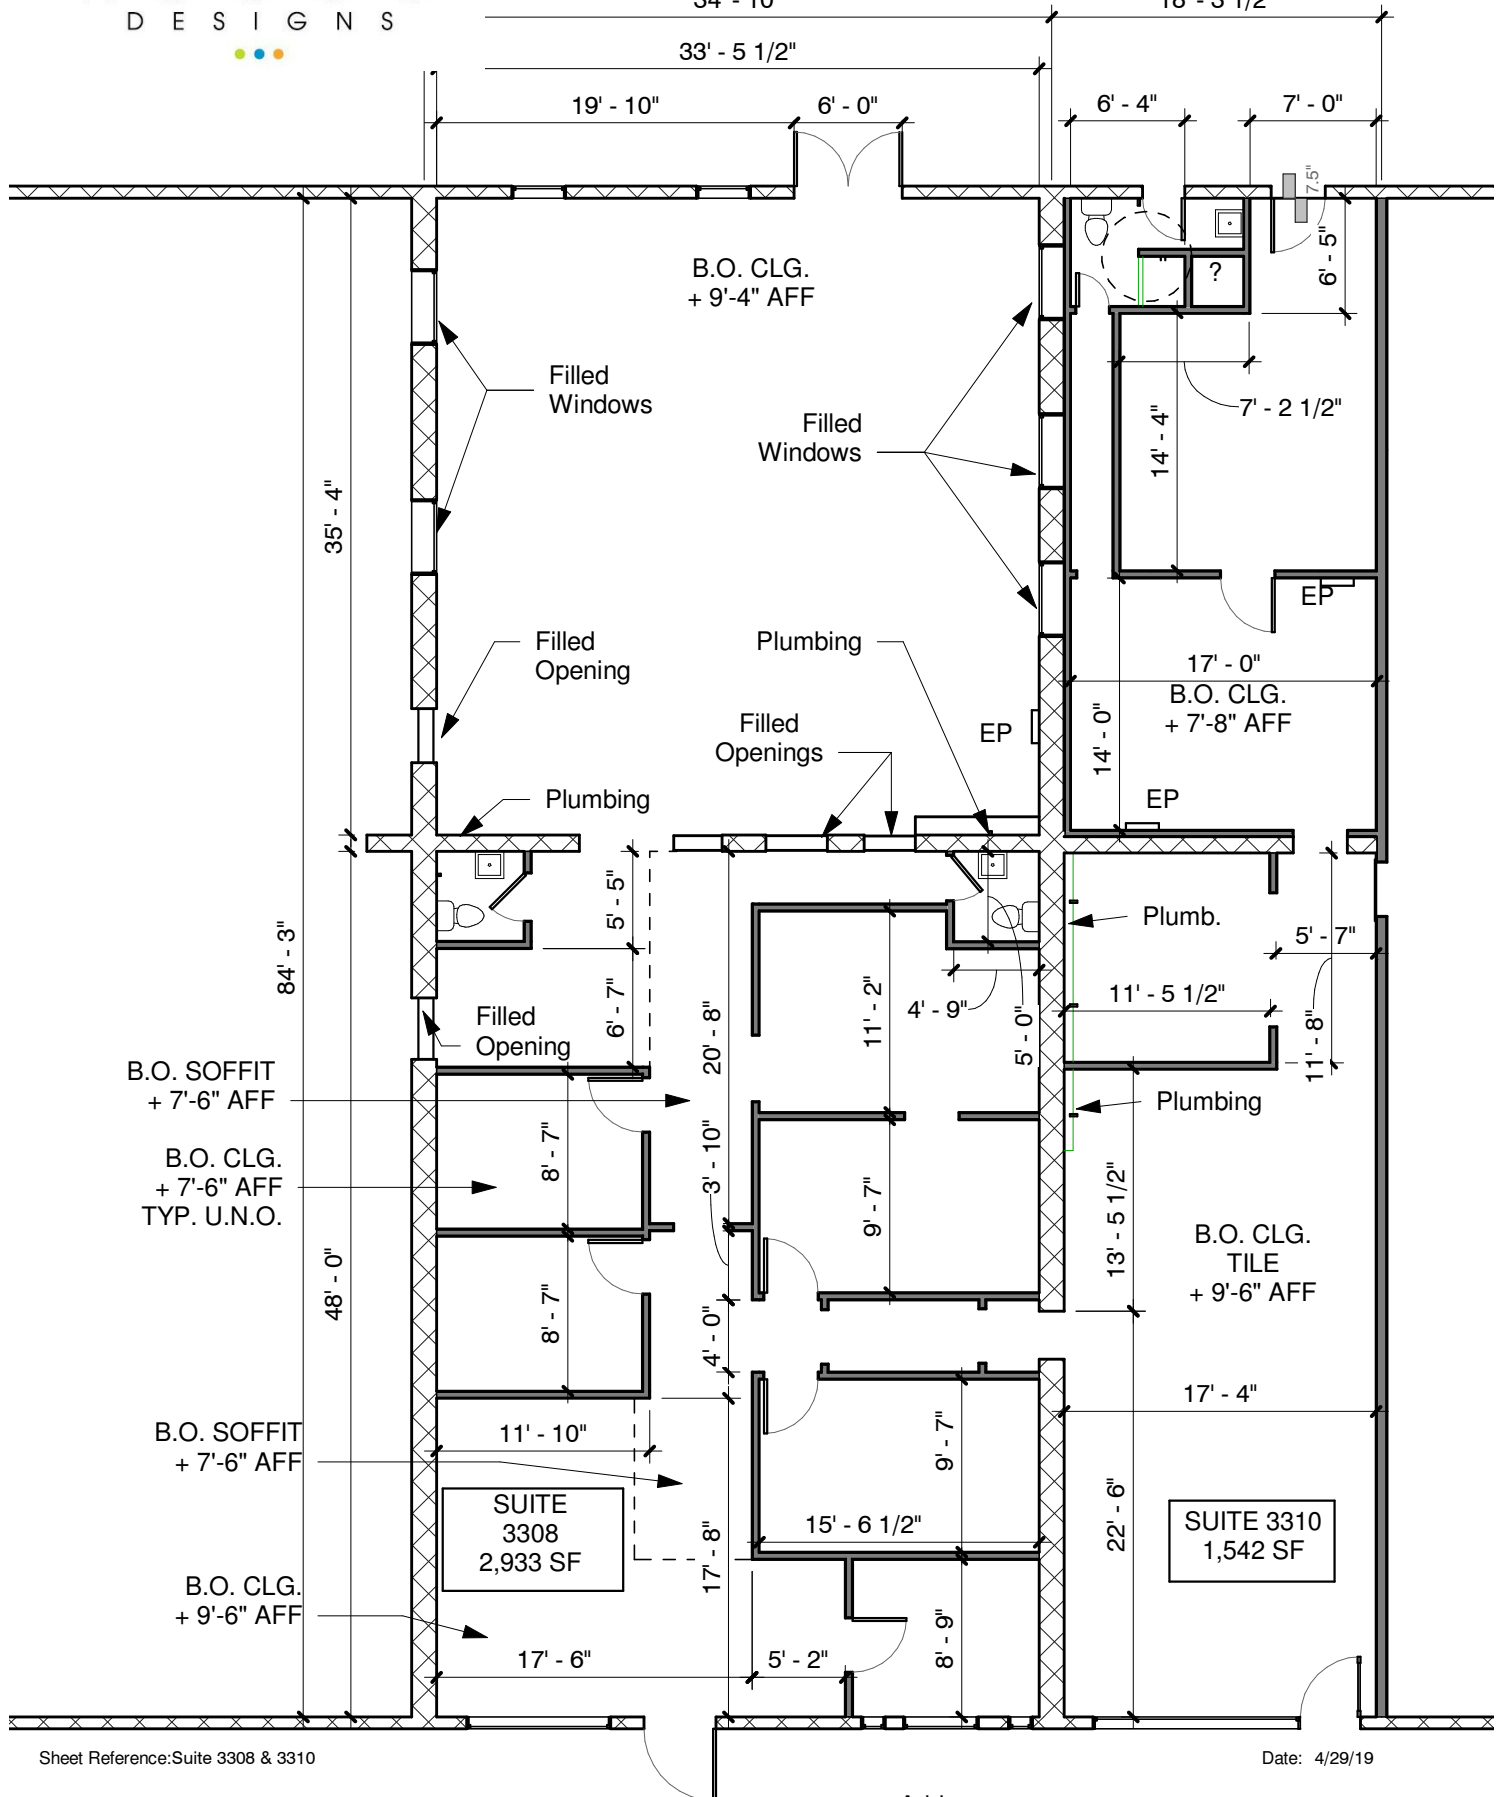

Sheet Reference: Suite 3308 & 3310

Date: 4/29/19

AS-BUILT

FLOOR PLAN - LEXINGTON BLDG. SUITES 3308 & 3310

SCALE = 3/32" = 1'-0"

Address:
MPB REALTY AS-BUILT