
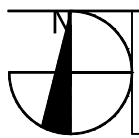


# 3921 East Baseline Road

Gilbert . Arizona

Suite 110 - 2,327 RSF

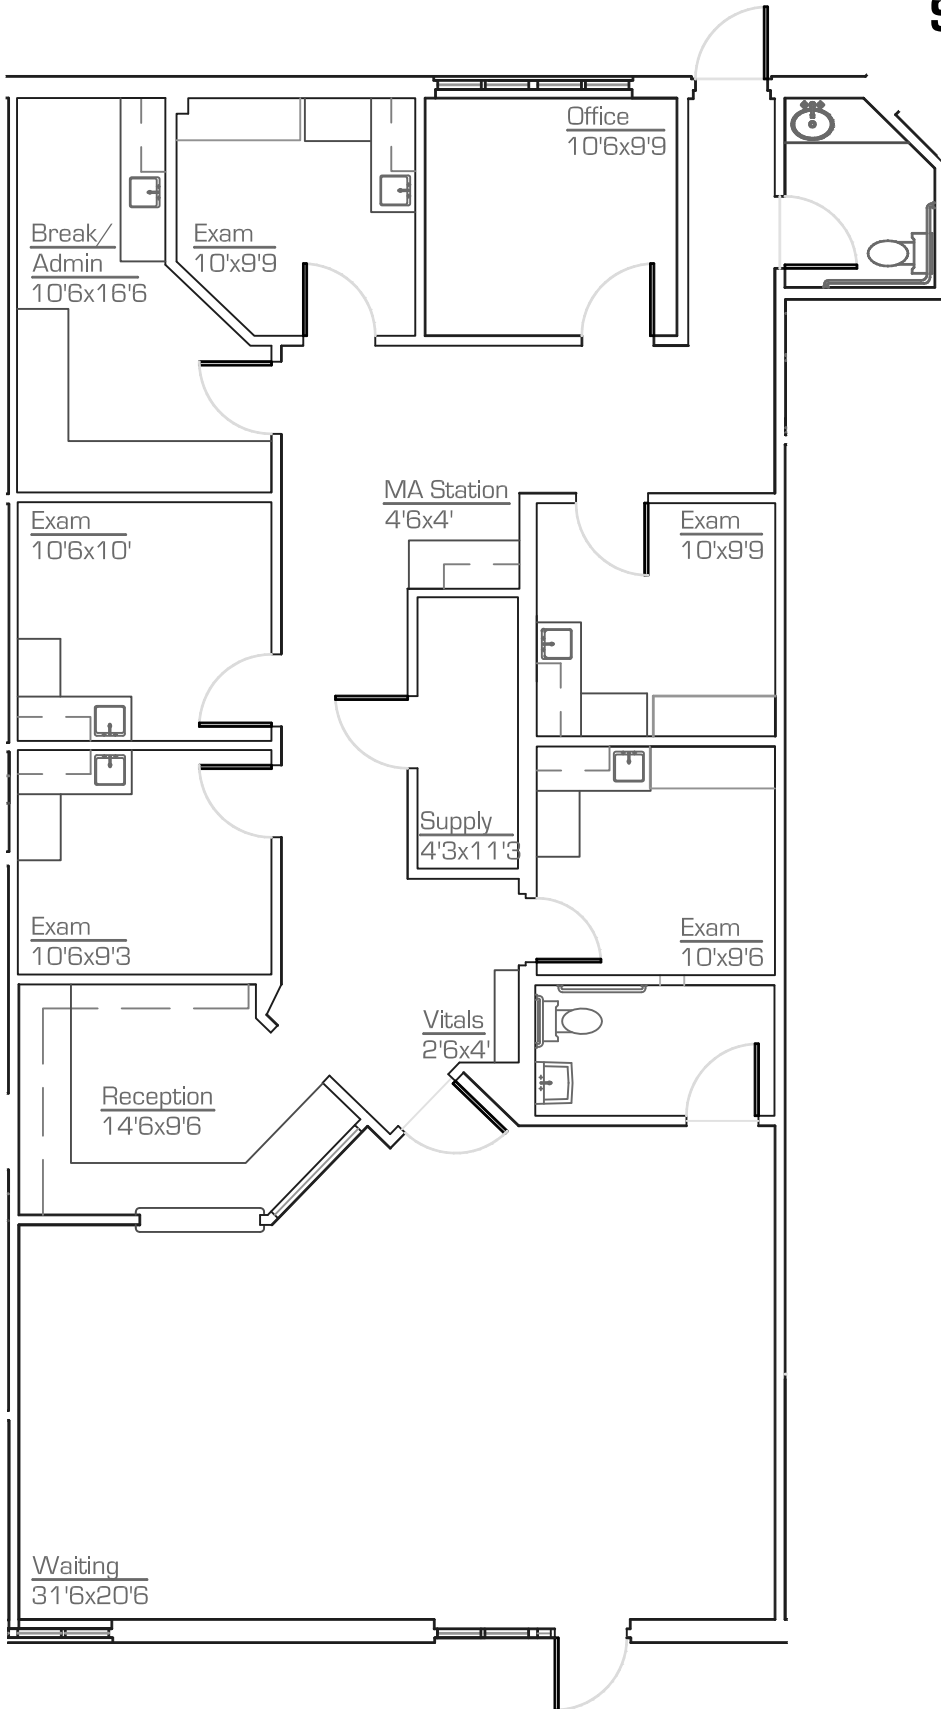

**As-Built**

scale: nts

January.2020

\*All dimensions are approximate at  $\pm 3"$

\*All information is of general nature

precision**DIMENSIONS**

as-built & design  
602. 790. 6412

