

DESERT RIDGE  
MEDICAL CAMPUS  
BUILDING B

# Floor 01

## Suite 120

SPEC SUITE

## 2,264 SF

AVAILABLE



**RACHAEL THOMPSON**  
Senior Vice President  
602.513.5122  
rachael.thompson@kidder.com

**PERRY GABUZZI, CCIM**  
Executive Vice President  
602.513.5116  
perry.gabuzzi@kidder.com



View Portfolio

DESERT RIDGE  
MEDICAL CAMPUS  
BUILDING B


## Floor 02

Suite 270

AS-BUILT

3,298 SF

AVAILABLE

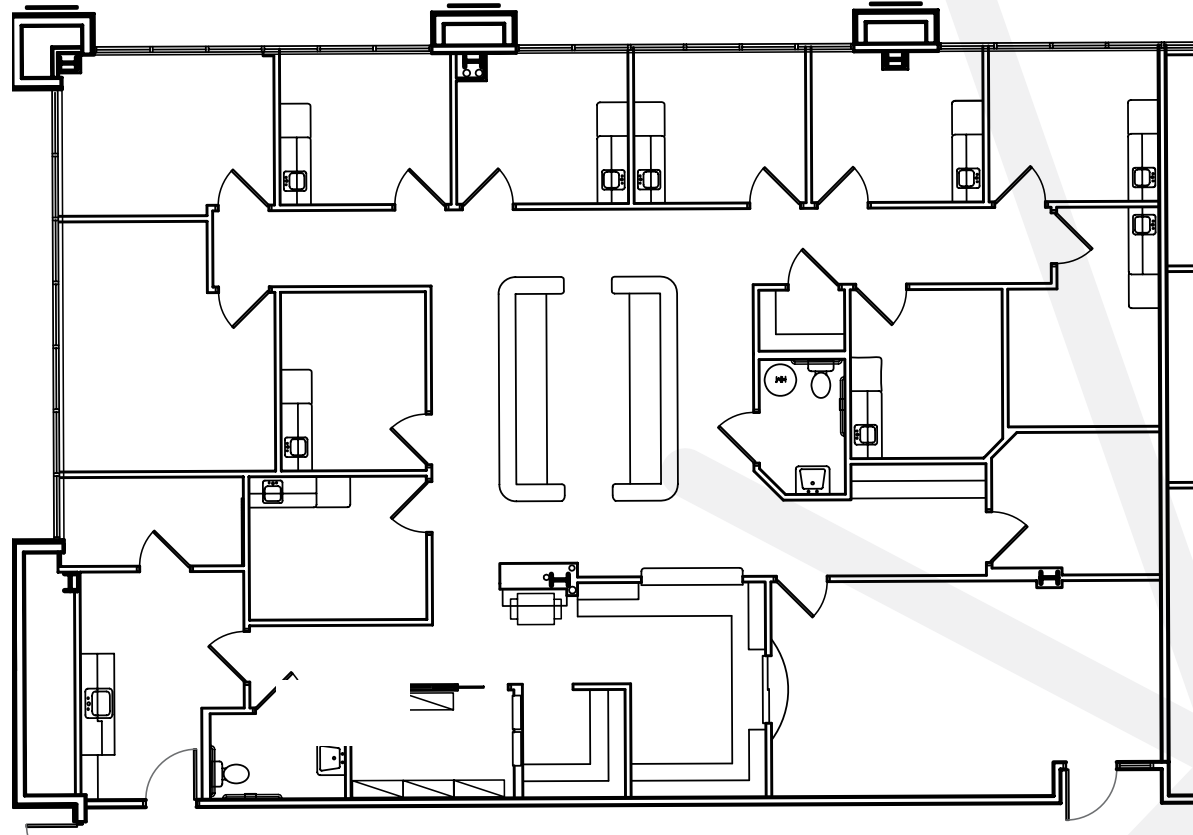

**RACHAEL THOMPSON**  
Senior Vice President  
602.513.5122  
rachael.thompson@kidder.com

**PERRY GABUZZI, CCIM**  
Executive Vice President  
602.513.5116  
perry.gabuzzi@kidder.com



View Portfolio

DESERT RIDGE  
MEDICAL CAMPUS  
BUILDING B


# Floor 03

## Suite 380

TEST FIT

## 2,368 SF

AVAILABLE

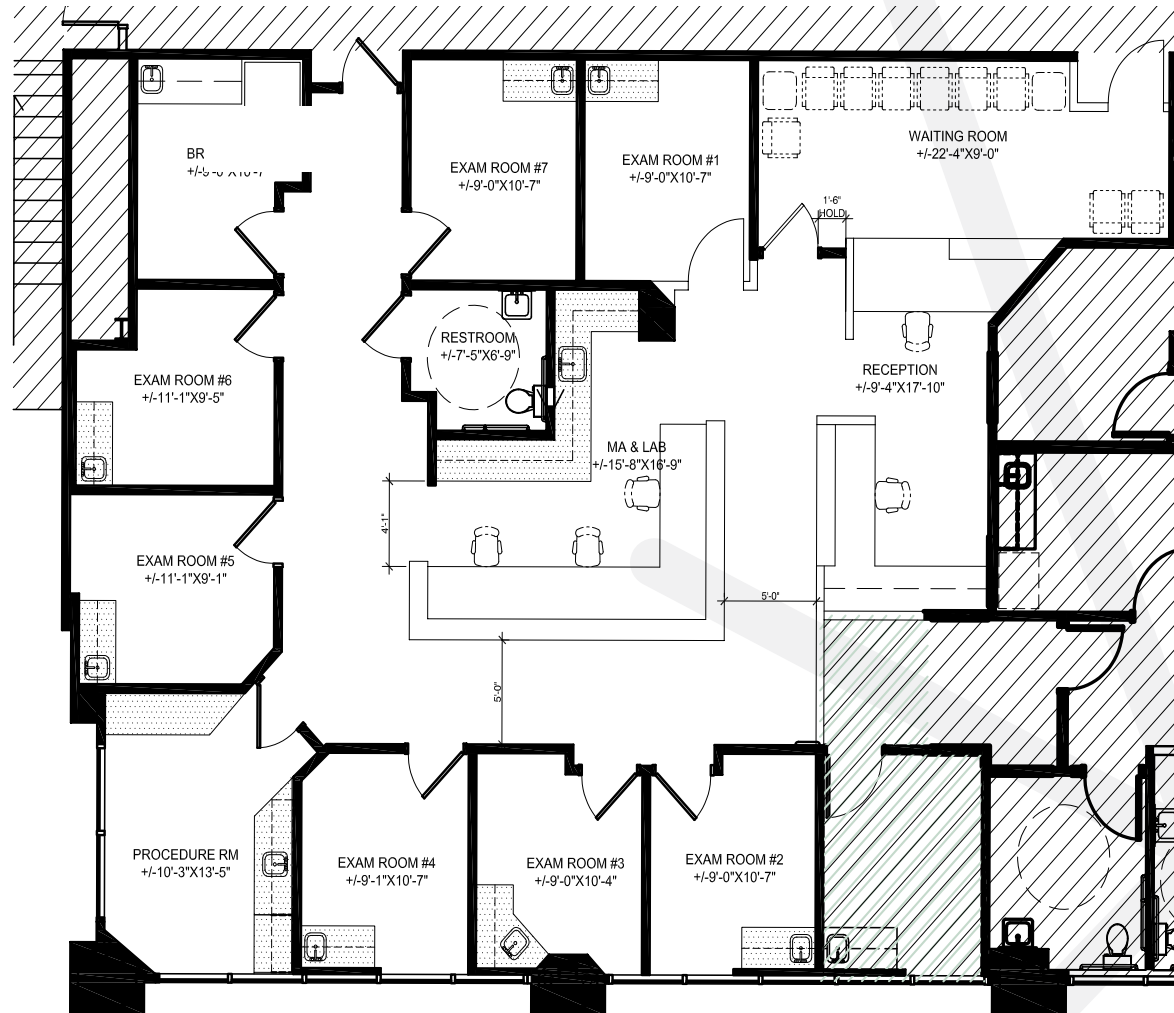

**RACHAEL THOMPSON**  
Senior Vice President  
602.513.5122  
rachael.thompson@kidder.com

**PERRY GABUZZI, CCIM**  
Executive Vice President  
602.513.5116  
perry.gabuzzi@kidder.com



View Portfolio