

LOWER LEVEL AS-BUILT BLOCK PLAN
 ONE SUFFOLK SQUARE
 1601 VETERANS MEMORIAL HWY.
 ISLANDIA, NY 11749

Date: FEBRUARY 5, 2021
 Scale: NOT TO SCALE

Drawing No.:






FIRST FLOOR AS-BUILT BLOCK PLAN
ONE SUFFOLK SQUARE
1601 VETERANS MEMORIAL HWY.
ISLANDIA, NY 11749

Date: FEBRUARY 5, 2021
Scale: NOT TO SCALE

Drawing No.:



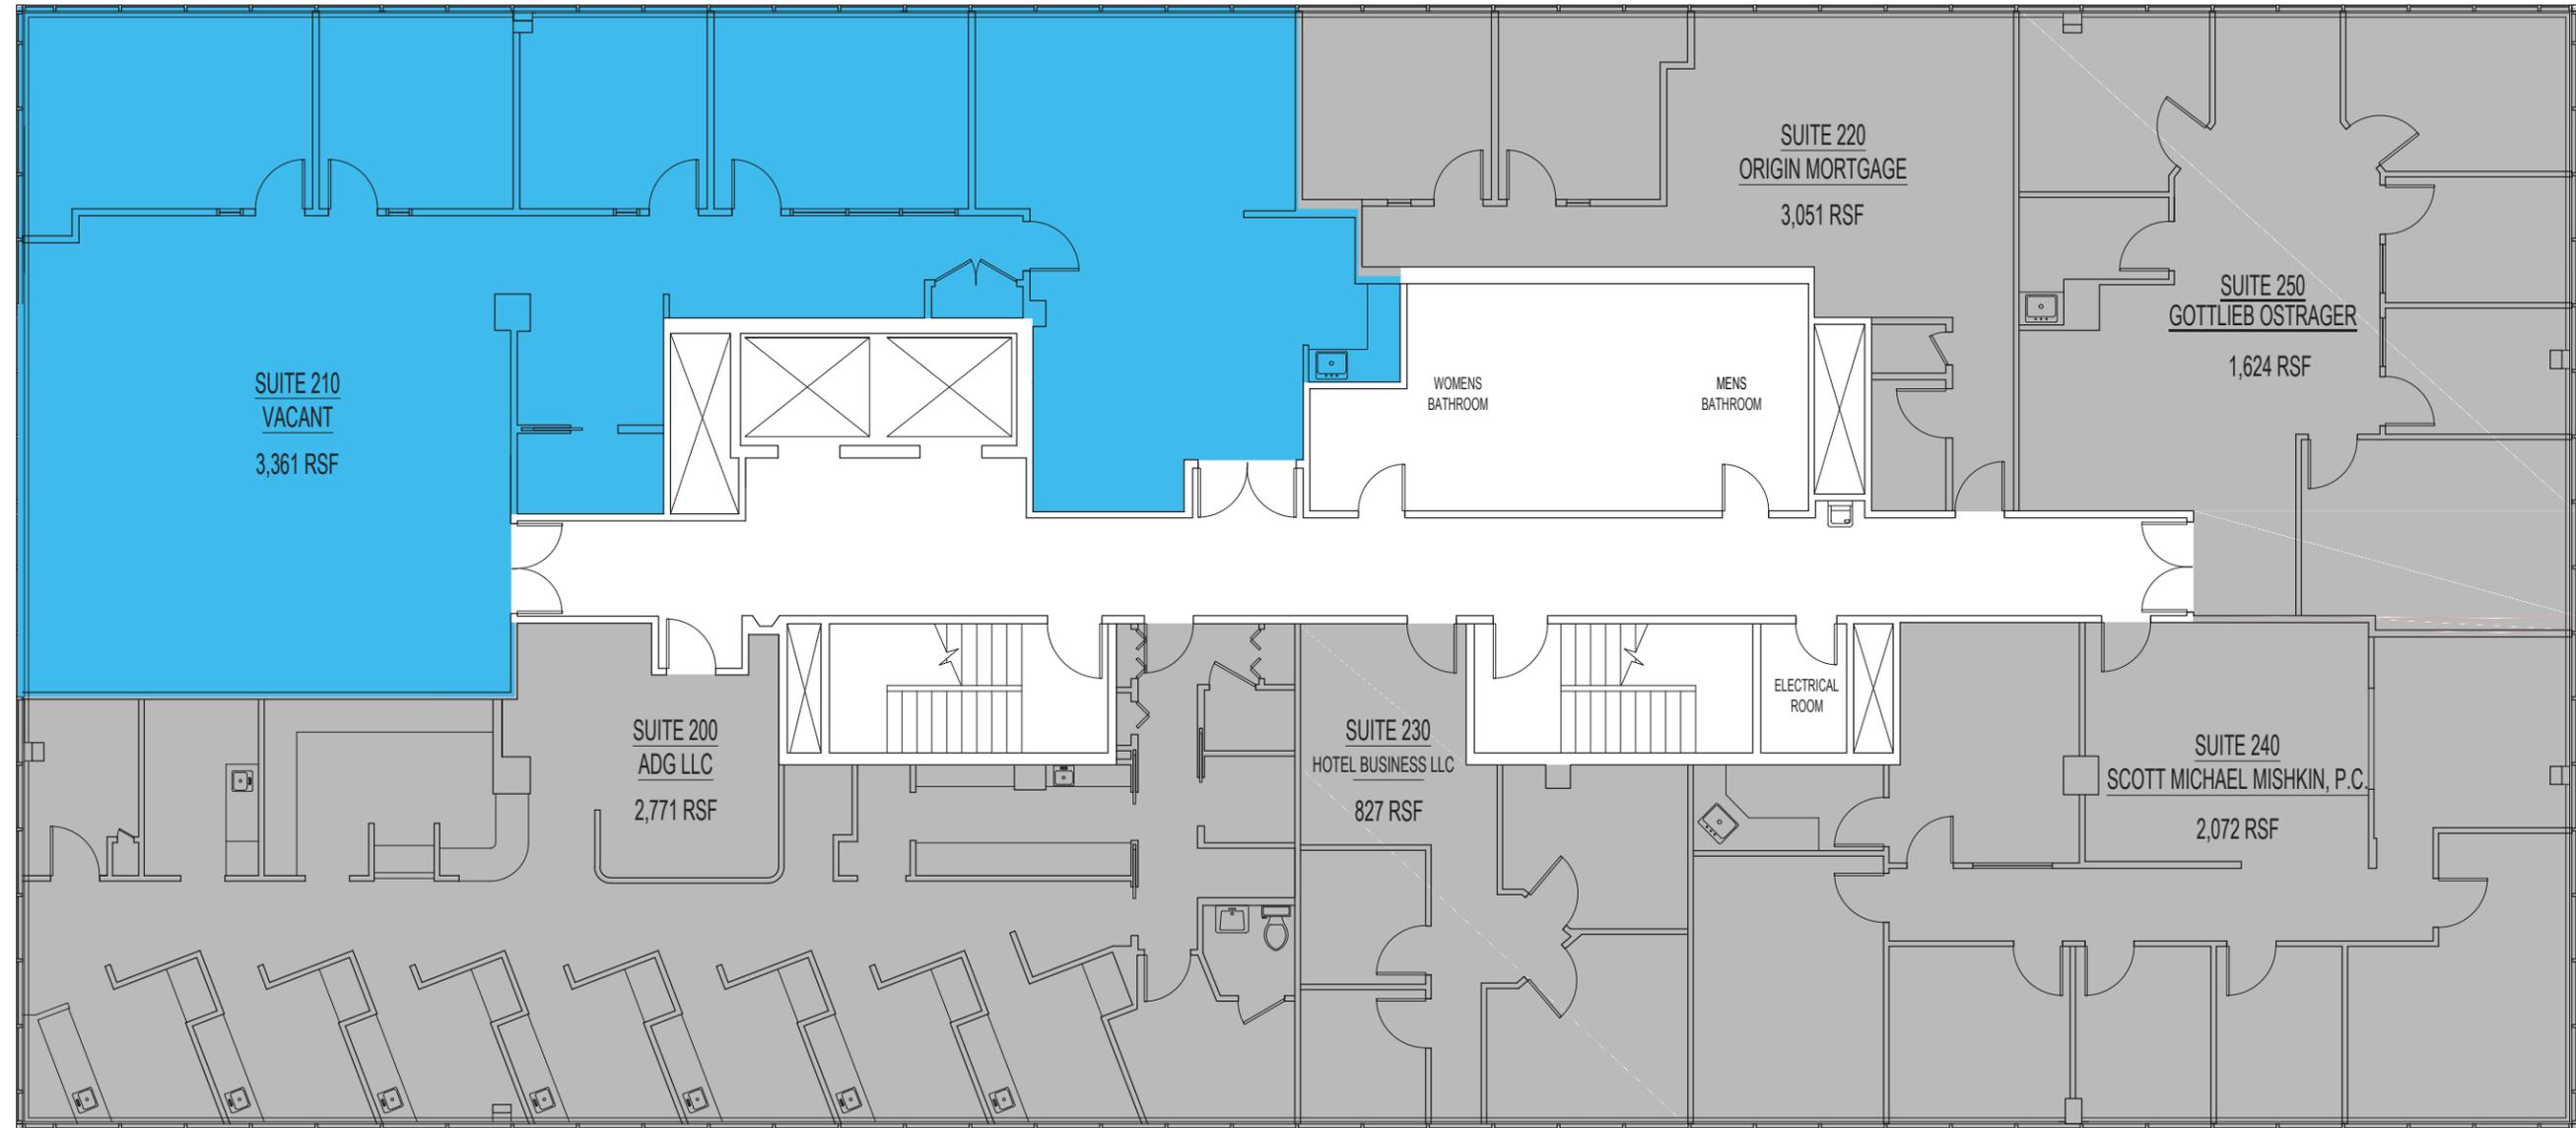


SECOND FLOOR AS-BUILT BLOCK PLAN
 ONE SUFFOLK SQUARE
 1601 VETERANS MEMORIAL HWY.
 ISLANDIA, NY 11749

Date: FEBRUARY 5, 2021
 Scale: NOT TO SCALE

Drawing No.:



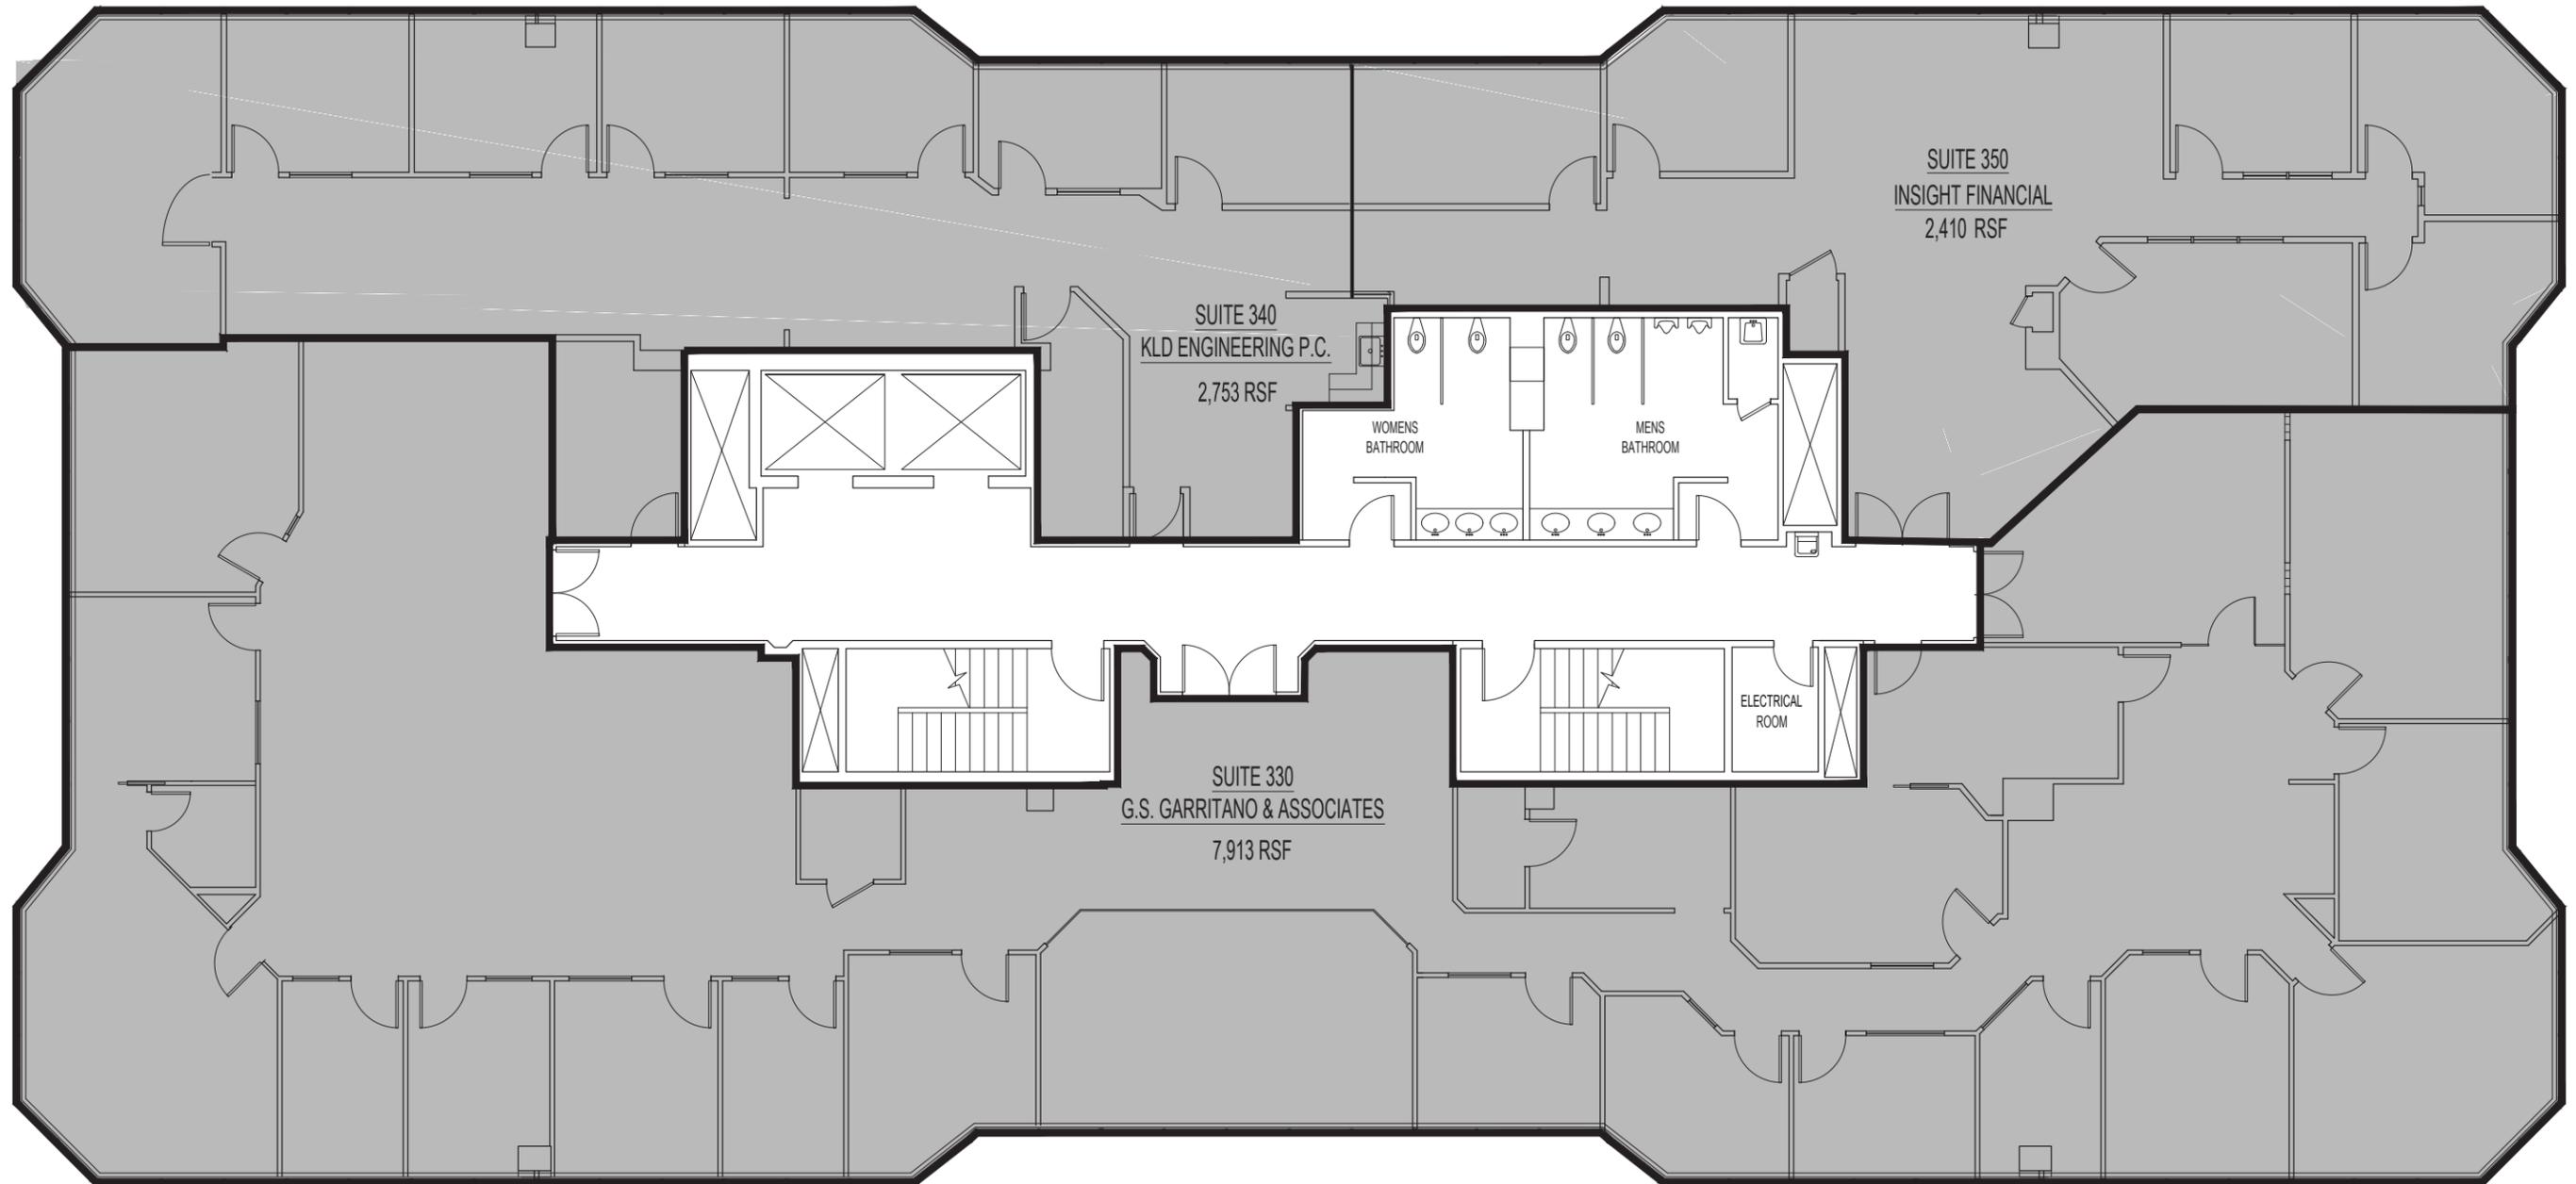


THIRD FLOOR AS-BUILT BLOCK PLAN
ONE SUFFOLK SQUARE
1601 VETERANS MEMORIAL HWY.
ISLANDIA, NY 11749

Date: FEBRUARY 5, 2021
Scale: NOT TO SCALE

Drawing No.:



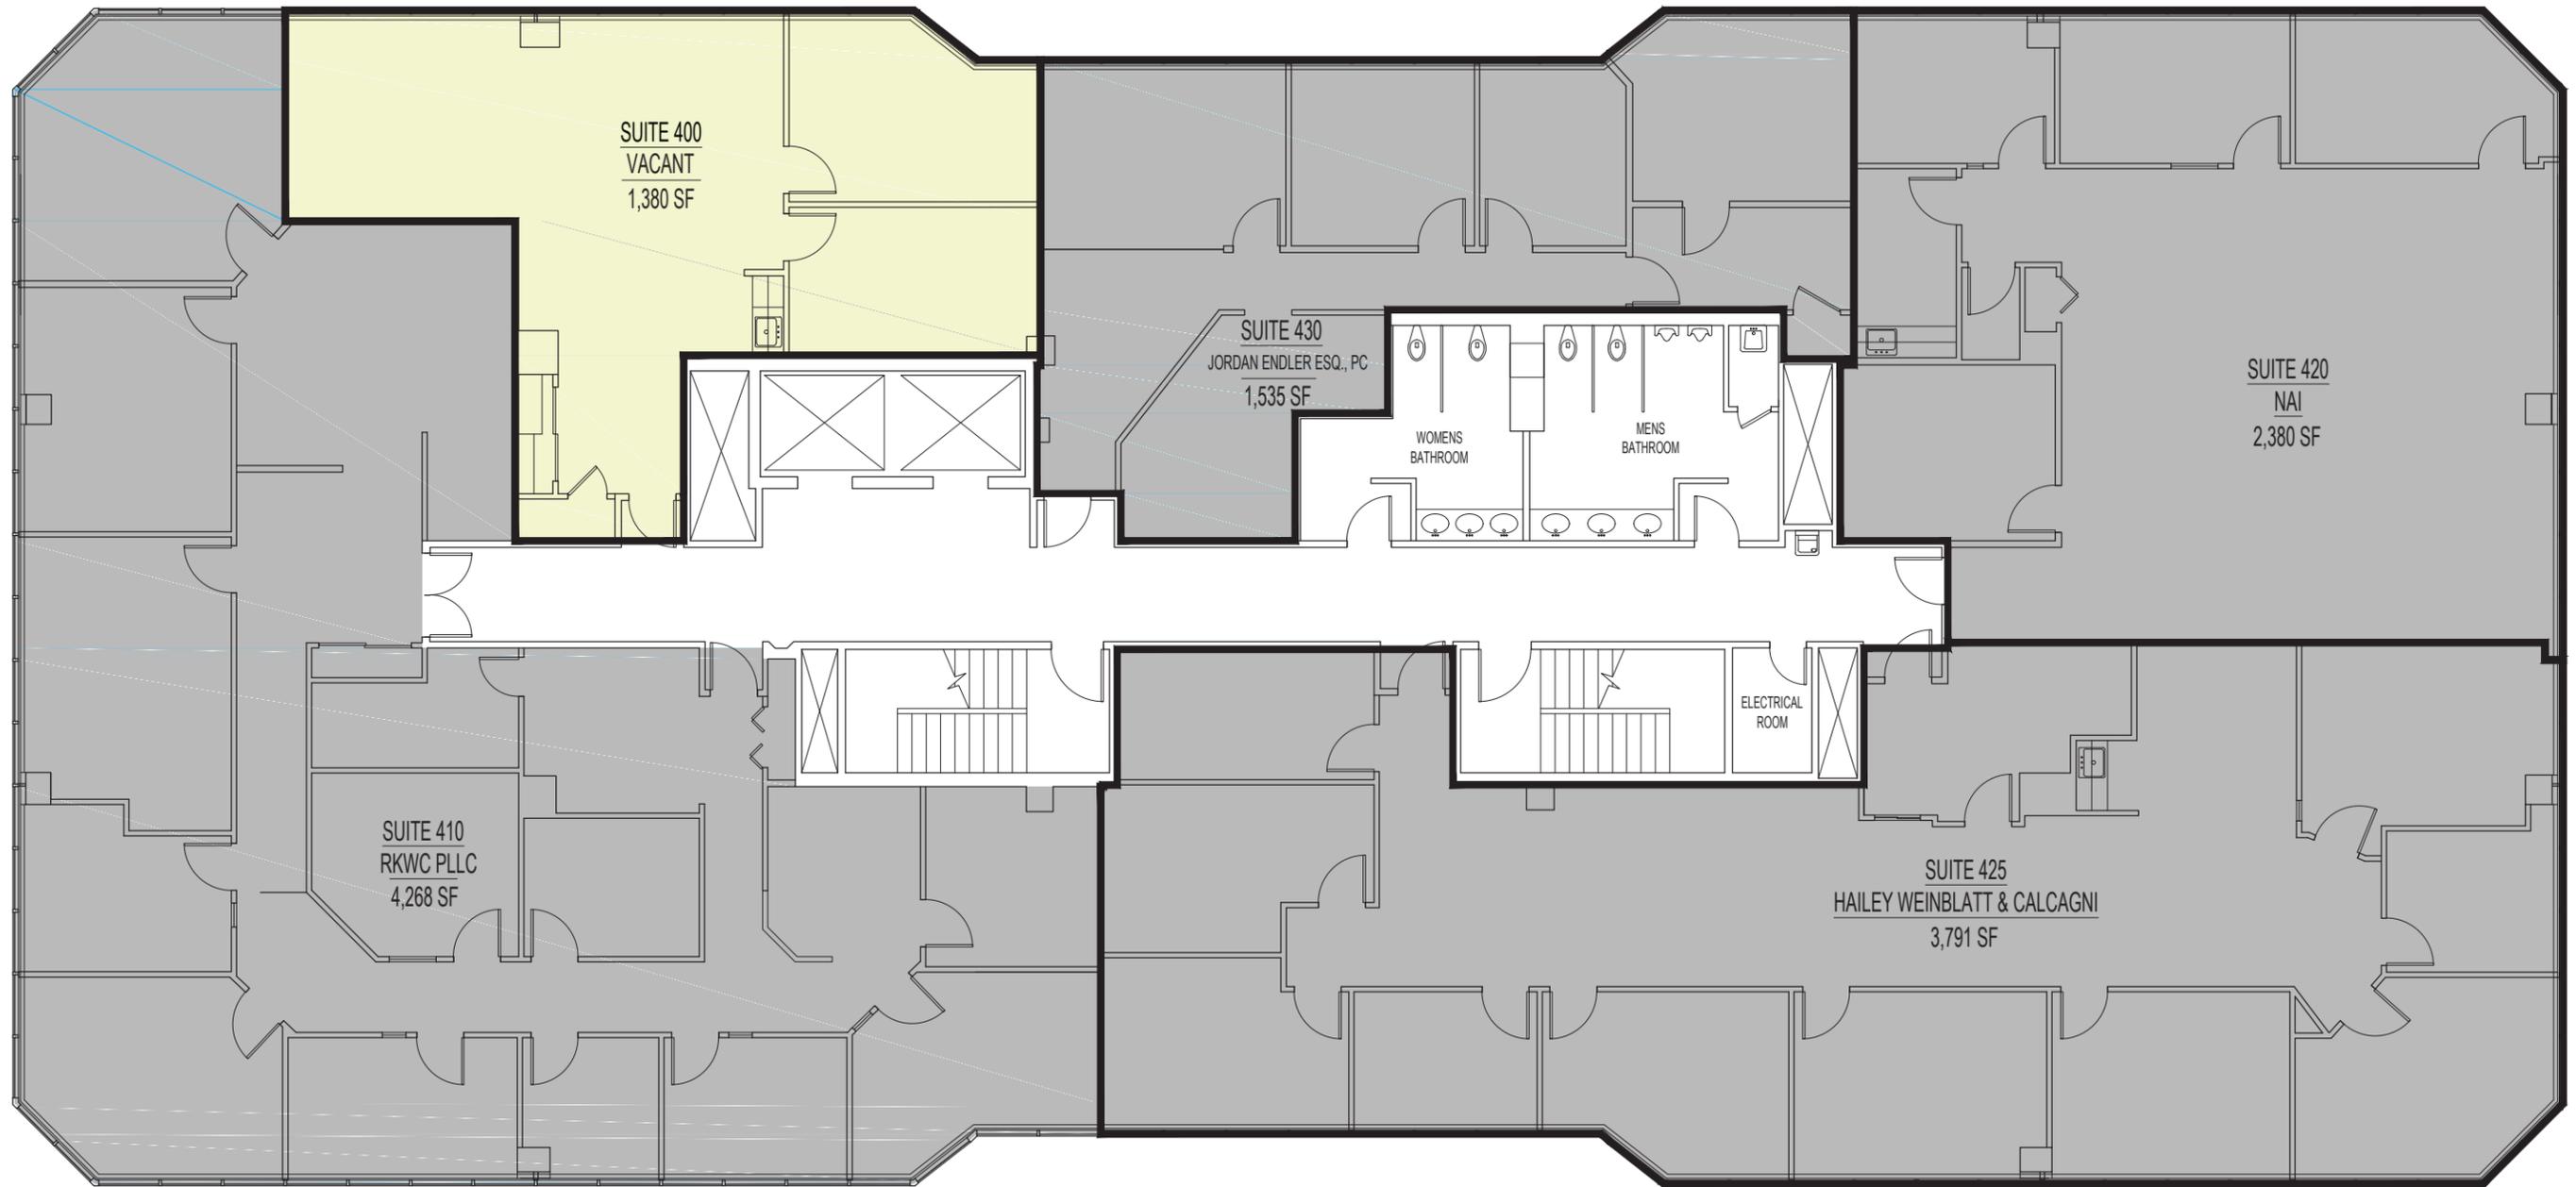


FOURTH FLOOR AS-BUILT BLOCK PLAN
ONE SUFFOLK SQUARE
1601 VETERANS MEMORIAL HWY.
ISLANDIA, NY 11749

Date: FEBRUARY 5, 2021
Scale: NOT TO SCALE

Drawing No.:

P-1

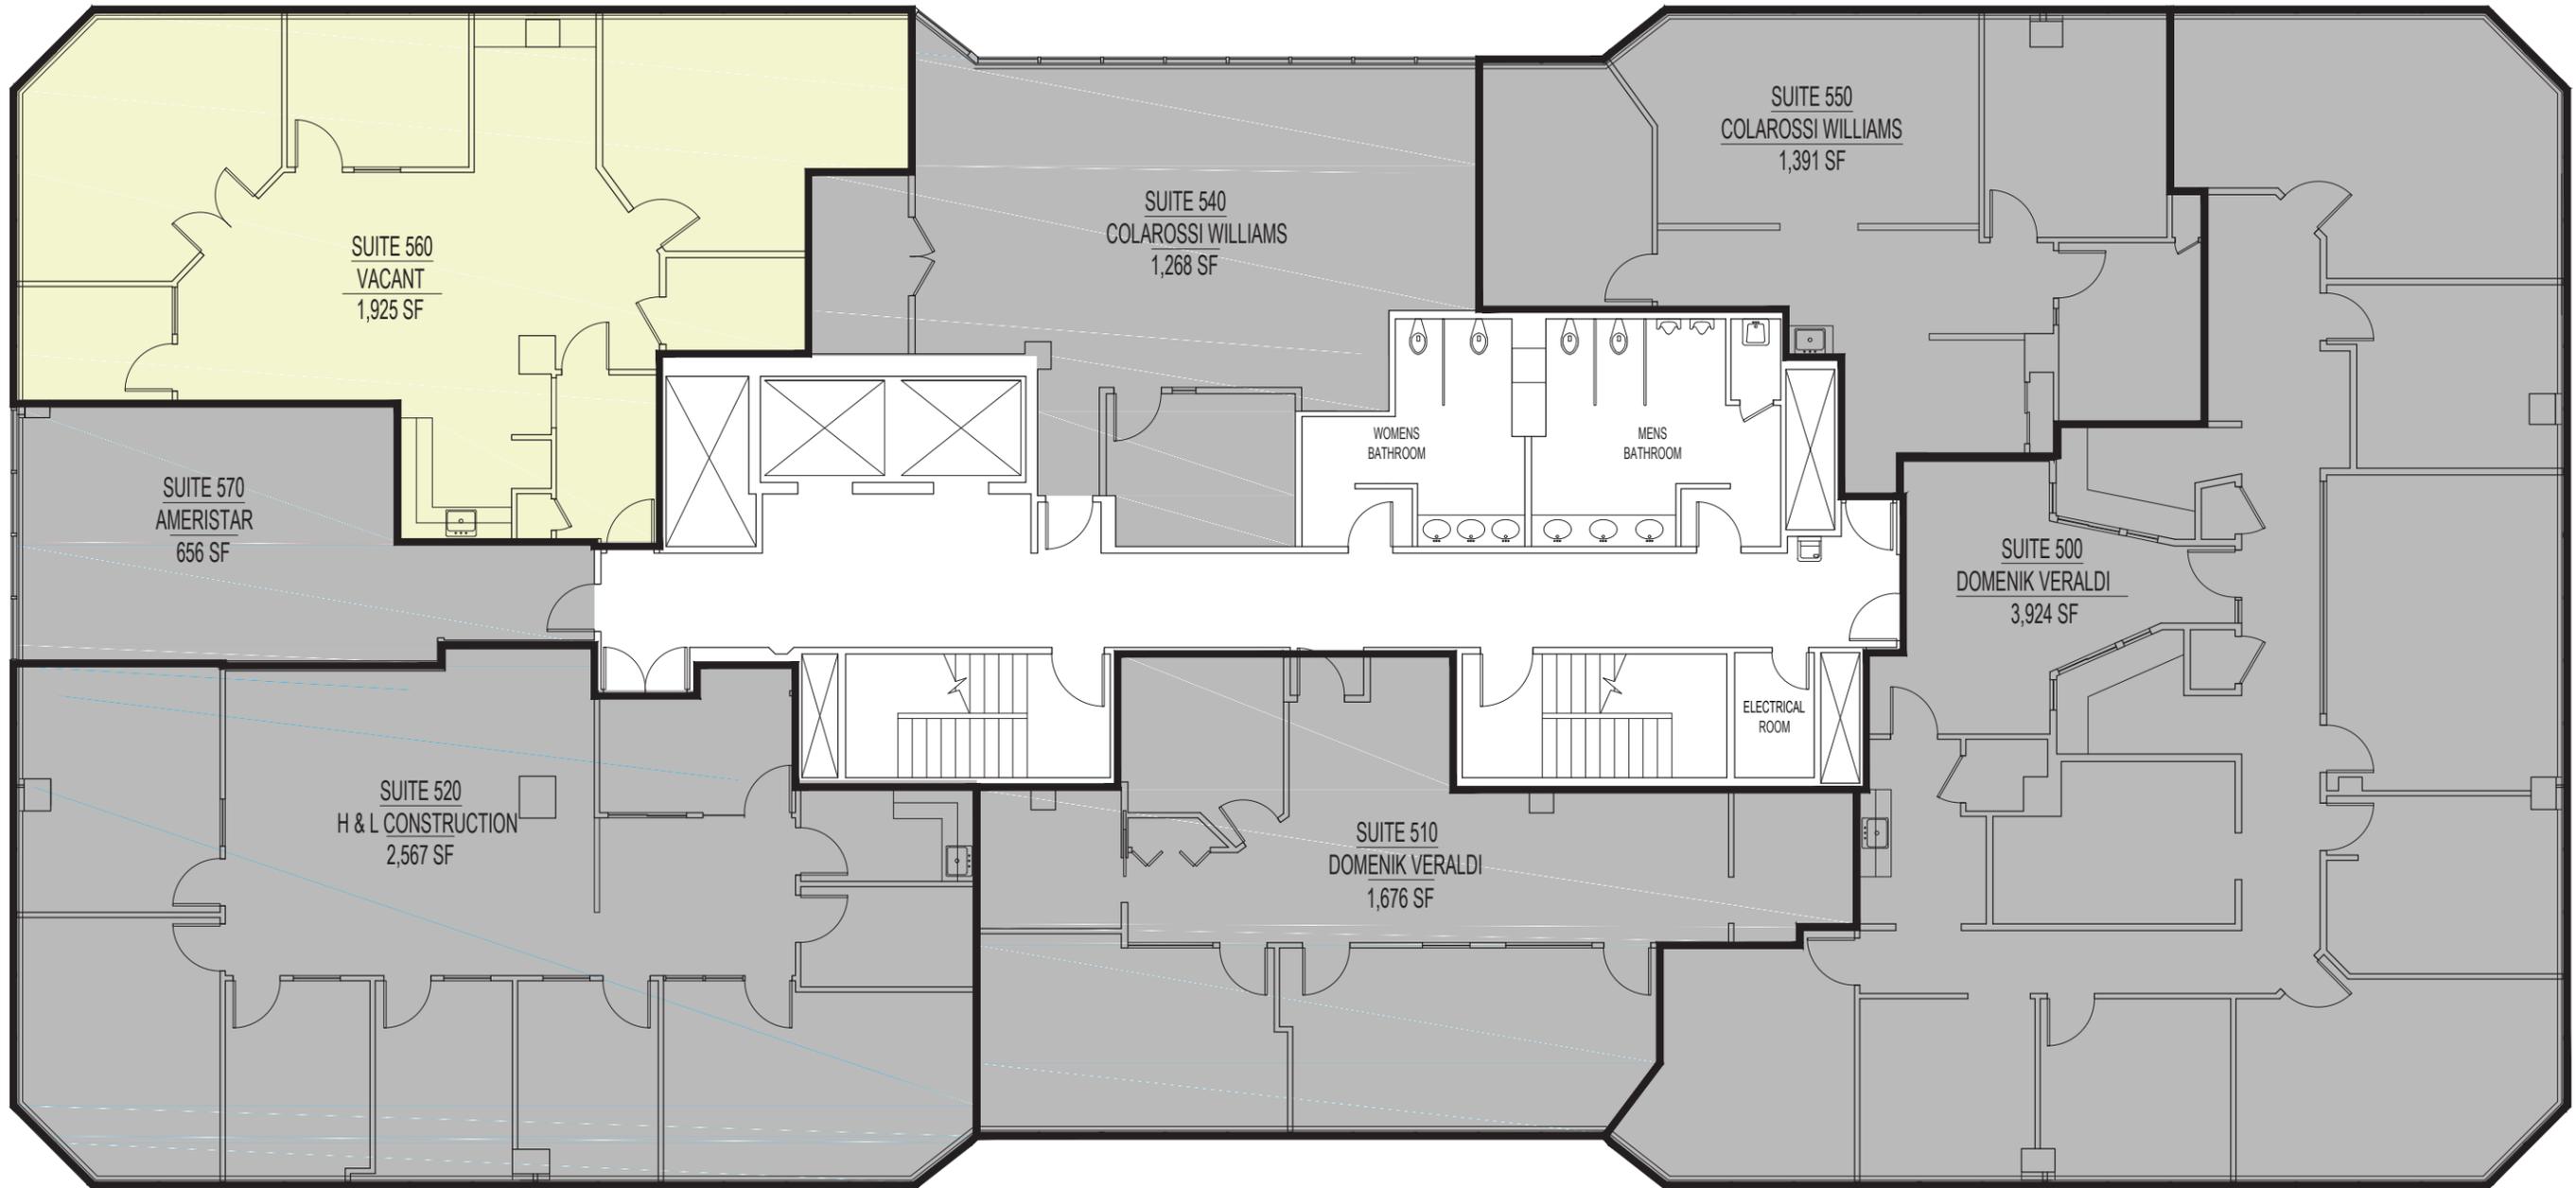

FIFTH FLOOR AS-BUILT BLOCK PLAN
 ONE SUFFOLK SQUARE
 1601 VETERANS MEMORIAL HWY.
 ISLANDIA, NY 11749

Date: FEBRUARY 5, 2021
 Scale: NOT TO SCALE

Drawing No.:
P-1