


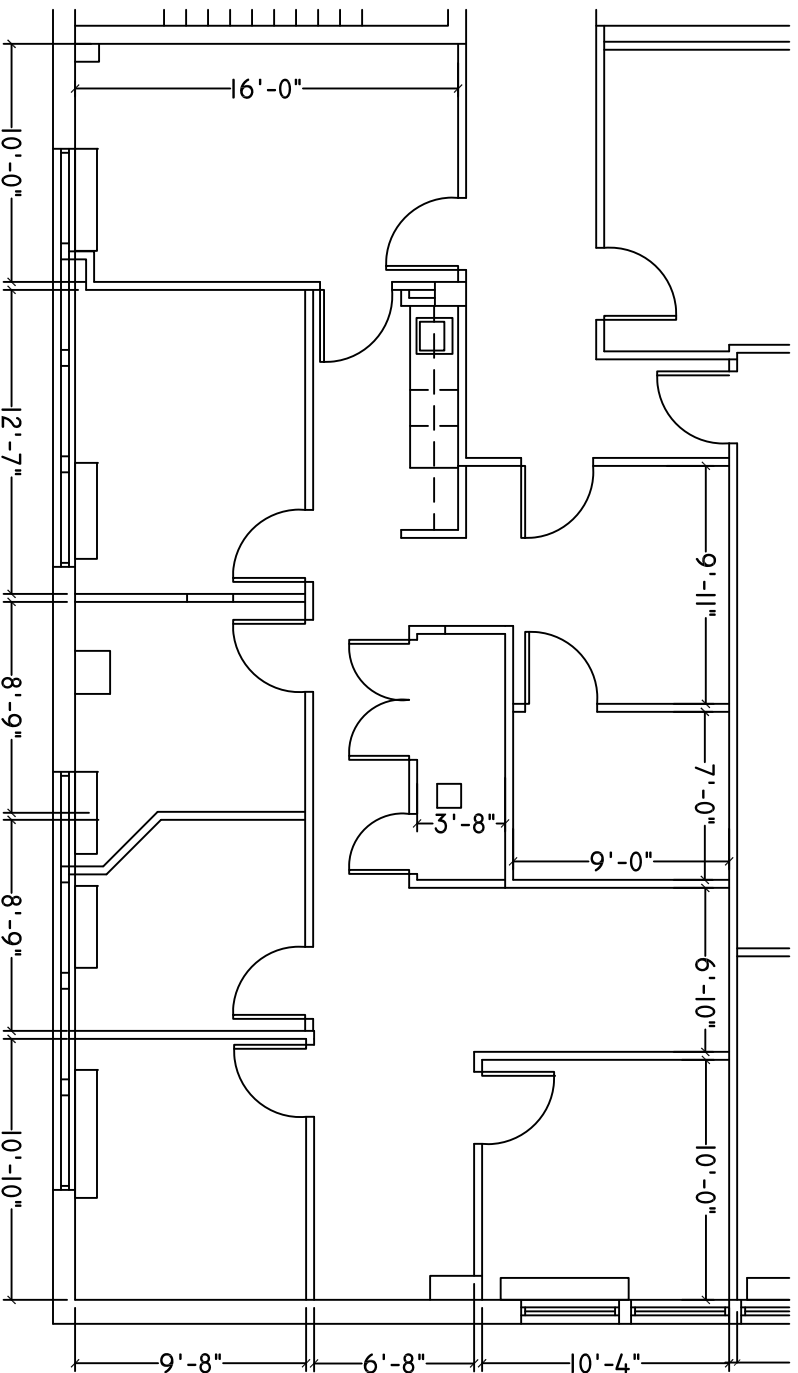

## AS-BUILT

SHELL BUILDING  
200 E. JOPPA ROAD  
TOWSON, MD  
SUITE 304 = 1,380 RENTABLE SQ.FT.

SCALE: 1/8" = 1'-0"  
DATE: 4/6/09  
REVISED:



Hill Management Services, Inc.  
9640 Deereco Road  
Timonium, Maryland 21093  
(410) 666-1000  
[www.hillmgt.com](http://www.hillmgt.com)