


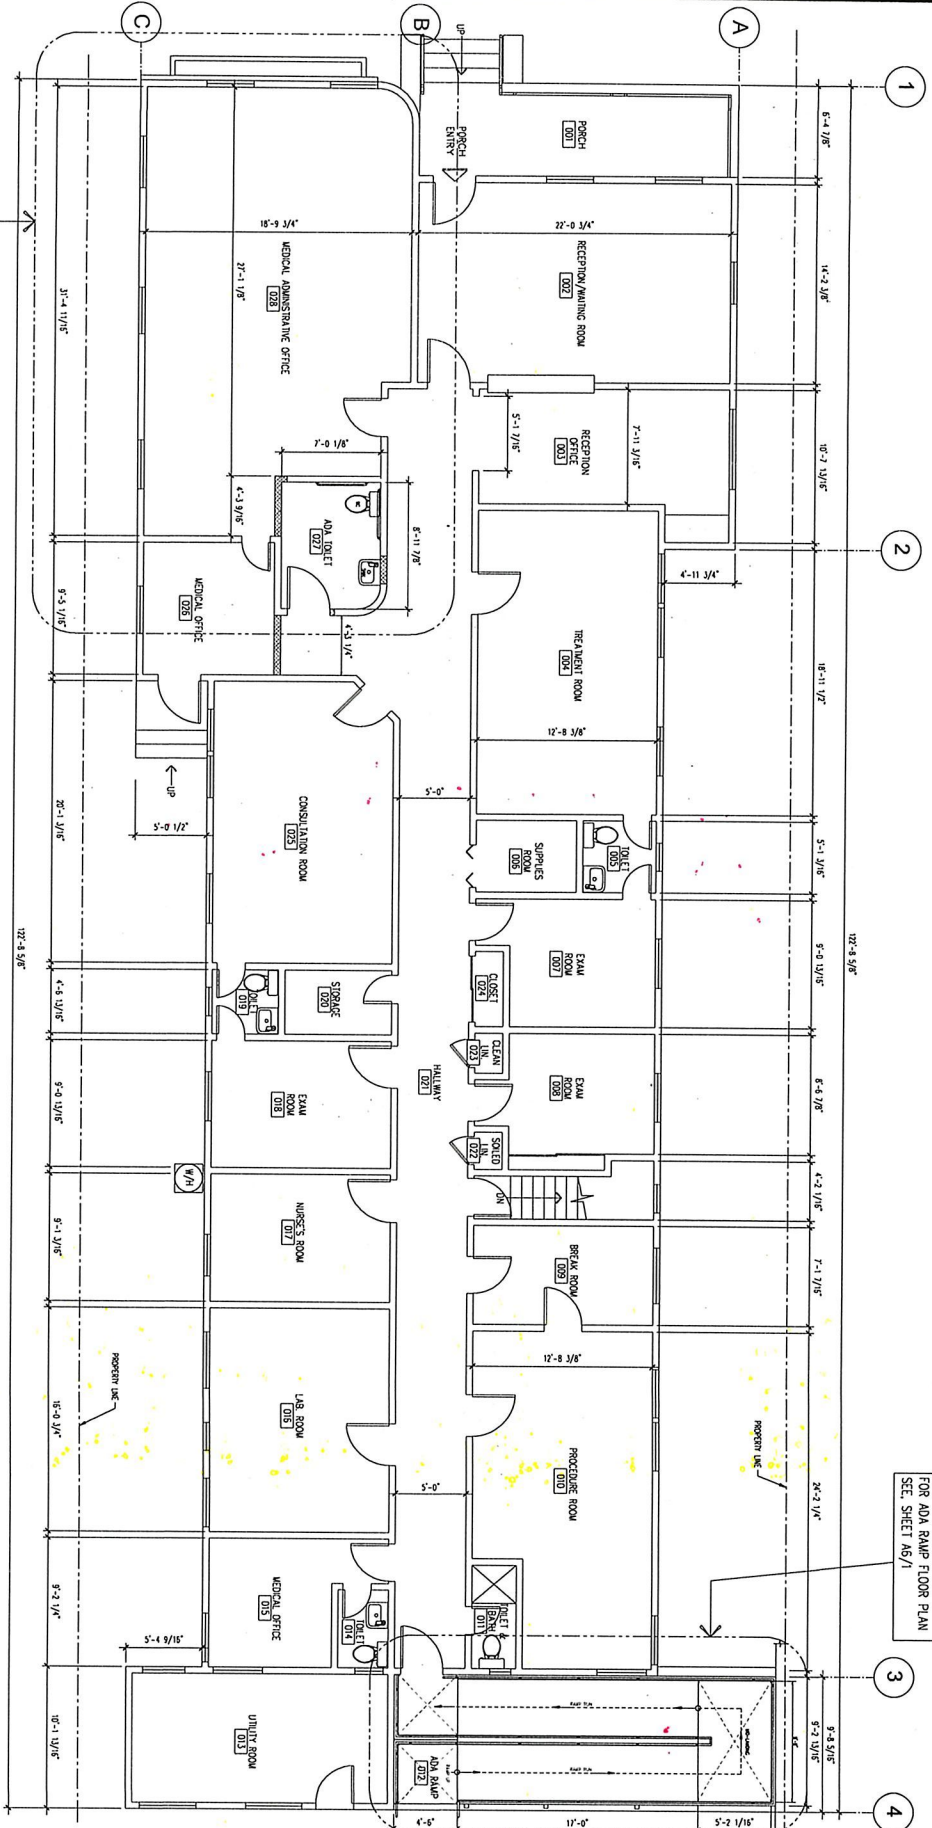

FOR REFLECTED CEILING PLAN
SEE SHEET A7/1

LEGEND

(E) WALLS, TYP.
DEMON. WALLS, TYP.
(N) WALL, TYP.

1 PROPOSED FLOOR PLAN

Scale: 1/4" = 1'-0"

ANDY ALEXANDER & ASSOCIATES

1615 GRAMERCY AVE.
TORRANCE, CA 90501
T: (424) 358.1085
AAA Job no. 24285

DRAWING TITLE

PROPOSED FLOOR PLAN

PLAN CHECK SET - NOT FOR PRICING

PROJECT TITLE & ADDRESS

AS-BUILT PLAN

7021 SEVILLE AVENUE
HUNTINGTON PARK, CA 90255

NO. 1000

DATE

SCALE

JOB NO.

SHEET

A4

FOR ADA RAMP FLOOR PLAN
SEE SHEET A5/1

MA

EXHIBIT

SCALE

NO. 1000

DATE

SCALE

JOB NO.

SHEET

A4