



KKT ARCHITECTS, INC.
2200 SOUTH UTICA PLACE, SUITE 200
TULSA, OKLAHOMA 74111
[P] 918.744.4270 \ [F] 918.744.7849
WWW.KKTARCHITECTS.COM
C O F A # 534


GUARANTY BUILDING

FIRST
FLOOR

9,994 sf

RUFFIN
PROPERTIES

08.30.2024

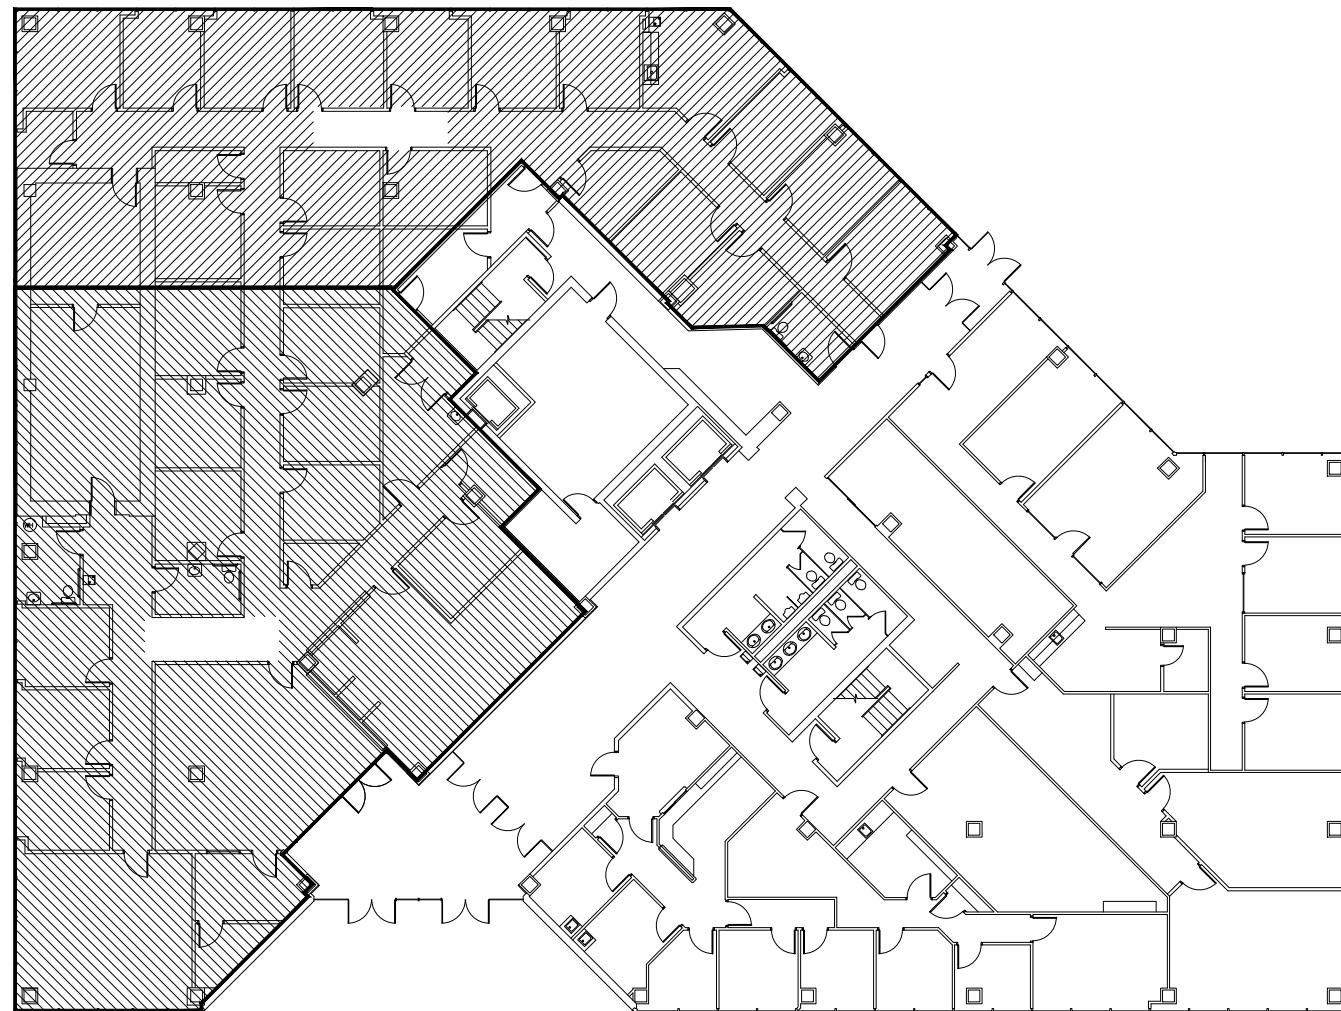

A FLOOR PLAN
0 12 4 8 16 32 NORTH

AS-BUILT
PLAN

AS-1