




5021 RSF

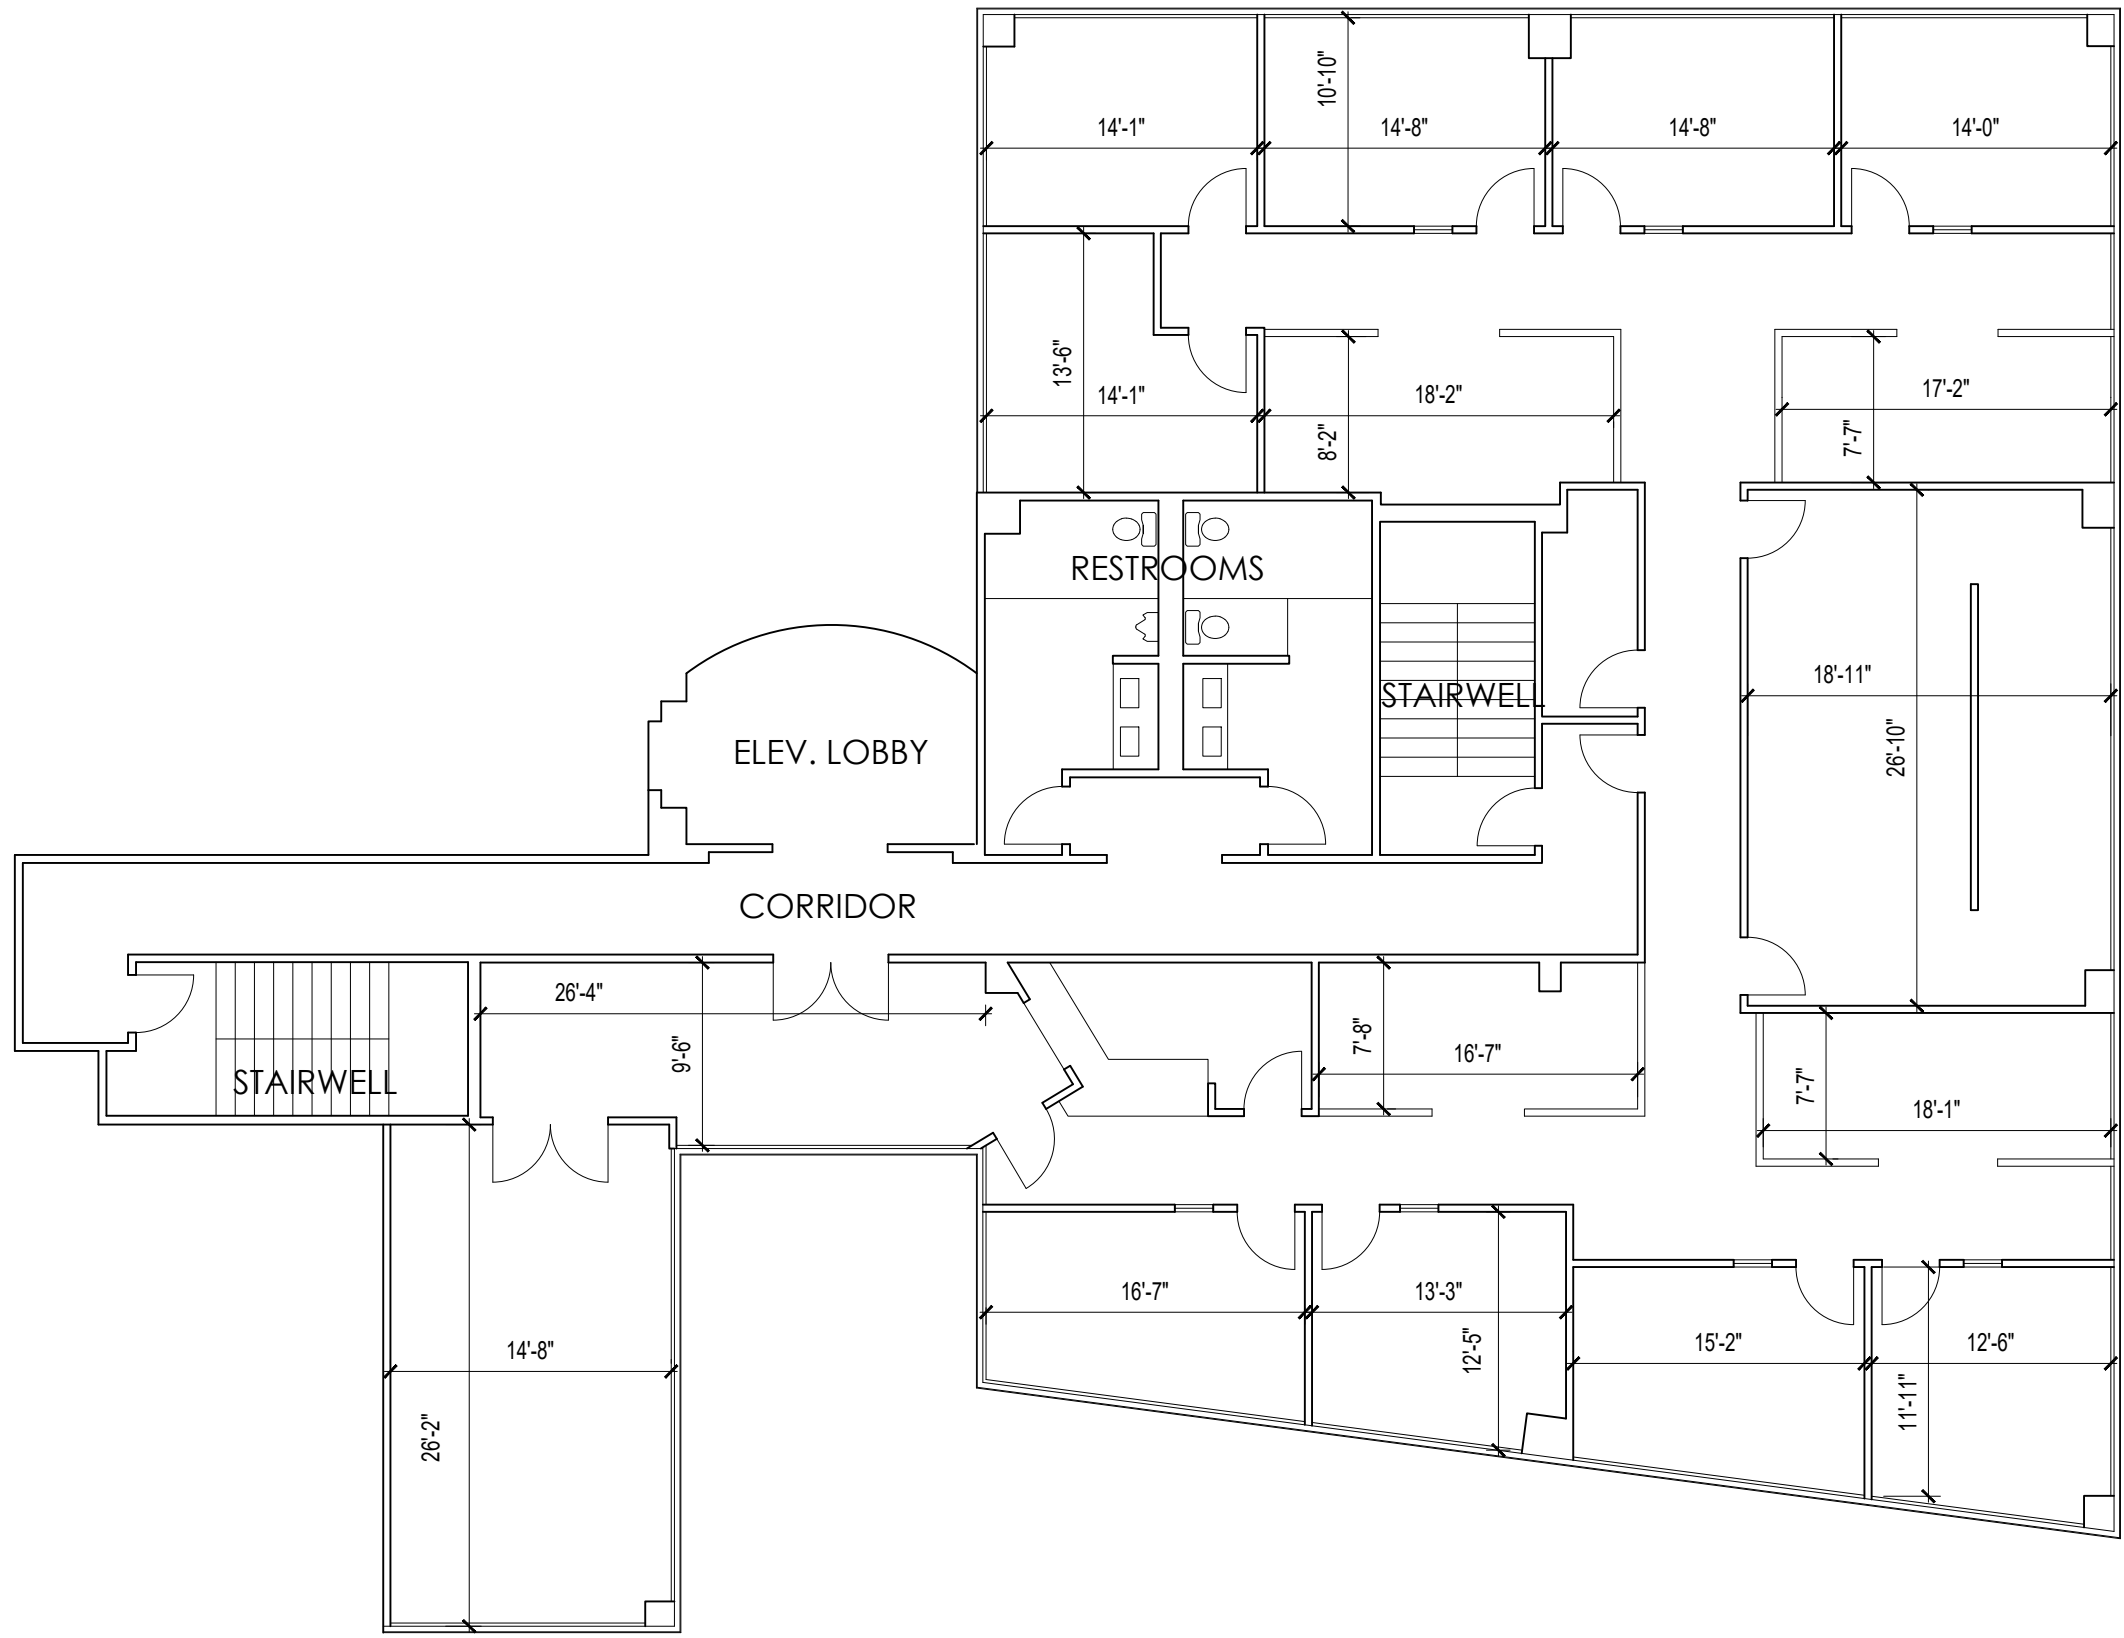

EXISTING FLOOR PLAN

SCALE: 1" = 10'-0"

As-Built Drawings



SQUARE FOOT STUDIOS
3374 WILD OAK LANE
ESCONDIDO, CA 92027
TEL: 858.201.8156
WWW.SQUAREFOOTSTUDIOS.NET

SUITE 200
2155 CHICAGO AVE
RIVERSIDE CA 92507

SHEET TITLE
Existing Plan

DATE: 7/18/24

SHEET NO.
200