




**Kinslow, Keith & Todd, Inc.**  
 architecture | interiors  
 tel 918.744.4270  
 fax 918.744.7849  
 2021 south lewis suite 150  
 tulsa, oklahoma 74104  
 www.kktarchitects.com  
 info@kktarchitects.com

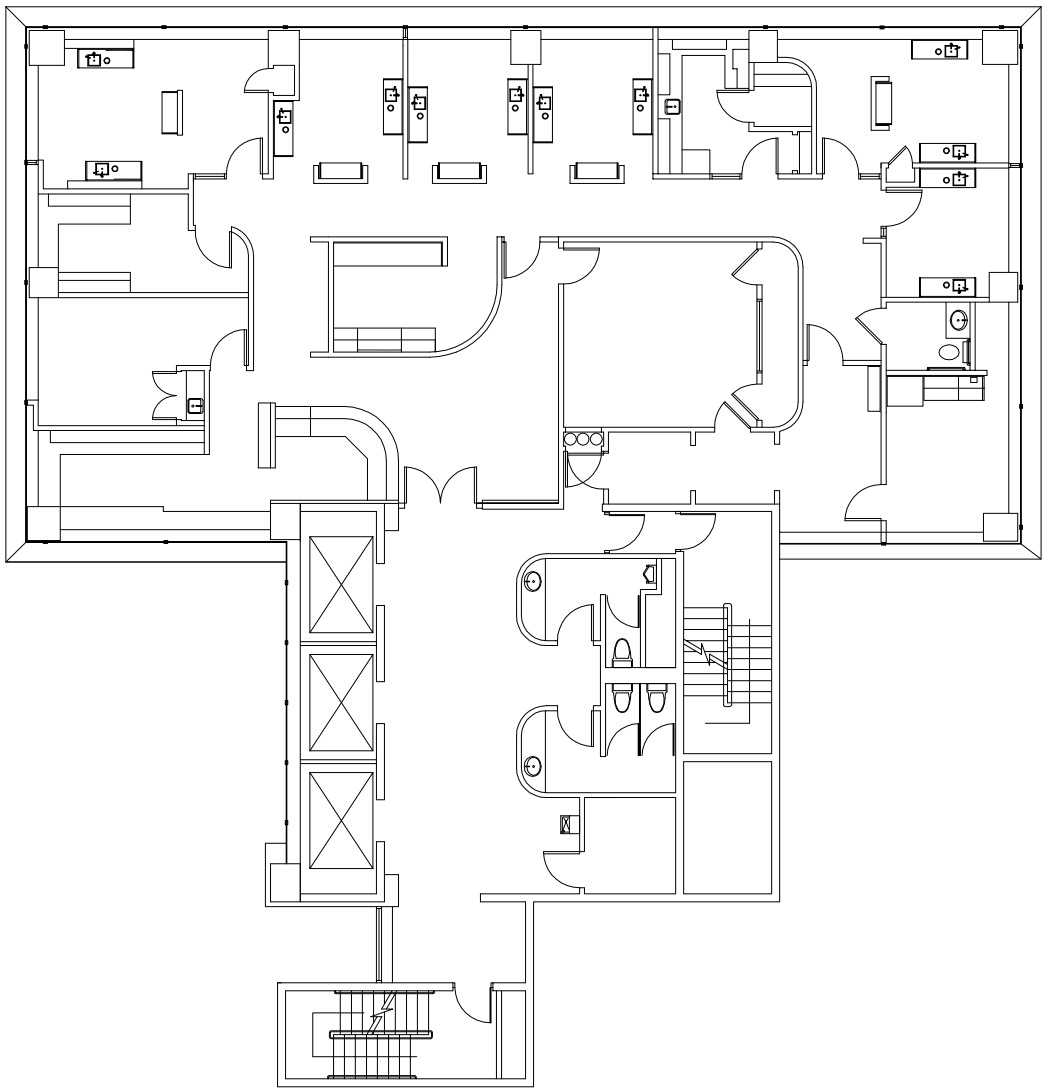

**11TH FLOOR  
 AS-BUILT**

PARK  
 TOWERS  
 11TH FLOOR  
 CASE &  
 ASSOCIATES

SCALE	1/16" = 1'-0"
FILE NAME	PT11AS
MANAGER	YW
DRAWN BY	YW

**A FLOOR PLAN**  
 SCALE: 1/16" = 1'-0"



NORTH

AS-BUILT  
 PLAN

**AS-11**