




**kirtlow, keith & todd, inc.**  
 architecture | interiors  
 Tel 918.744.4270  
 Fax 918.744.7549  
 3000 W. UNIVERSITY BLVD  
 TULSA, OKLAHOMA 74104  
 www.kktarchitects.com  
 info@kktarchitects.com

**FLOOR TABULATIONS:**

MECHANICAL ROOMS 3-458.00 USF  
 COMMON AREA LOBBY / STAIRCASE 13-324.00 USF  
 RESTROOM / MECHANICAL ROOM 13-324.00 USF  
 ELEVATOR STAIRS / CHASES 12-423.12 USF  
 OFFICE FLOOR 12-114.00 USF

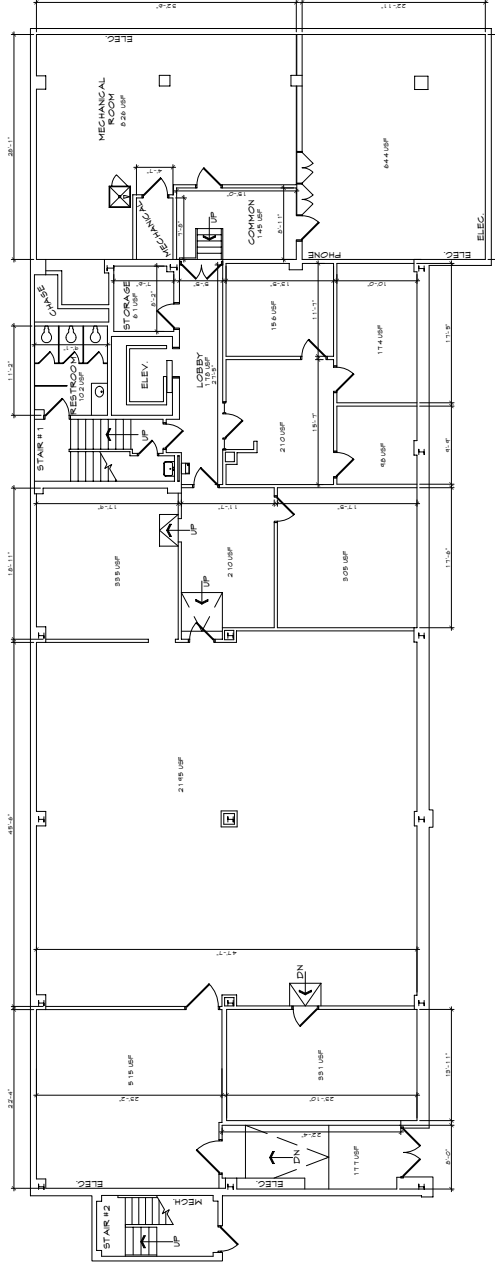

**A FLOOR PLAN**  
 SCALE: 1/8" = 1'-0"

**DENVER BUILDING**  
**Basement**

624 SOUTH DENVER

SCALE: 1/8" = 1'-0"  
 REFERENCE: EXTERIOR FINISH  
 DIMENSIONS: IN MM  
 DATE: 11.03.09

AS-BUILT PLAN  
**AS-1**



