


ALL DRAWINGS, SPECIFICATIONS AND NOTES HEREOF FURNISHED BY MCMILLAN PAZDAN SMITH ARCHITECTURE ARE AND SHALL REMAIN THE PROPERTY OF MCMILLAN PAZDAN SMITH ARCHITECTURE. THESE MATERIALS ARE TO BE USED ONLY WITHIN THE PROJECT AND NOT TO BE REPRODUCED OR TRANSMITTED IN ANY FORM OR BY ANY MEANS, ELECTRONIC OR MECHANICAL, INCLUDING PHOTOCOPYING, RECORDING, OR BY ANY INFORMATION STORAGE AND RETRIEVAL SYSTEM, WITHOUT THE WRITTEN PERMISSION OF MCMILLAN PAZDAN SMITH ARCHITECTURE. SUBMISSION OF THIS DRAWING TO ANY OTHER PARTY FOR ANY PURPOSE IS NOT TO BE CONSIDERED AS A RELEASE OF MCMILLAN PAZDAN SMITH ARCHITECTURE FROM LIABILITY FOR ANY ERRORS OR OMISSIONS. ALL RIGHTS RESERVED.

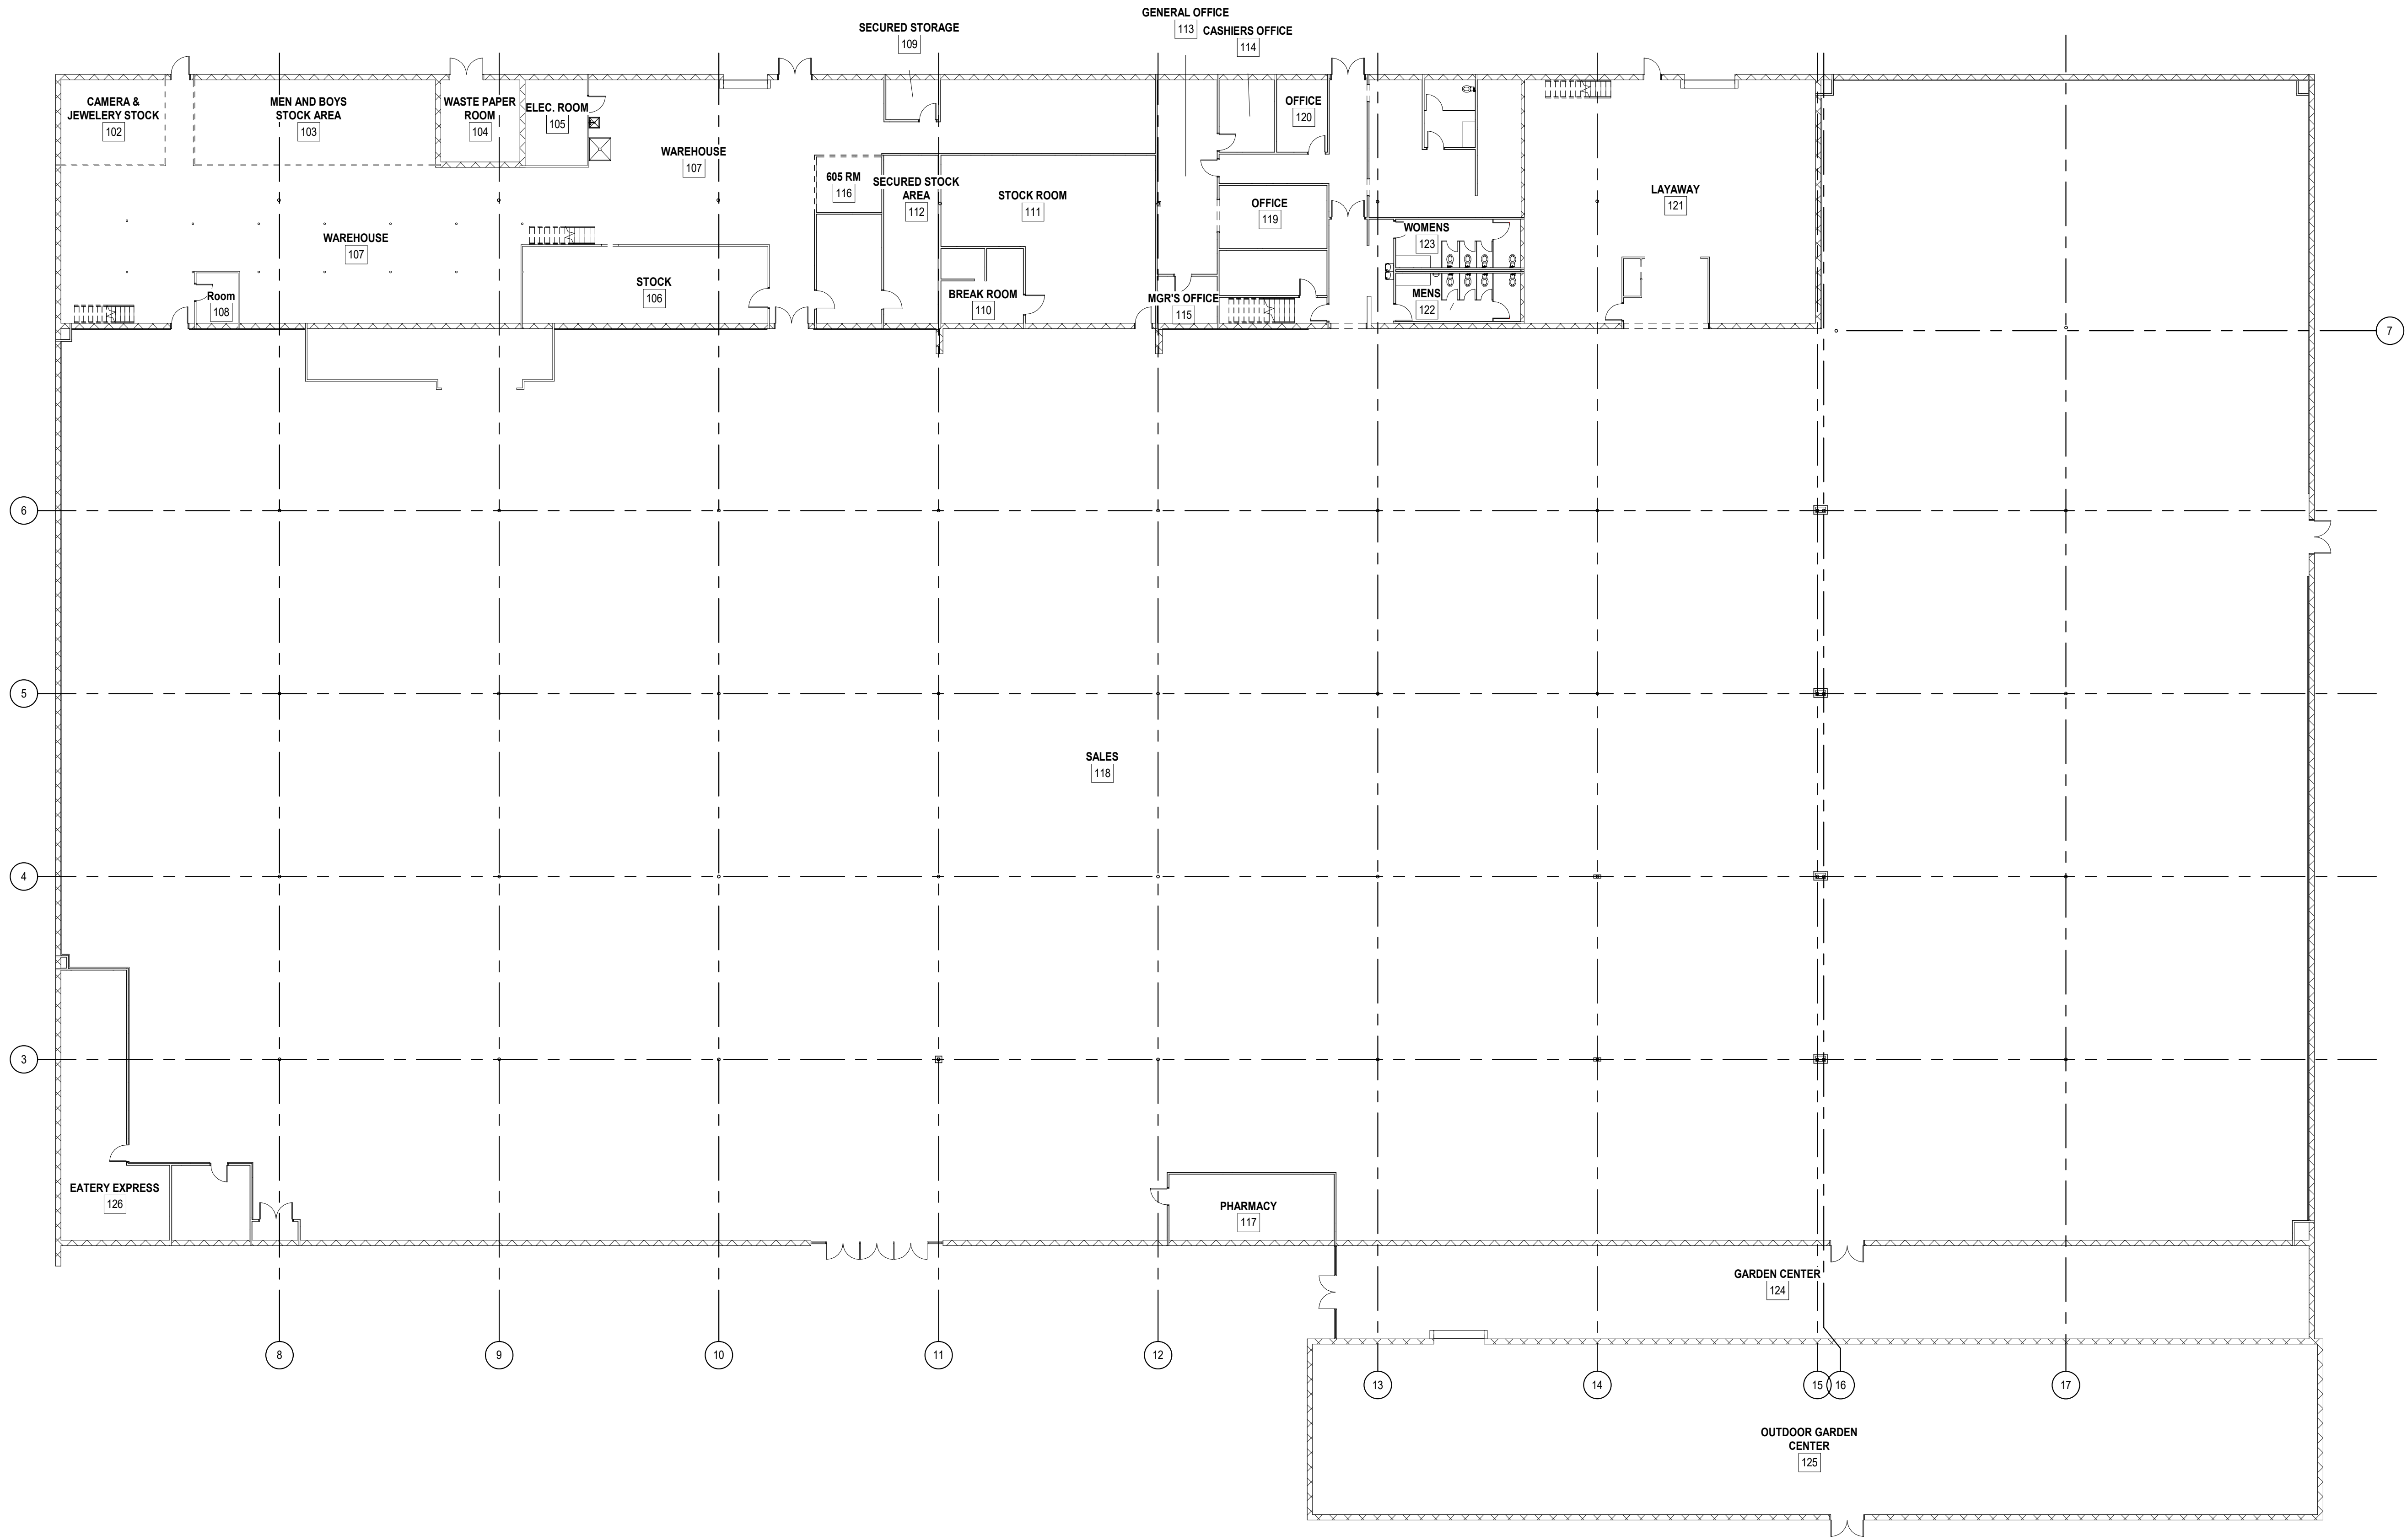

A1 FLOOR PLAN
G100 1/16" = 1'-0"

HUGHES DEVELOPMENT
KMAR EXISTING SPACE
MAULDIN, SC

SHEET ISSUE:			
NO.	DATE	DESCRIPTION	BY

NOT FOR CONSTRUCTION

PRINCIPAL IN CHARGE:
PROJECT ARCHITECT:
DRAWN BY:

NOT SET
NOT SET
Author

SHEET TITLE:
AS-BUILT FLOOR
PLAN

SHEET NO.
PROJ. NO.
NOT SET

G100