




Park 1 Floor Plan w/restrooms

2653 SF



Storage Room

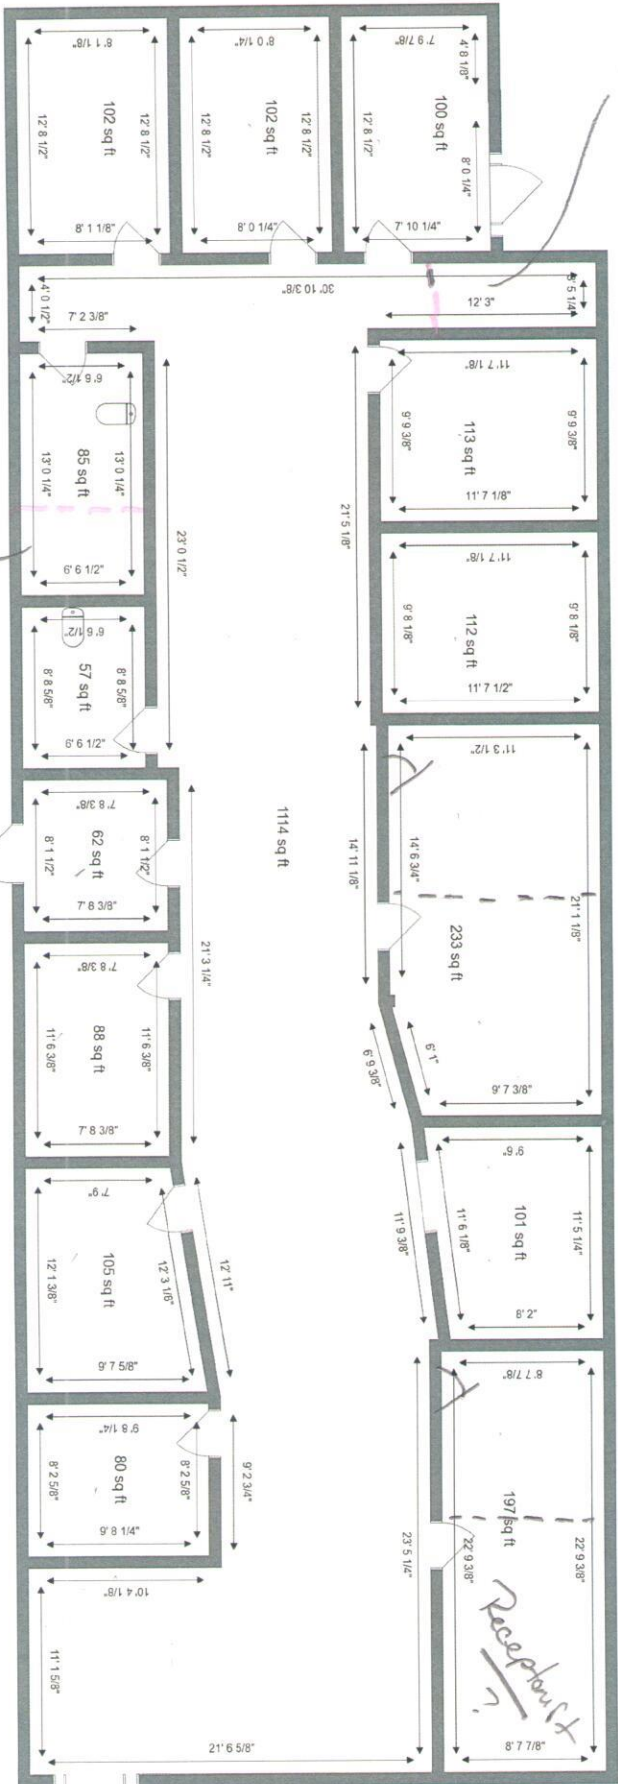

PARKING

Option 1

This Plan has 13 Exam Rooms to 14 Exam Room
Plus waiting area + Receptionist Area




Park 1 Floor Plan w/restroom

3663 SF



Storage Room

Split Large Room into 2 Rooms

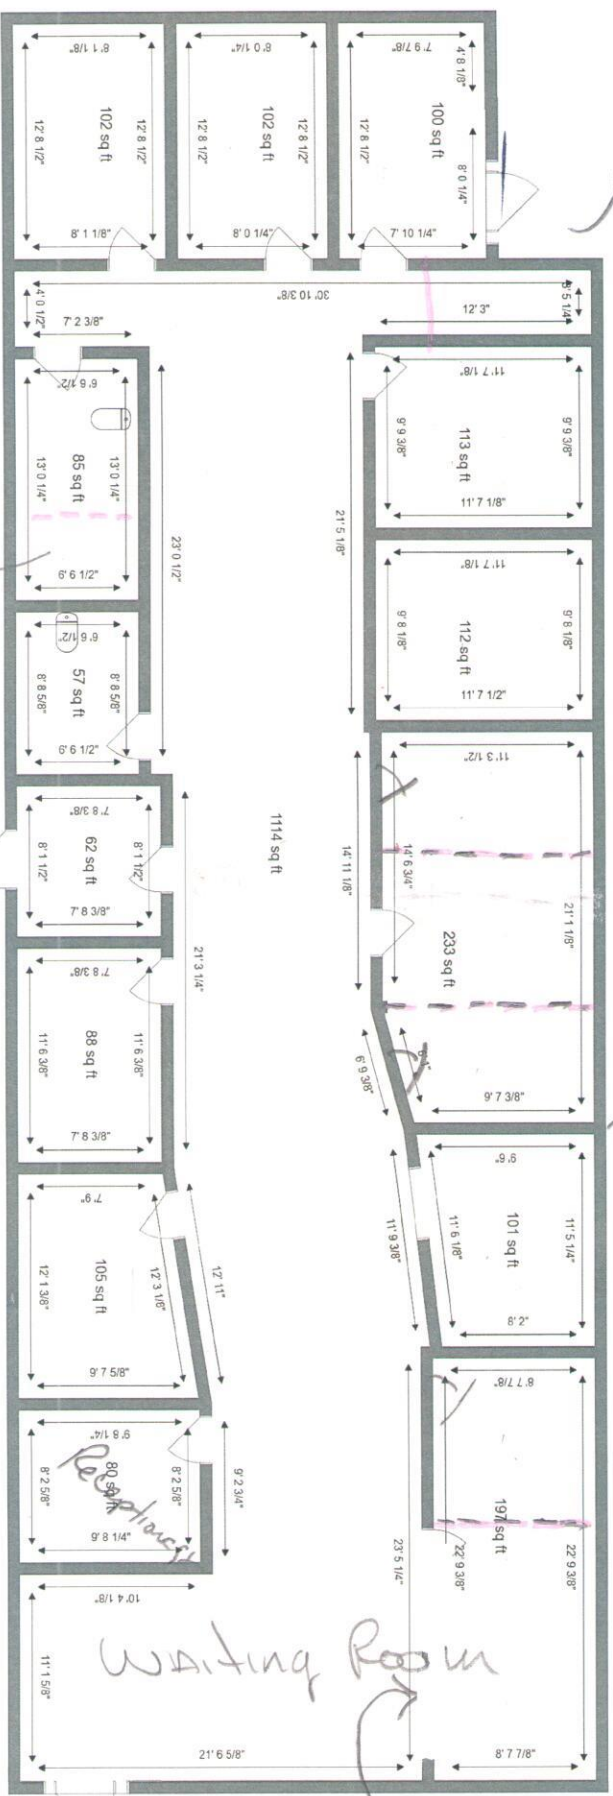

Storage Room

PARKING

Option 2

Waiting Room


Remove wall To open Waiting Room

This plan has 13 Rooms Extra large waiting room & Receptionist



Park 1 Floor Plan w/restrooms

2653 SF

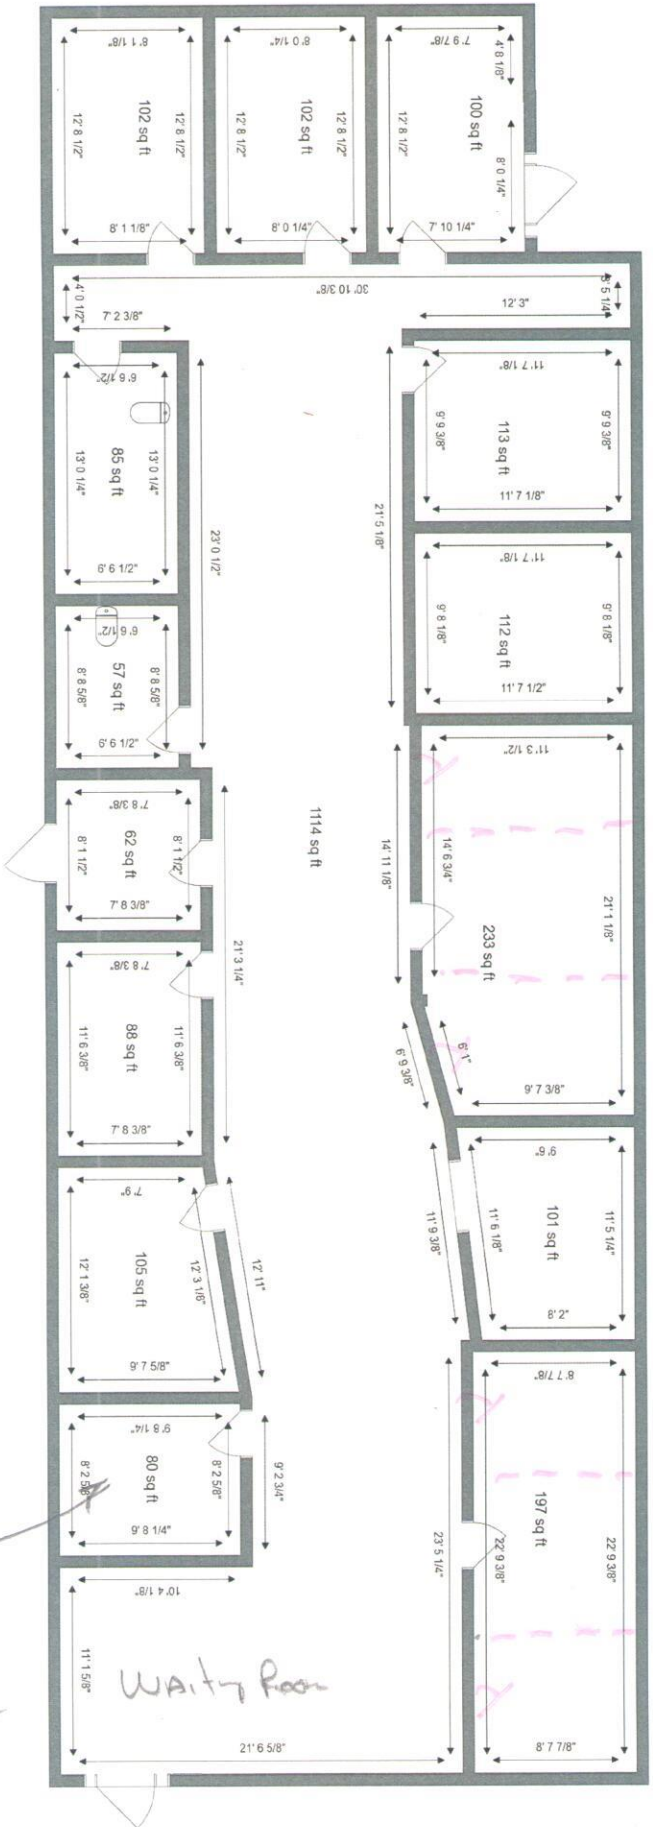

This plan would provide 15 Exam Rooms

option 3

PARKING

Receptionist


Waiting Room



Park 1 Floor Plan w/restroom

2653 SF

As Built from

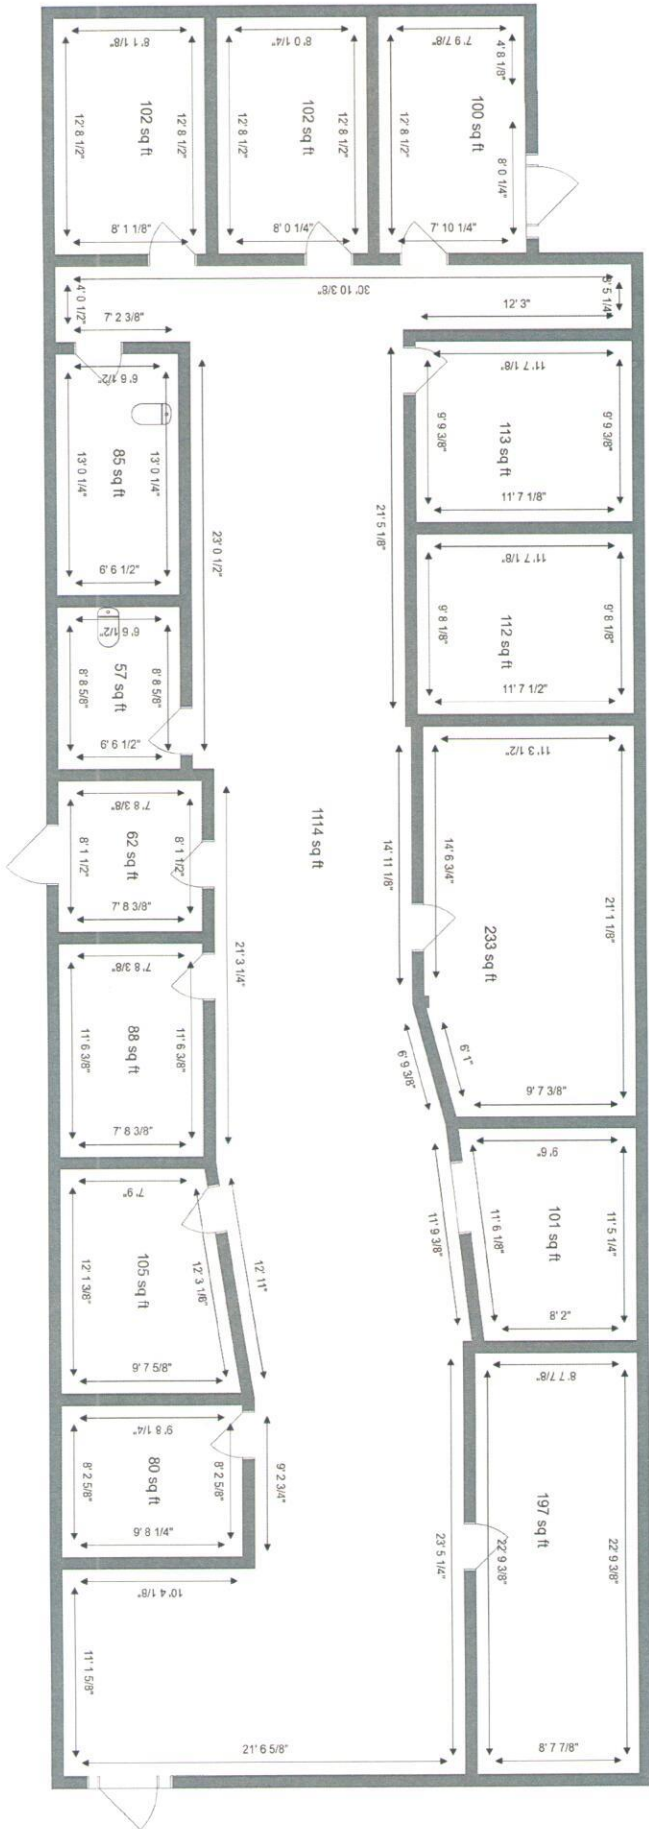

PARKING