



DEPARTMENT OF ENVIRONMENTAL HEALTH  
SEWAGE DISPOSAL SYSTEM  
"AS-BUILT"

Approval Issued to:

Name Miguel Diaz Soto

Installer's Name

M. Ripper

Mailing Address 3930 Tanagerian Dr. #711

Application Number

37197 AP Number

24-280-09

Antelope, Ca. 95843

Property Address

5600 Sunshine Dr. R.B.

Total Number:

Living units 1 bedrooms 4 baths 3 basement: Yes X No X

Water Supply:

Public System Individual X Type well community

Septic Tank:

Distance from well 90 feet Material Concrete

Total Liquid Capacity 1200 gal.

Drainfield:

Total Linear Feet 200 ft.

Total Square Footage 902 ft.<sup>2</sup>

Width of trench or bed 3 ft.

Distance between drain lines 10 1/2 ft. (edge to edge)

Type/size of rock filter material 1 1/2 in.

Depth rock over drain line 12 in.

Depth rock beneath drain line 12 in.

Transit used: yes X no no

Distance of wall from closest portion of sewage system 110 ft.

Seepage Pit:


Depth

Diameter

Number

Total Square Footage      ft.<sup>2</sup> lined (dry well)      or gravel filled (pit)     

SKETCH OF ACTUAL SYSTEM AS CONSTRUCTED

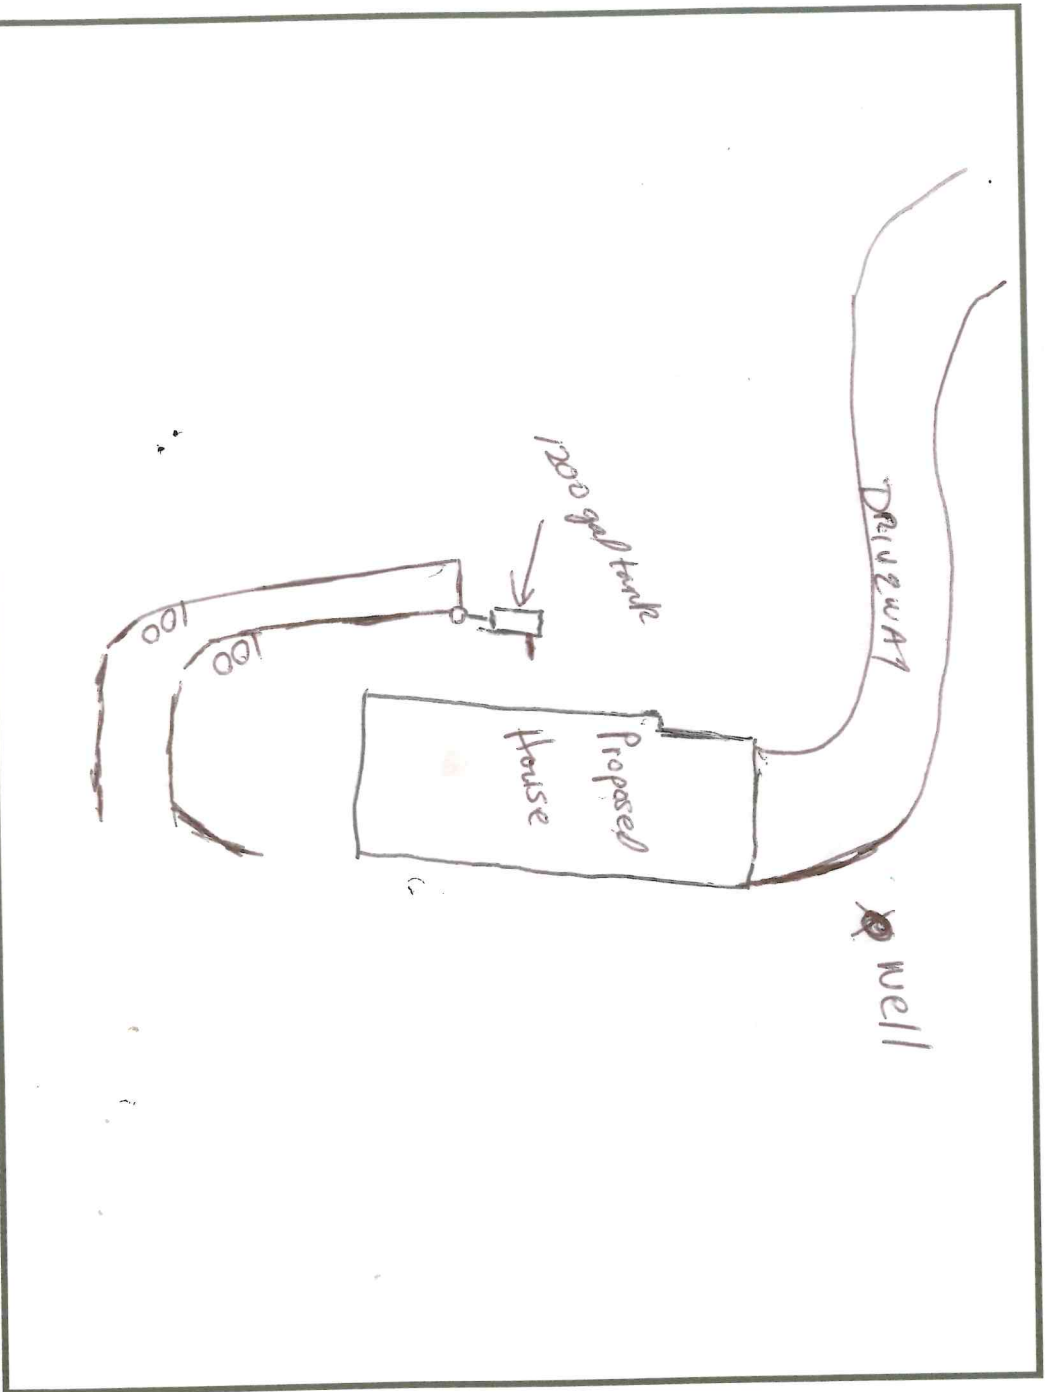

Miguel Diaz Soto  
SIGNATURE OF INSTALLER

2-28-97  
DATE

FOR OFFICIAL USE ONLY

System meets all codes and is therefore **APPROVED** X

for use. **DISAPPROVED**     

Remarks     

Date

2/28/97

E.H. Specialist

[Signature]