

10,715 SF

Industrial/Commercial Property For Lease



BROWN
COMMERCIAL GROUP, INC.

6620 W. DAKIN ST., CHICAGO, IL 60634



6620 W. DAKIN ST., CHICAGO

- 10,715 SF
- 15% Office Space
- 12' Clear Height
- 1 Dock
- 400 Amp, 480 Volt, 3 Phase Power
- 100% Air Conditioned
- Kitchenette
- Taxes: \$3.20 SF
- CAM: \$1.65 SF
- Lease Rate: Subject to Offer
- Available Immediately

COLLIN TYRRELL

847.758.9200 x303

CTYRRELL@BROWNCOMMERCIAL.COM

PAT CROWLEY

847.758.9200 x310

PCROWLEY@BROWNCOMMERCIAL.COM

DAN BROWN, SIOR

847.758.9200 x302

DBROWN@BROWNCOMMERCIAL.COM

BROWNCOMMERCIAL.COM

//

1400 E. HIGGINS RD. SUITE A, ELK GROVE VILLAGE, IL 60007

//

847.758.9200

No warranties or representations is made as to the accuracy of the foregoing information. Terms and availability are subject to changes or withdrawal without notice




10,715 SF

Industrial/Commercial Property For Lease



BROWN
COMMERCIAL GROUP, INC.

6620 W. DAKIN ST., CHICAGO, IL 60634

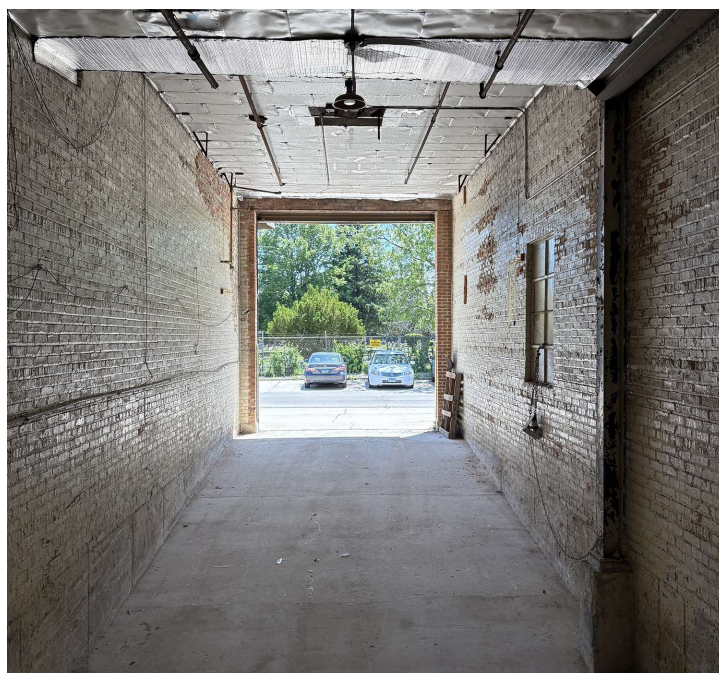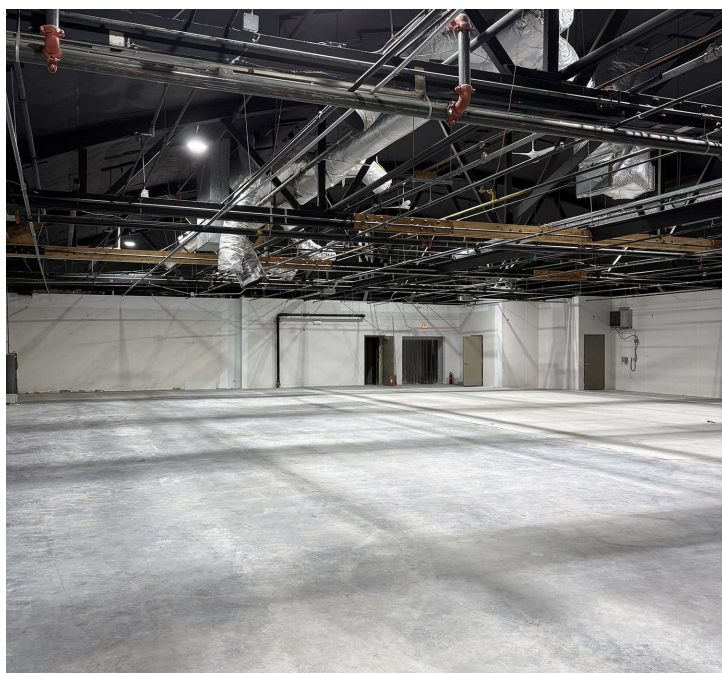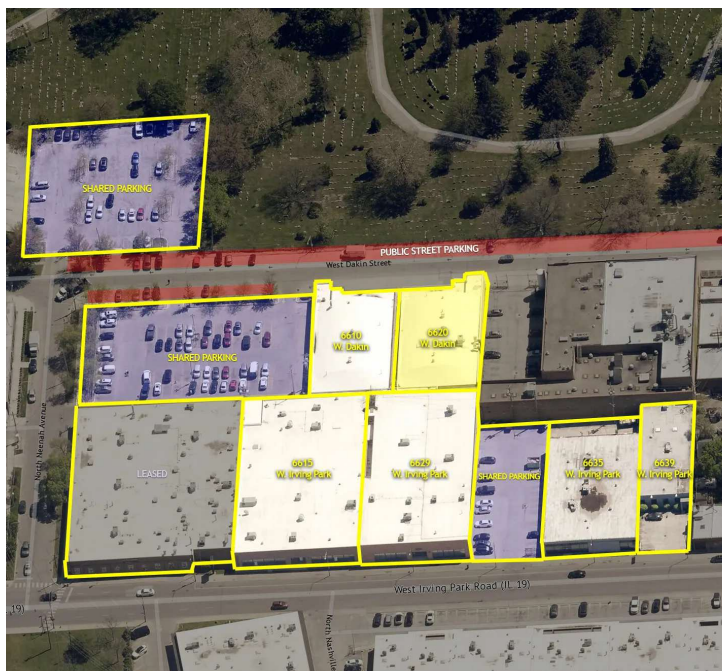

COLLIN TYRRELL

847.758.9200 x303

CTYRRELL@BROWNCOMMERCIAL.COM

PAT CROWLEY

847.758.9200 x310

PCROWLEY@BROWNCOMMERCIAL.COM

DAN BROWN, SIOR

847.758.9200 x302

DBROWN@BROWNCOMMERCIAL.COM

BROWNCOMMERCIAL.COM

//

1400 E. HIGGINS RD. SUITE A, ELK GROVE VILLAGE, IL 60007

//

847.758.9200

No warranties or representations is made as to the accuracy of the foregoing information. Terms and availability are subject to changes or withdrawal without notice


10,715 SF

Industrial/Commercial Property For Lease



BROWN
COMMERCIAL GROUP, INC.

6620 W. DAKIN ST., CHICAGO, IL 60634

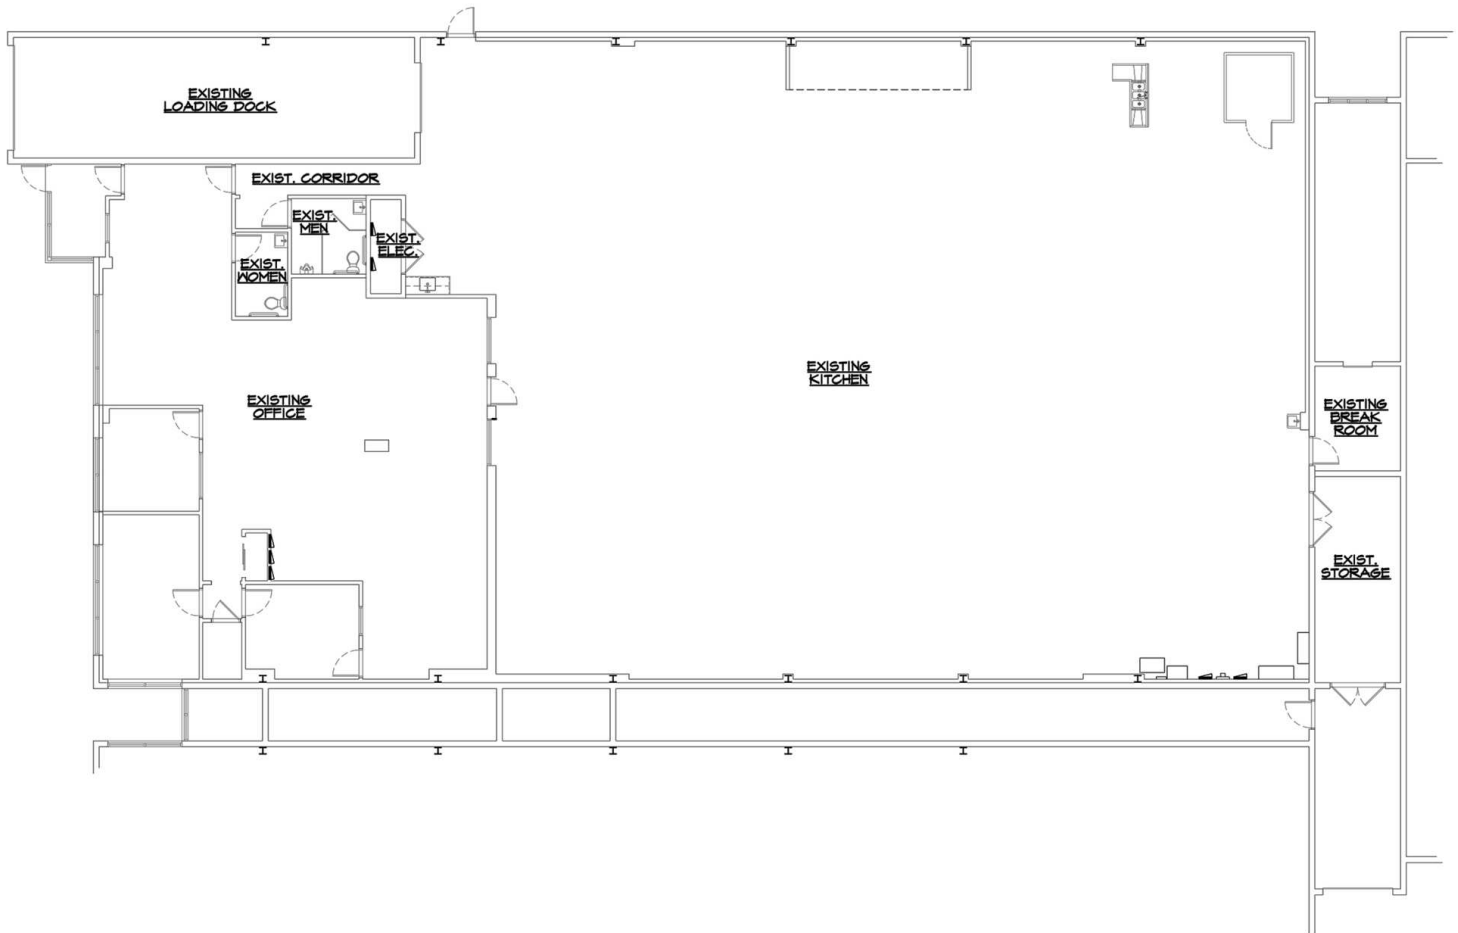

AS-BUILT GROUND FLOOR PLAN
SCALE: 1/8" = 1'-0"



BUILDING:
6620 WEST DAKIN
BUILDING #4
CHICAGO, ILLINOIS

COLLIN TYRRELL

847.758.9200 x303

CTYRRELL@BROWNCOMMERCIAL.COM

PAT CROWLEY

847.758.9200 x310

PCROWLEY@BROWNCOMMERCIAL.COM

DAN BROWN, SIOR

847.758.9200 x302

DBROWN@BROWNCOMMERCIAL.COM

BROWNCOMMERCIAL.COM

// 1400 E. HIGGINS RD. SUITE A, ELK GROVE VILLAGE, IL 60007

// 847.758.9200

No warranties or representations is made as to the accuracy of the foregoing information. Terms and availability are subject to changes or withdrawal without notice