


10043 Lincoln Highway

Frankfort, Illinois 60423

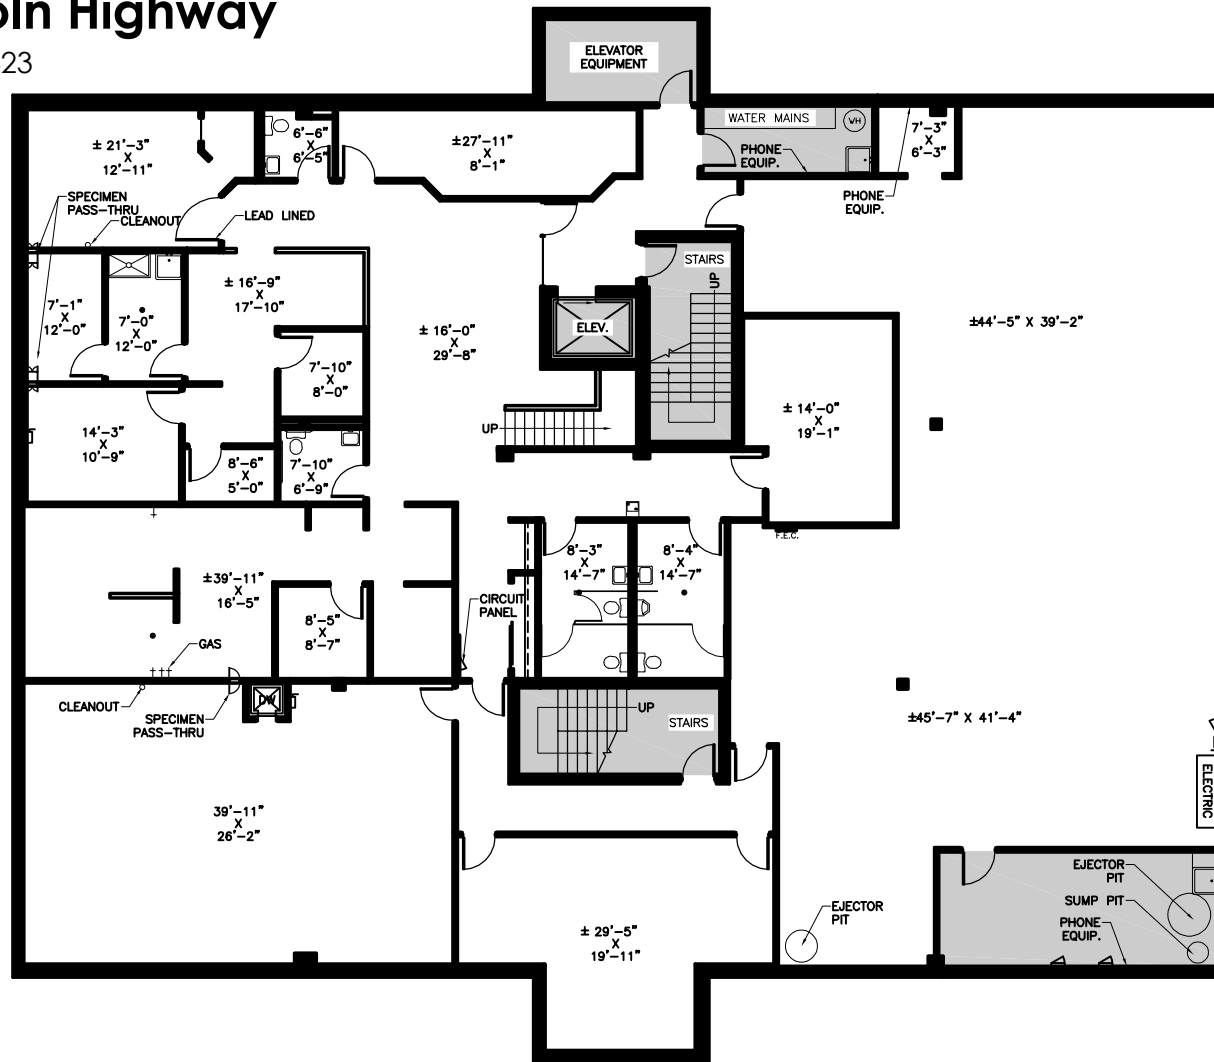

Lower Level - As-Built Conditions

Lower Level: 8,553 Rentable Square Feet
Total Building: 24,125 Rentable Square Feet

Scale:

N.T.S.

