
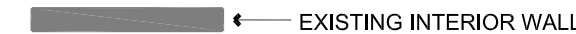
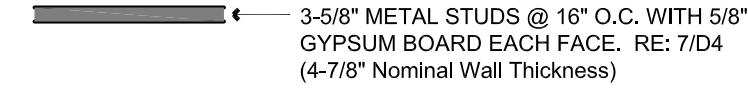
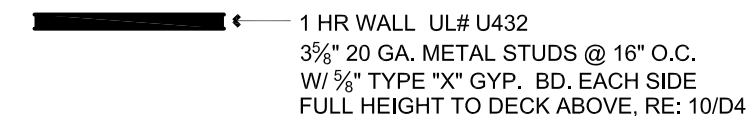
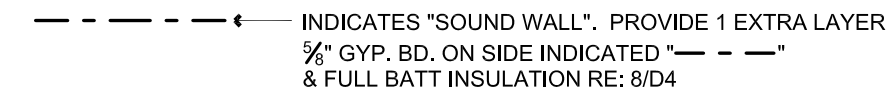

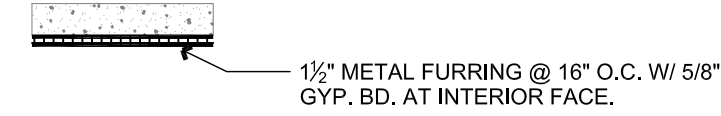



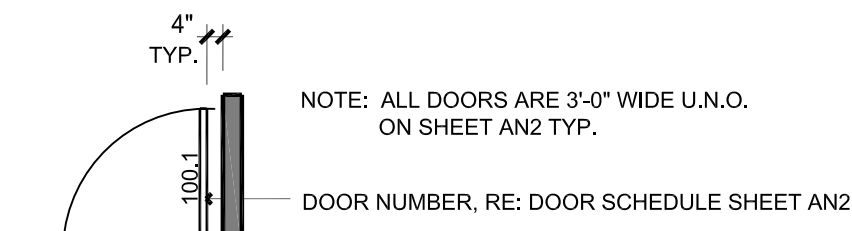




LEGEND

-  ← EXISTING EXTERIOR WALL/WINDOWS
-  ← EXISTING INTERIOR WALL
-  ← 3-5/8" METAL STUDS @ 16" O.C. WITH 5/8" GYPSUM BOARD EACH FACE, RE: 7/D4 (4-7/8" Nominal Wall Thickness)
-  ← 1 HR WALL UL# U432 3/4" 20 GA. METAL STUDS @ 16" O.C. W/ 1/2" TYPE "X" GYP. BD, EACH SIDE FULL HEIGHT TO DECK ABOVE, RE: 10/D4
-  ← INDICATES "SOUND WALL". PROVIDE 1 EXTRA LAYER 3/4" GYP. BD. ON SIDE INDICATED & FULL BATT INSULATION RE: 8/D4
-  ← 1/2" METAL FURRING @ 16" O.C. W/ 5/8" GYP. BD.
-  ← 1/2" METAL FURRING @ 16" O.C. W/ 5/8" GYP. BD. AT INTERIOR FACE.
-  ← HANDICAPPED ACCESSIBLE CLEAR FLOOR AREA
-  ← UTILITY WALL CONSTRUCTION - SEE SHEET D2.
-  ← DRAWING # / SHEET #
-  ← NOTE: ALL DOORS ARE 3'-0" WIDE U.I.O. ON SHEET AN2 TYP. DOOR NUMBER, RE: DOOR SCHEDULE SHEET AN2
-  ← DENOTES ALIGNMENT OF 2 SURFACES
-  ← DENOTES ALIGNMENT OF 2 SURFACES

NOTES



1. GENERAL CONTRACTOR IS RESPONSIBLE FOR COORDINATING ALL TRADES, ESPECIALLY ELECTRICAL AND HVAC, FIRE EXTINGUISHER, DOOR STOPS, ETC., SO AS NOT TO INTERFERE WITH PLANNED LOCATIONS FOR DESIGN DETAILS AND ARTWORK, MAGAZINE RACKS, HOOKS, COMMUNICATION BOARDS, ETC. LOCATIONS. REFERENCE F1 & F2 AT ALL STAGES OF CONSTRUCTION.
2. ALL DIMENSIONS ARE TO FACE OF FRAMING U.N.O. GYPSUM BOARD IS ASSUMED TO BE 5/8" THICK. SEE ARCHITECTURAL NOTES ON AN1. IF "±" DIMENSION VARIES MORE THAN 2", CONTACT I.H.E. DESIGN, INC. 1-800-444-4843
3. ALL WALL AND MILLWORK ANGLES SHALL BE 45° UNLESS NOTED OTHERWISE.
4. PROVIDE BLOCKING AS PER BLOCKING SCHEDULE AND FOR ALL OTHER TOILET ROOM ACCESSORIES, DENTAL EQUIPMENT AS REQUIRED.
5. PROVIDE MAKE-UP AIR FOR COMPRESSOR WITH DAMPER TO PROVIDE ONE WAY AIR FLOW INTO DENTAL MECHANICAL ROOM. PROVIDE DUCTED EXHAUST FOR VACUUM PUMP.
6. PROVIDE EXHAUST VENT FOR CLOTHES DRYER AND MAKE-UP AIR REGISTER AS REQUIRED BY CODE (VENT & REGISTER TO HAVE ONE-WAY FLOW DAMPERS).
7. RE: 2/D1 FOR TRASH DROPS

BLOCKING SCHEDULE RE: SHEETS F1 & F2

ITEM	MOUNTING HEIGHT A.F.F.
OPERATORY COAT HOOKS	60"
ALL OTHER COAT HOOKS	54"
LEAD APRON HOOKS	48"
COMMUNICATION BOARD	63"
MAGAZINE RACK	65"
GRAB BARS	33" TO 36"
TOILET PAPER HOLDER	15" MIN. TO BOTTOM, OR 19" MIN. TO CENTER OF SPOOL, VERIFY W/ LOCAL CODE
MILLWORK	AS REQUIRED
GOOD-BYE MIRROR	65"-82" A.F.F.
WALL HUNG FOUNTAIN	BOTTOM OF REFLECTIVE SURFACE TO BE @ 40" A.F.F. 65"-82" A.F.F.

AREA CALCULATIONS

NET AREA OF PROPOSED DENTAL OFFICE = 1,764 S.F.

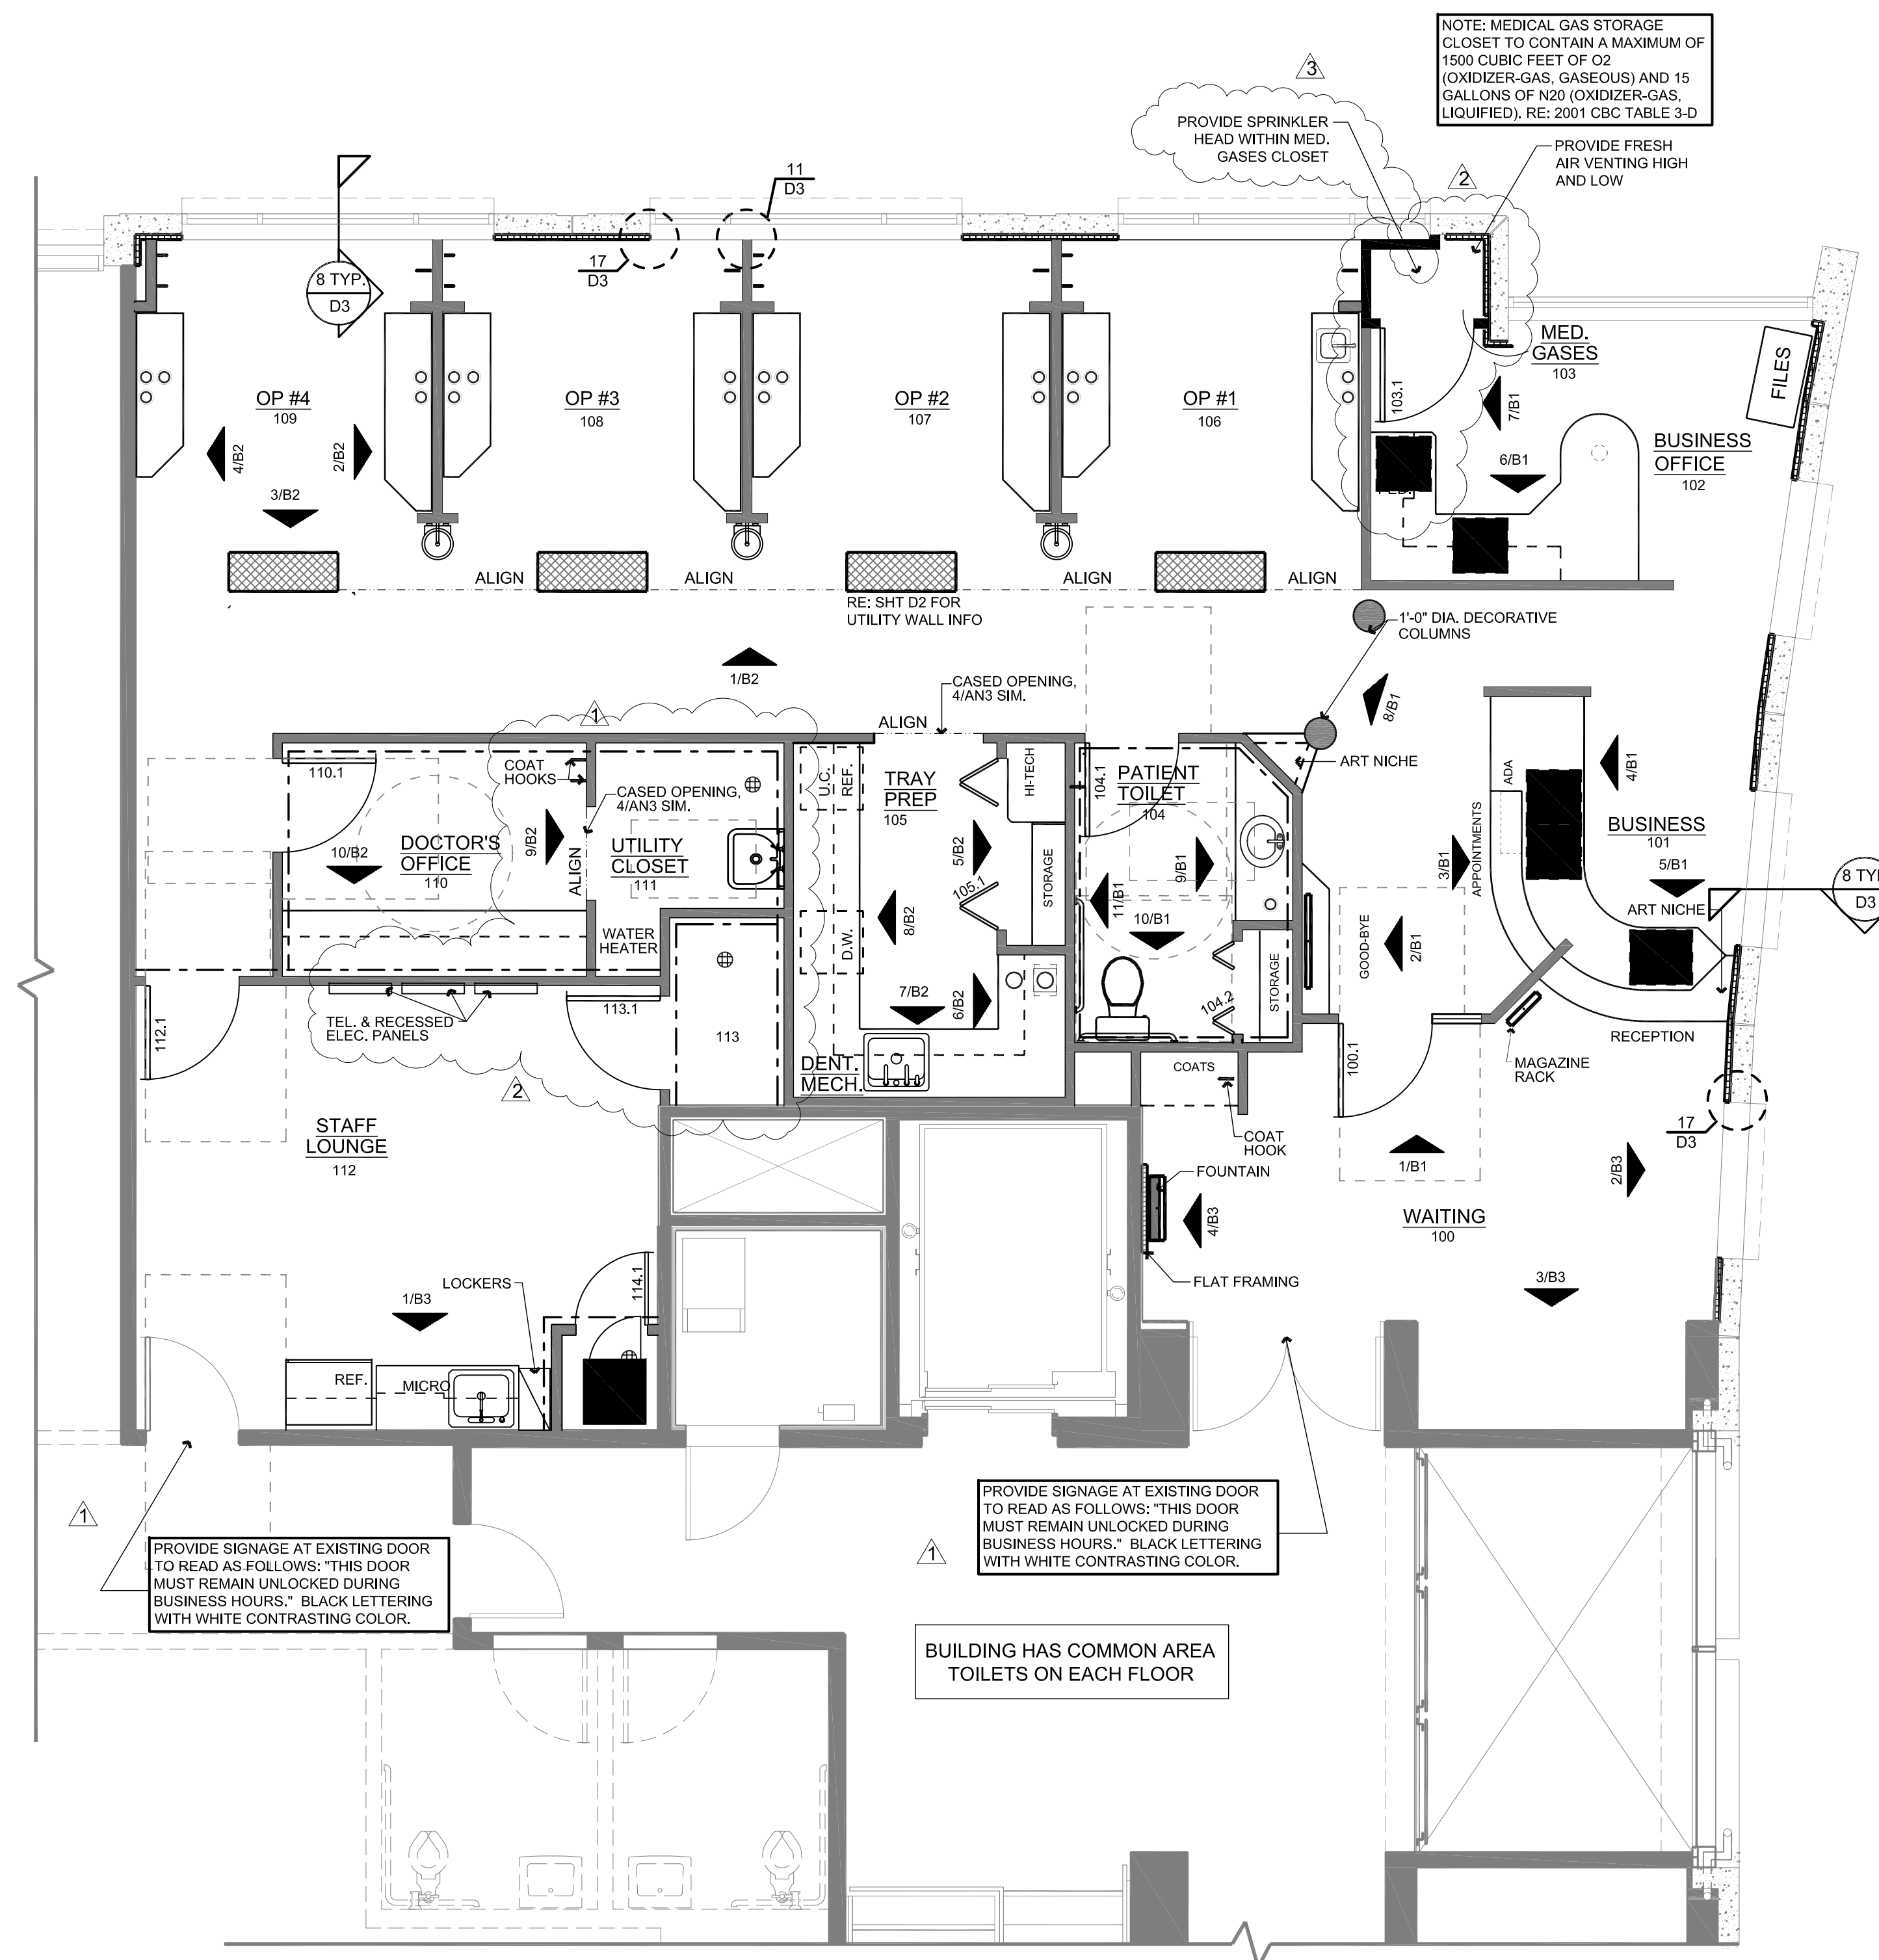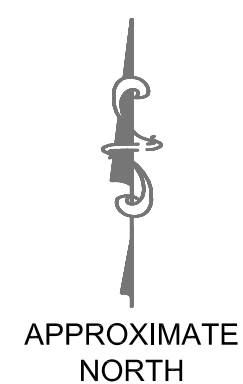

FLOOR PLAN
SCALE: 1/4" = 1'-0"

FAZIO & LEA
ARCHITECTS
300-B CONGRESS AVE., AUSTIN, TX 78701
512-484-0843 TEL 512-484-9941 FAX
WWW.FAZIOLEA.COM

DR. ROY HAYASHI
LAKE FOREST, CALIFORNIA

Project: Dr. Roy Hayashi, Logo, Logo, Logo
512-328-7744 TEL 512-328-7474 FAX
901 SOUTH WOPAC SUITE 420 AUSTIN, TX 78746
WWW.THEDESIGN.COM

ISSUE	DATE
DEC. 6, 2005	
PLAN CHECK #2	01:13:06
FIRE AUTHORITY	01:25:06
FIRE AUTHORITY	02:06:06
FIRE AUTHORITY	02:28:06

SHEET
A1
OF #