


**1416
EAST 11th
STREET**

SUITE
3


TULSA,
OKLAHOMA

041326

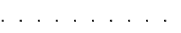

AS-BUILT
PLAN

AS-1

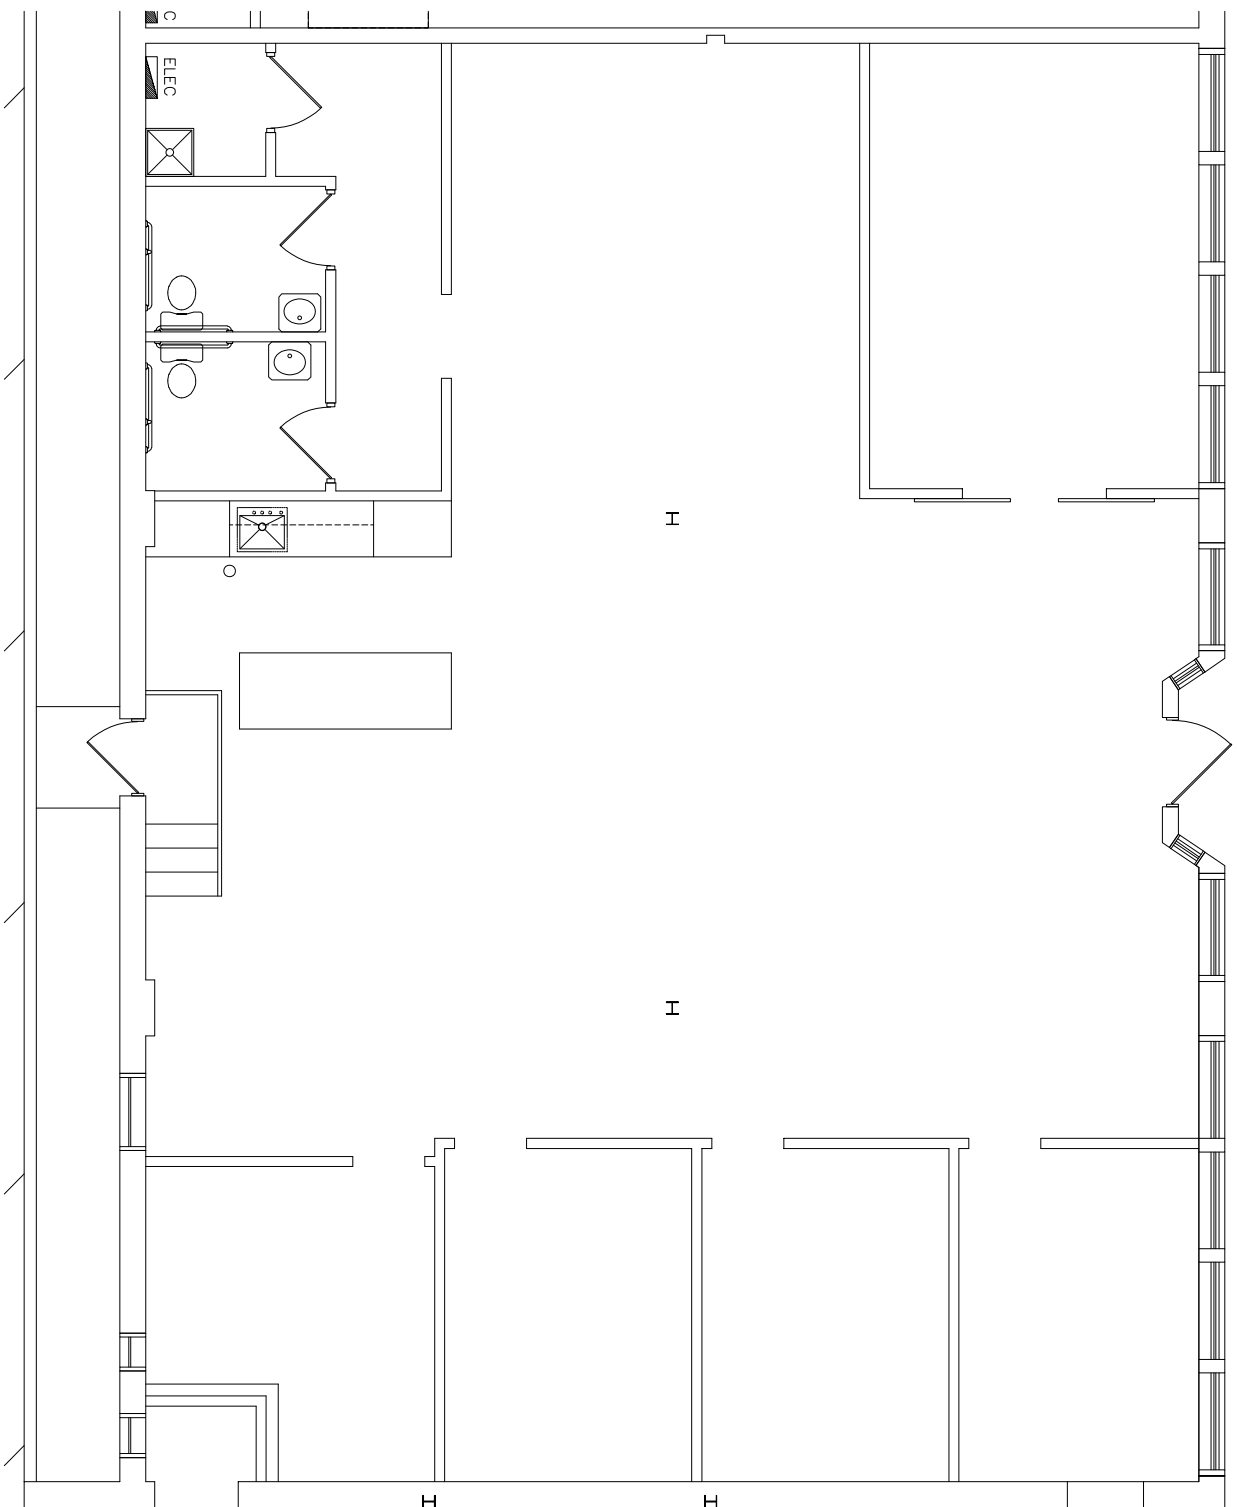


A FLOOR PLAN

SCALE: 1/8" = 1'-0"



NORTH

SUITE 3
2,761.93 U.S.F

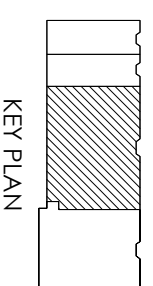

KEY PLAN