

REAL LIFE MINISTRIES

601 N. 4th Street
Coeur d' Alene, Idaho


AS BUILT DRAWINGS



SHEET INDEX

| | |
|------|------------------------|
| A0.0 | COVER SHEET / GIS MAP |
| A1.0 | MAIN LEVEL FLOOR PLAN |
| A1.1 | LOWER LEVEL FLOOR PLAN |
| A1.2 | ROOF PLAN |
| A2.0 | EXTERIOR ELEVATIONS |
| A2.1 | EXTERIOR ELEVATIONS |
| A3.0 | BUILDING SECTIONS |

REVISIONS

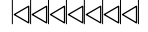

ARTIOS
ARCHITECTURE
COMMUNITY DESIGN
DEVELOPMENT
1929 E. SHADOW WOOD LANE
COEUR D'ALENE, ID 83815
T: (208) 66-5557

REAL LIFE MINISTRIES


610 N. 4TH STREET
COEUR D' ALENE, ID 83814

COVER SHEET
GIS MAP

AS-BUILT DRAWINGS

5-12-2015

A0.0

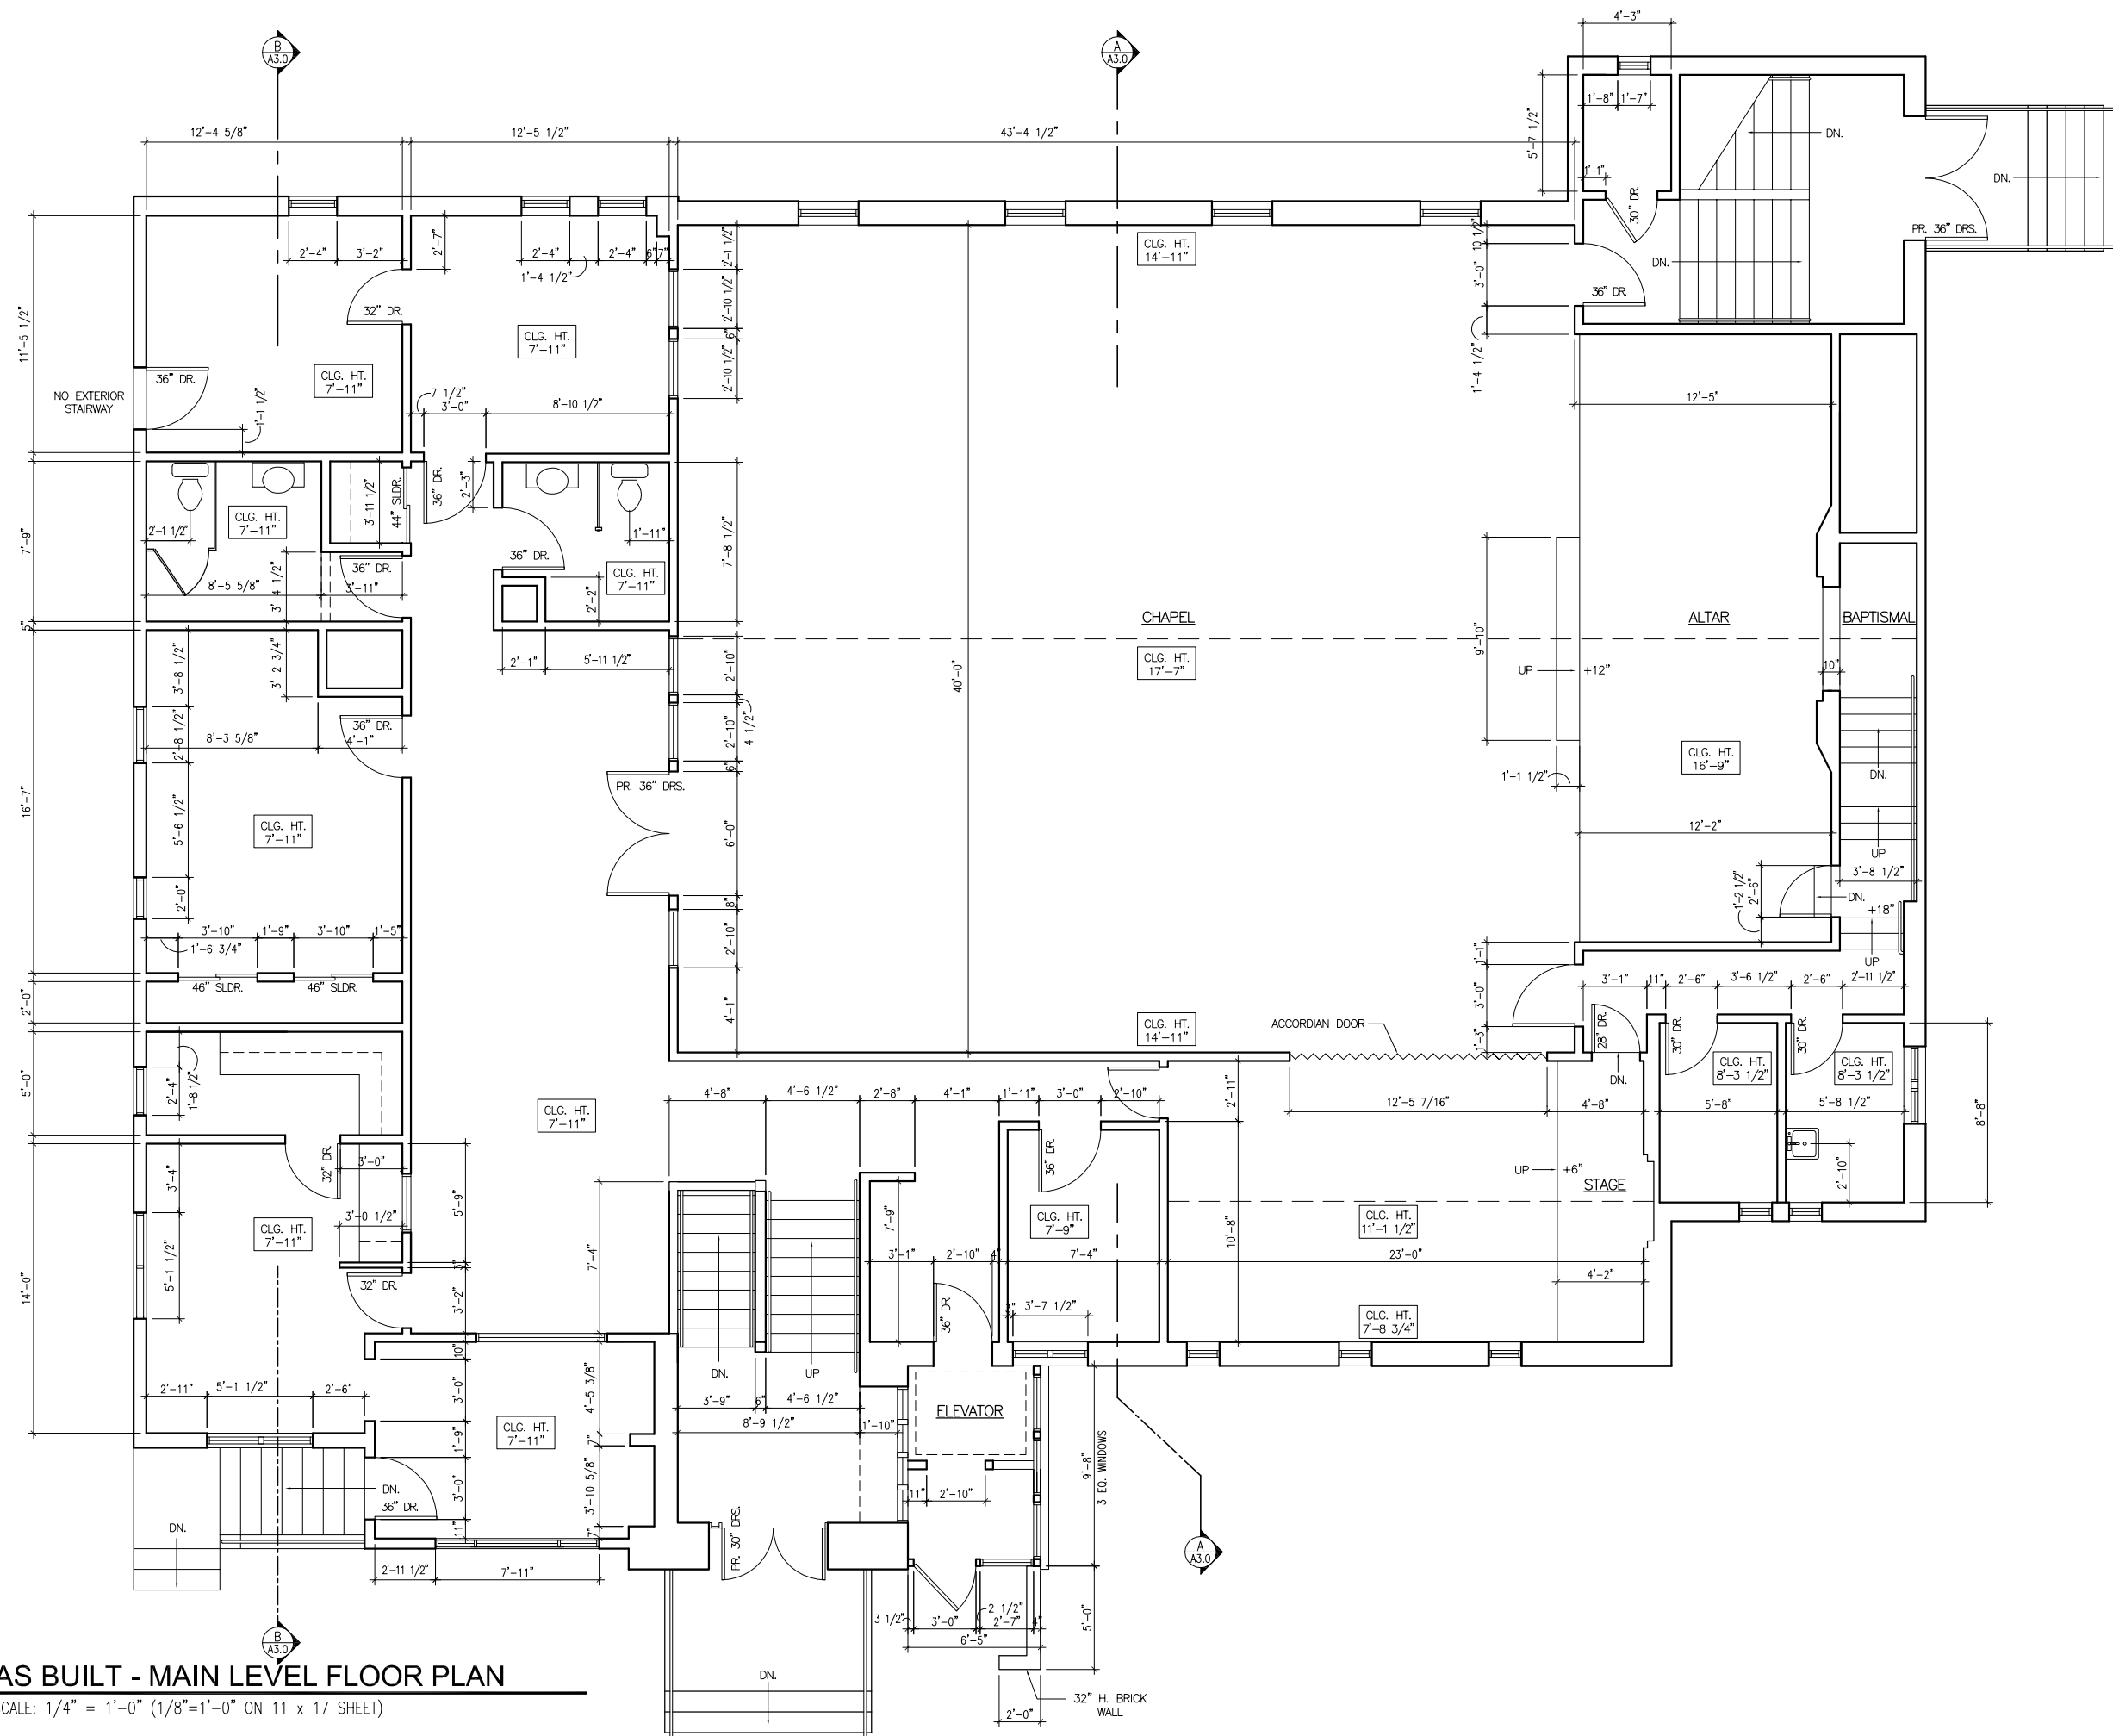

1

AS BUILT - MAIN LEVEL FLOOR PLAN

SCALE: 1/4" = 1'-0" (1/8"=1'-0" ON 11 x 17 SHEET)

| REVISIONS |
|-----------|
| |
| |
ARTIOS
 ARCHITECTURE
 COMMUNITY DESIGN
 DEVELOPMENT
 1029 E. SHADOW WOOD LANE
 COEUR D'ALENE, ID 83815
 T: (208) 66-5557


REAL LIFE MINISTRIES
 610 N. 4TH STREET
 COEUR D'ALENE, ID 83814

**MAIN LEVEL
 FLOOR PLAN**

AS-BUILT DRAWINGS


5-12-2015

A1.0

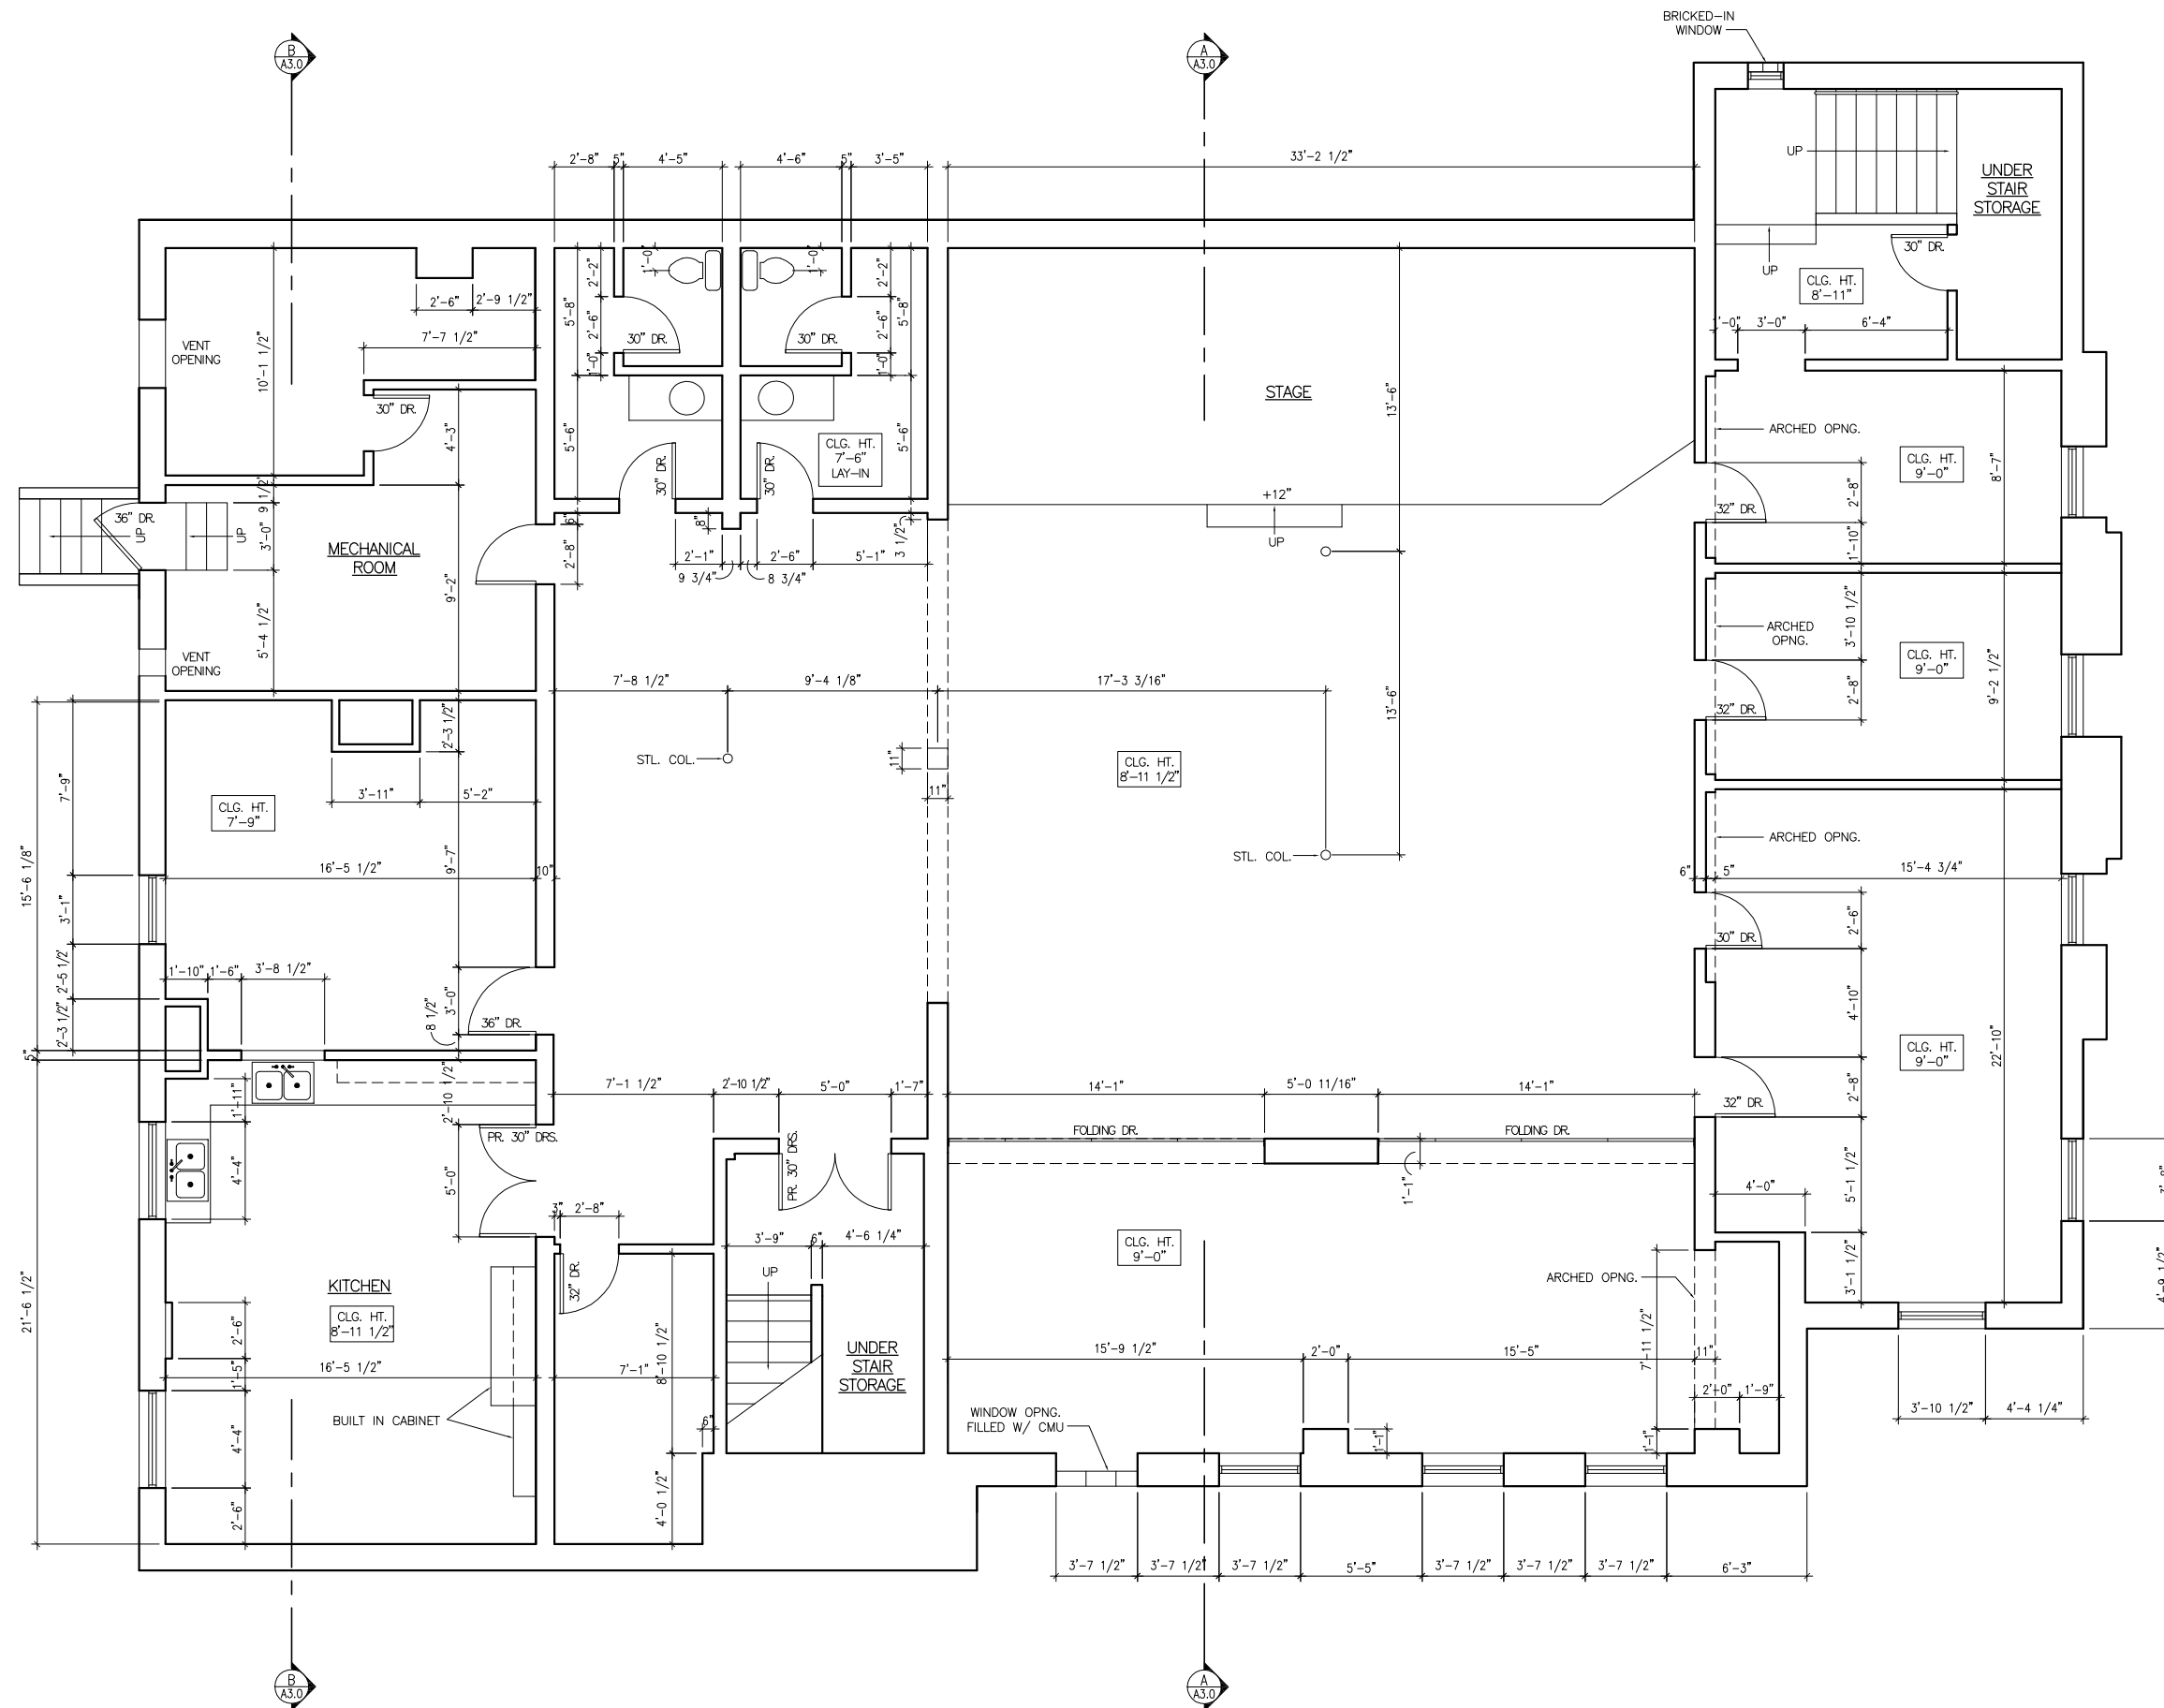

1 AS BUILT - LOWER LEVEL FLOOR PLAN
 SCALE: 1/4" = 1'-0" (1/8"=1'-0" ON 11 x 17 SHEET)

| |
|---|
| <p>REVISIONS</p> <p>◀◀◀◀◀◀</p> |
| <p>ARTIOS</p> <p>ARCHITECTURE COMMUNITY DESIGN DEVELOPMENT</p> <p>1029 E. SHADOW WOOD LANE COEUR D'ALENE, ID 83815 T: (208) 665-5557</p> |
| <p>REAL LIFE MINISTRIES</p> <p>610 N. 4TH STREET COEUR D'ALENE, ID 83814</p> |
| <p>LOWER LEVEL FLOOR PLAN</p> |
| <p>AS-BUILT DRAWINGS</p> <p>5-12-2015</p> |
| <p>A1.1</p> |

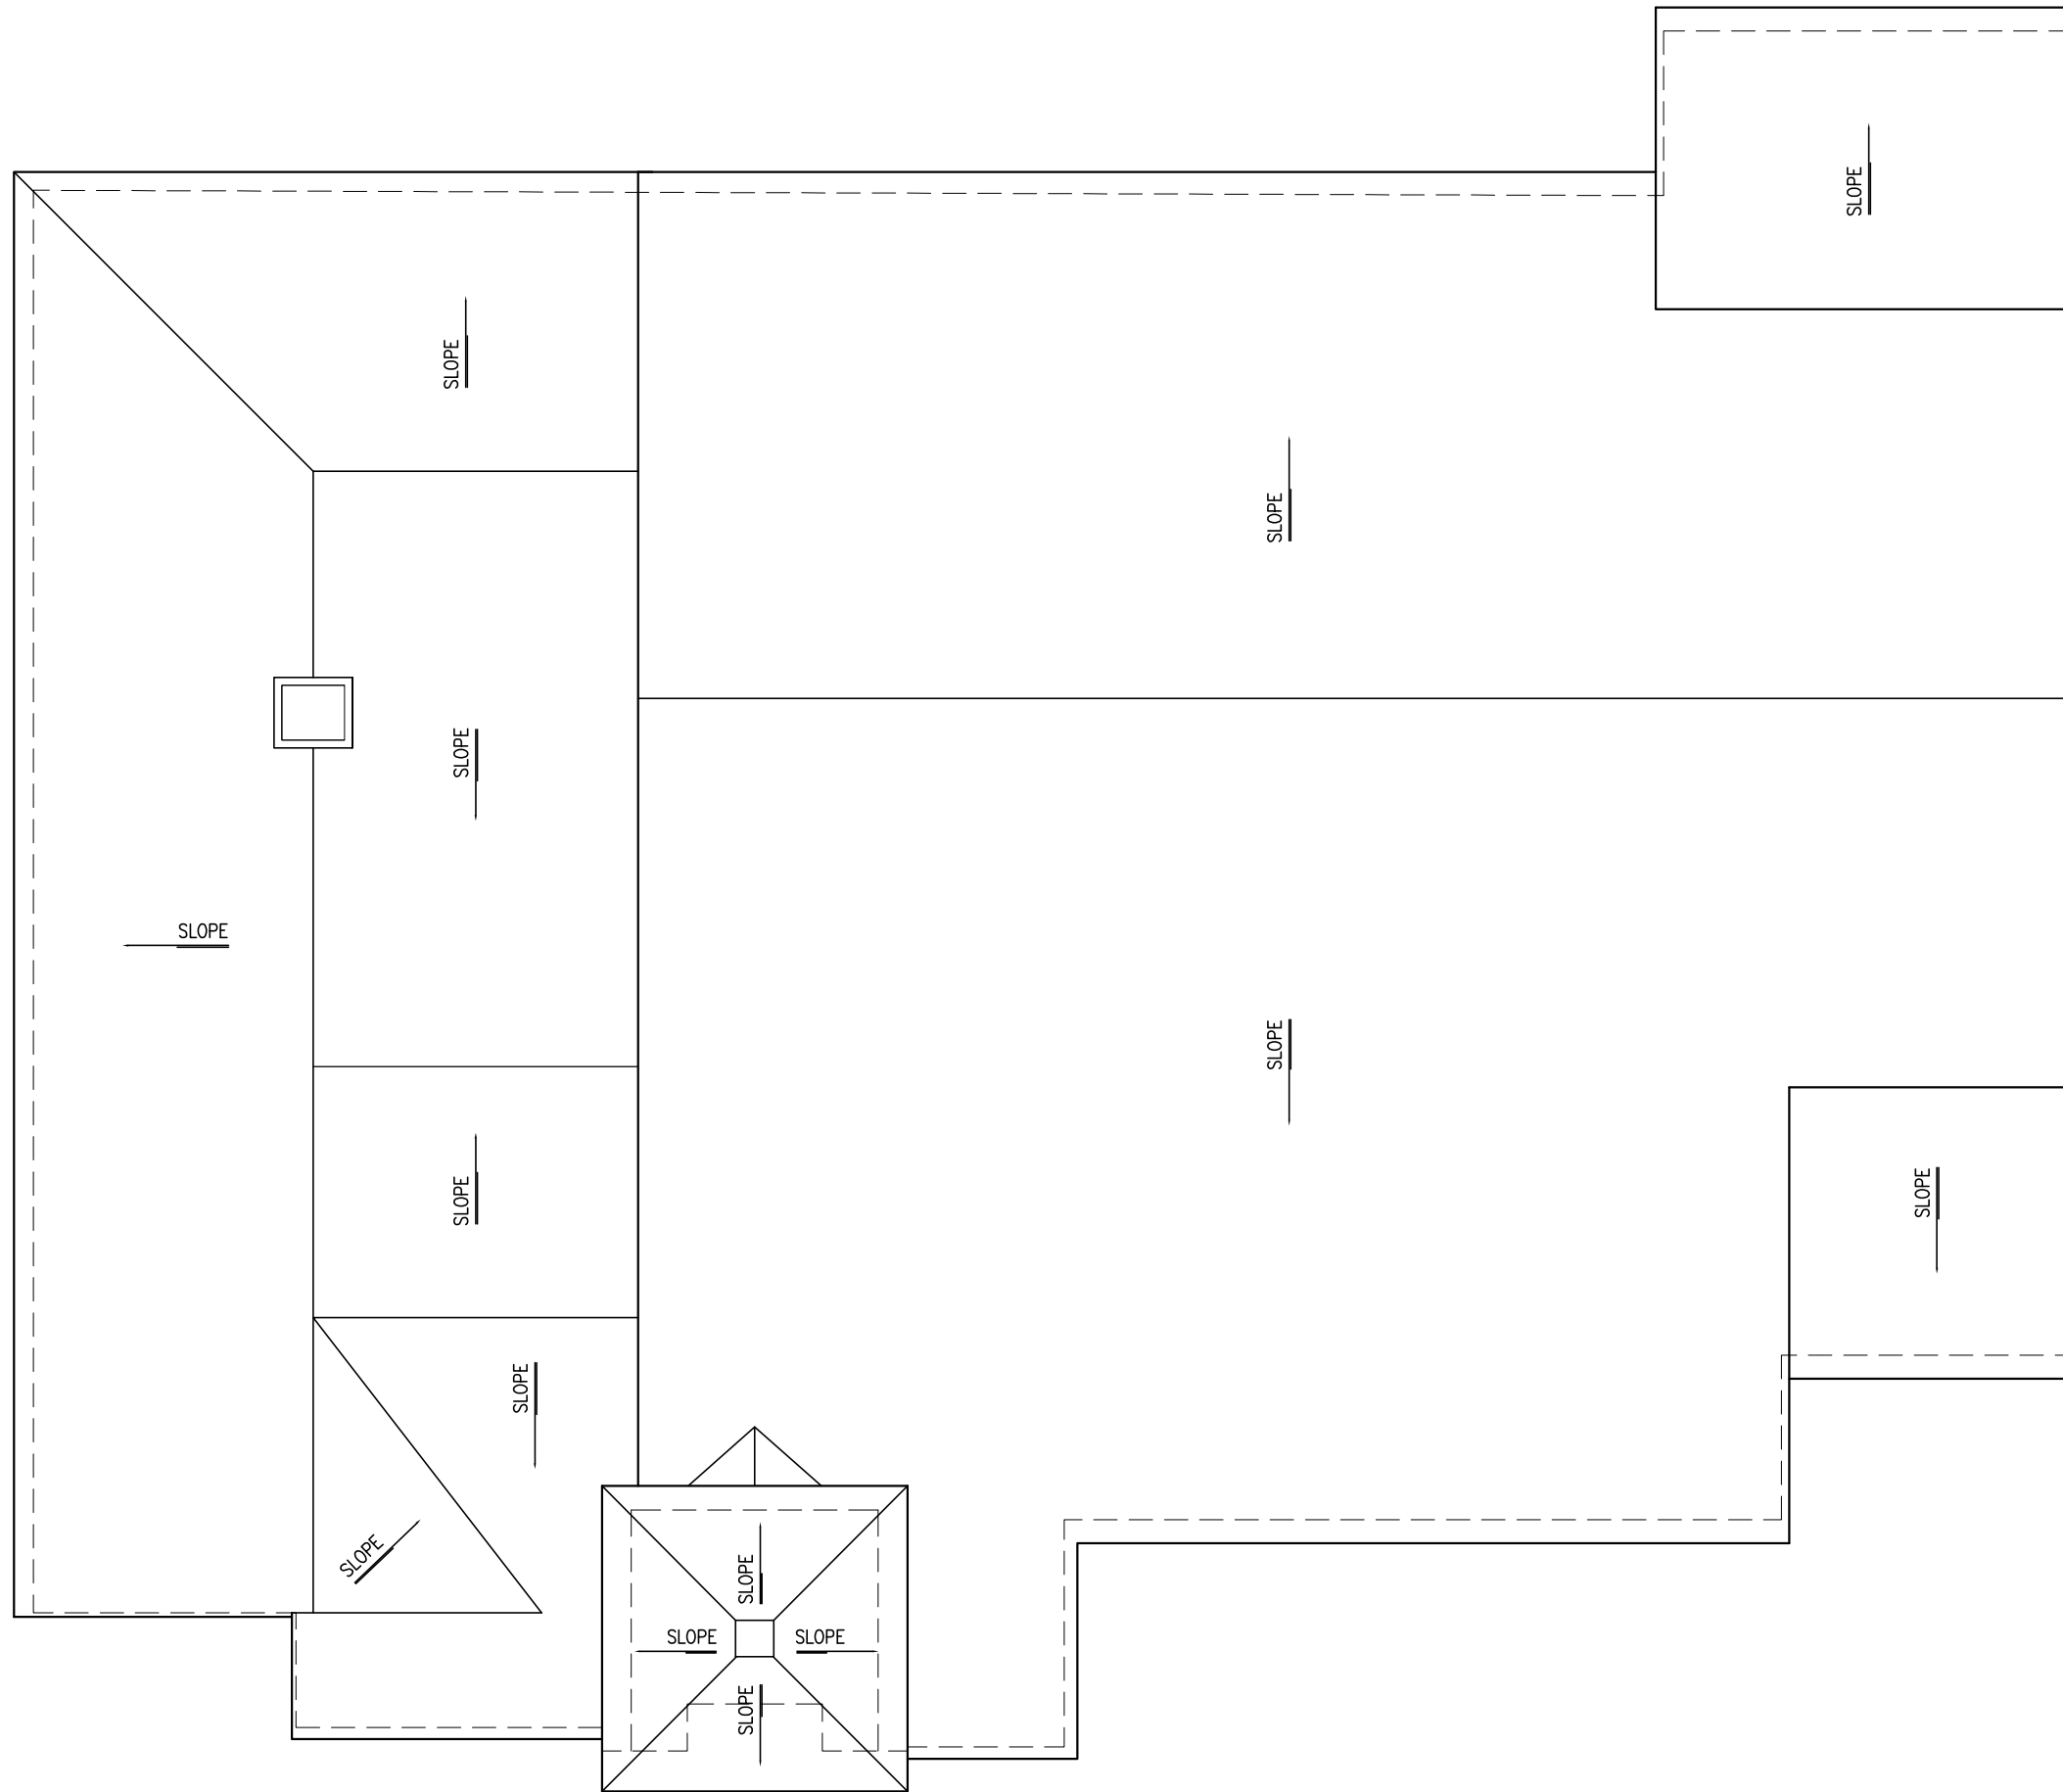


1 AS BUILT - ROOF PLAN
 SCALE: 1/4" = 1'-0" (1/8"=1'-0" ON 11 x 17 SHEET)

| | |
|---|-----------------------|
| REVISIONS | |
| | ROOF PLAN 11/15/15 |
| A R T I O S ARCHITECTURE COMMUNITY DESIGN DEVELOPMENT <small>1929 E. SHADOW WOOD LANE COEUR D'ALENE, ID 83815 T: (208) 66-5557</small> | |
| REAL LIFE MINISTRIES 610 N. 4TH STREET COEUR D'ALENE, ID 83814 | |
| ROOF PLAN | |
| AS-BUILT DRAWINGS | |
| 5-12-2015 | |
| A1.2 | |




1 AS BUILT - WEST ELEVATION
SCALE: 1/4" = 1'-0" (1/8"=1'-0" ON 11 x 17 SHEET)

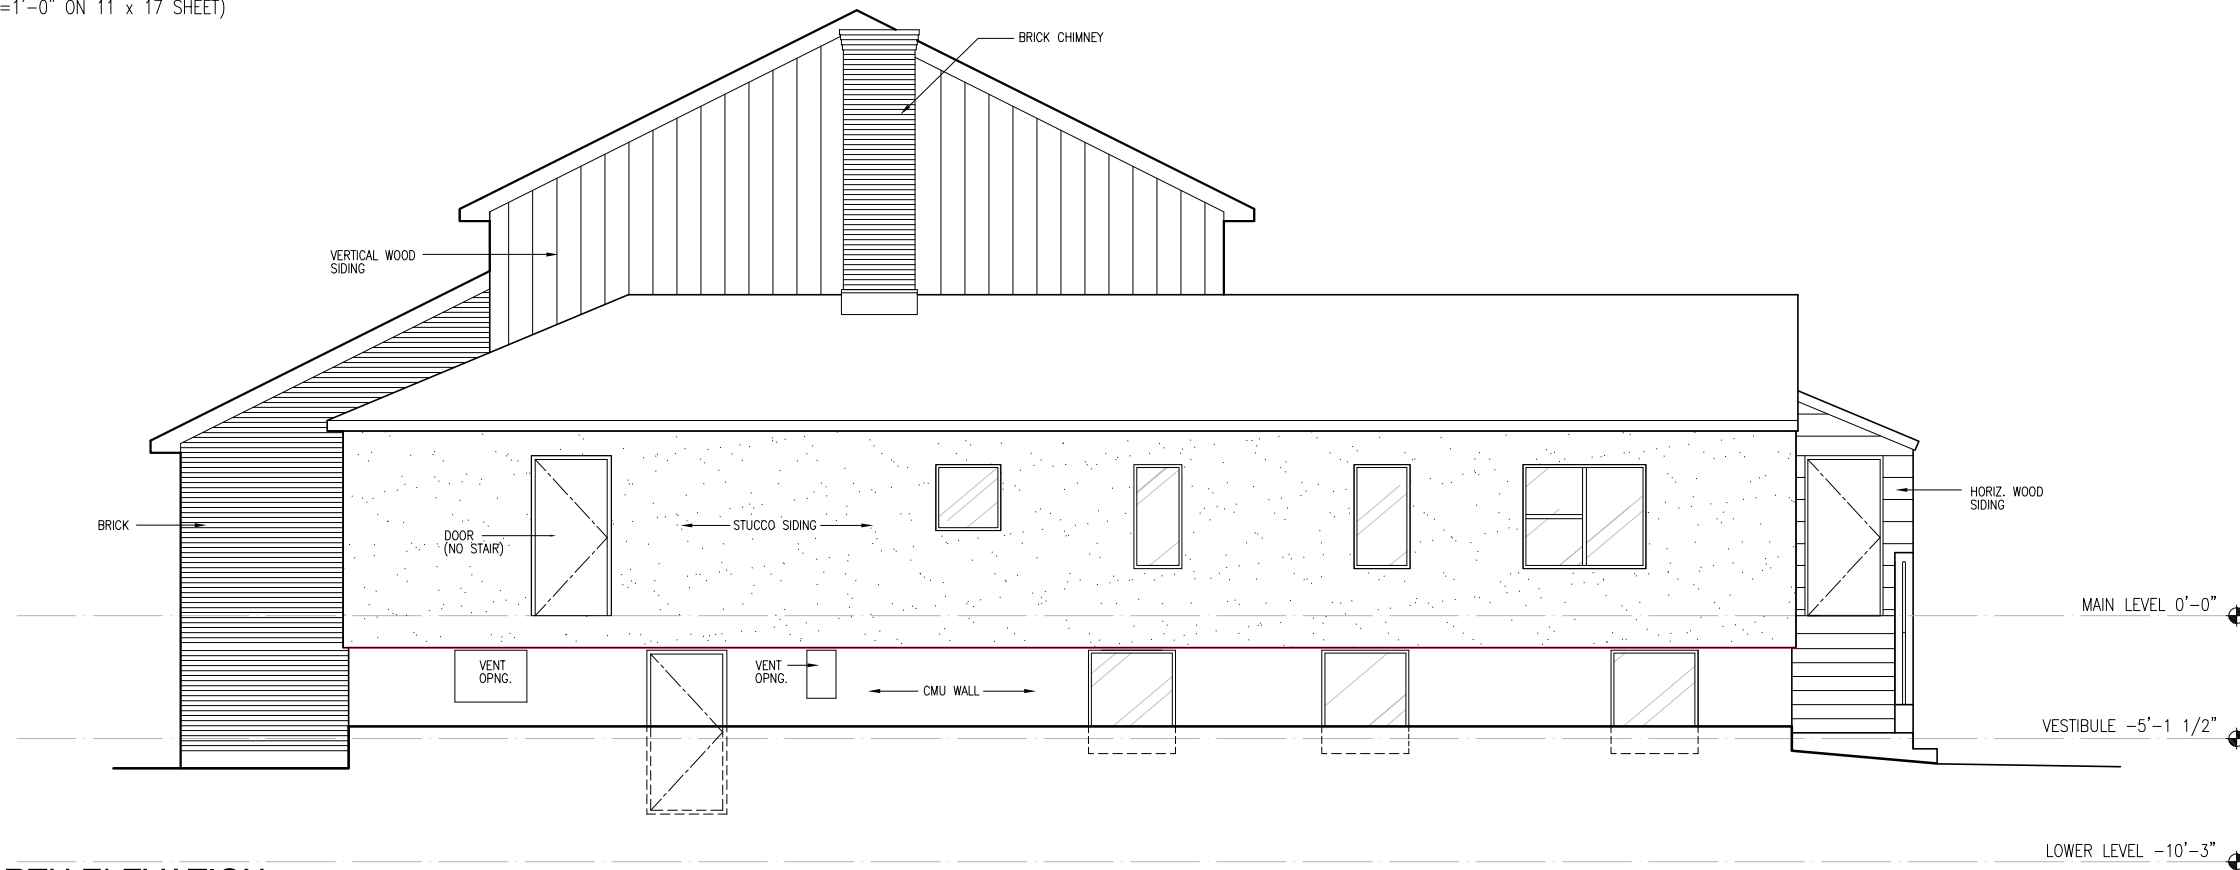

2 AS BUILT - NORTH ELEVATION
SCALE: 1/4" = 1'-0" (1/8"=1'-0" ON 11 x 17 SHEET)

 REVISIONS



ARTIOS
ARCHITECTURE
COMMUNITY DESIGN
DEVELOPMENT
1029 E. SHADOW WOOD LANE
COEUR D'ALENE, ID 83815
T: (208) 66-5557

REAL LIFE MINISTRIES


610 N. 4TH STREET
COEUR D'ALENE, ID 83814

EXTERIOR ELEVATIONS


AS-BUILT DRAWINGS

5-12-2015

A2.0

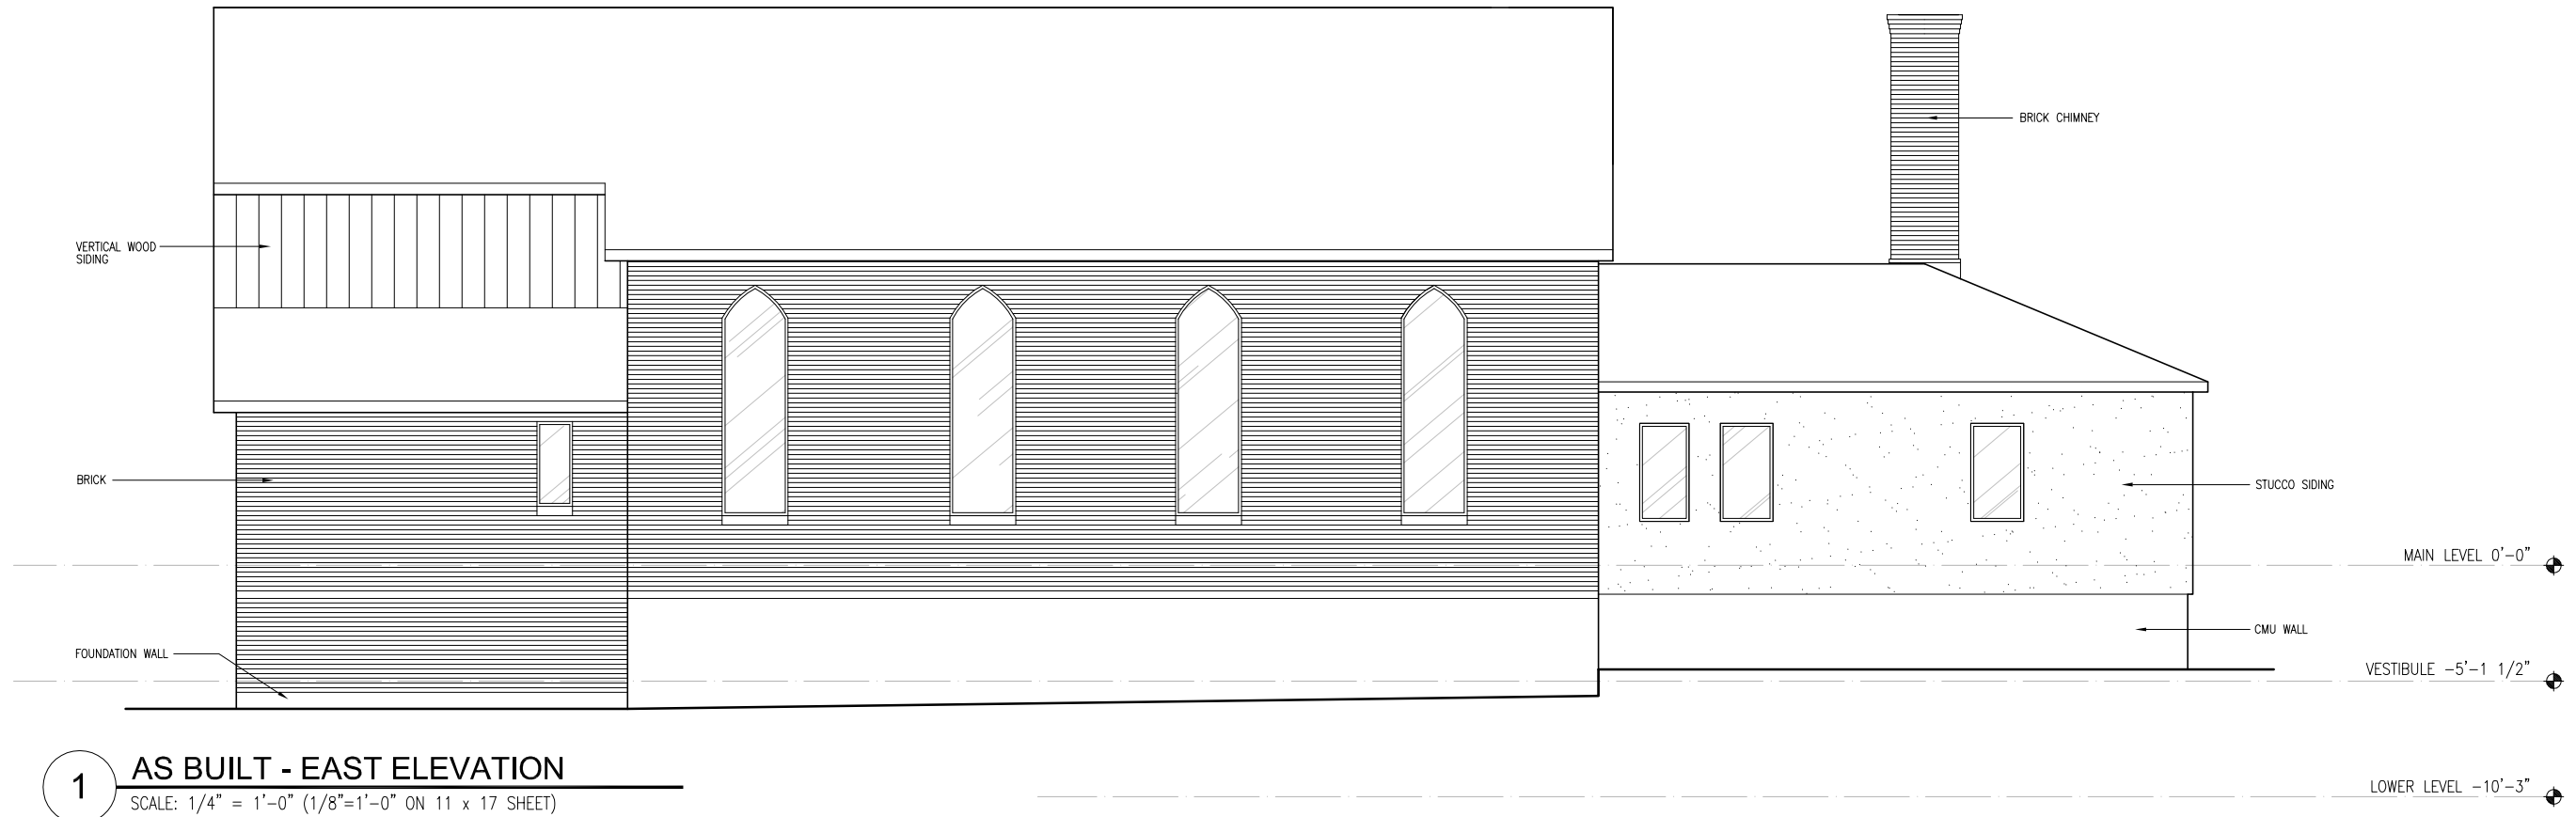

1 AS BUILT - EAST ELEVATION
 SCALE: 1/4" = 1'-0" (1/8"=1'-0" ON 11 x 17 SHEET)

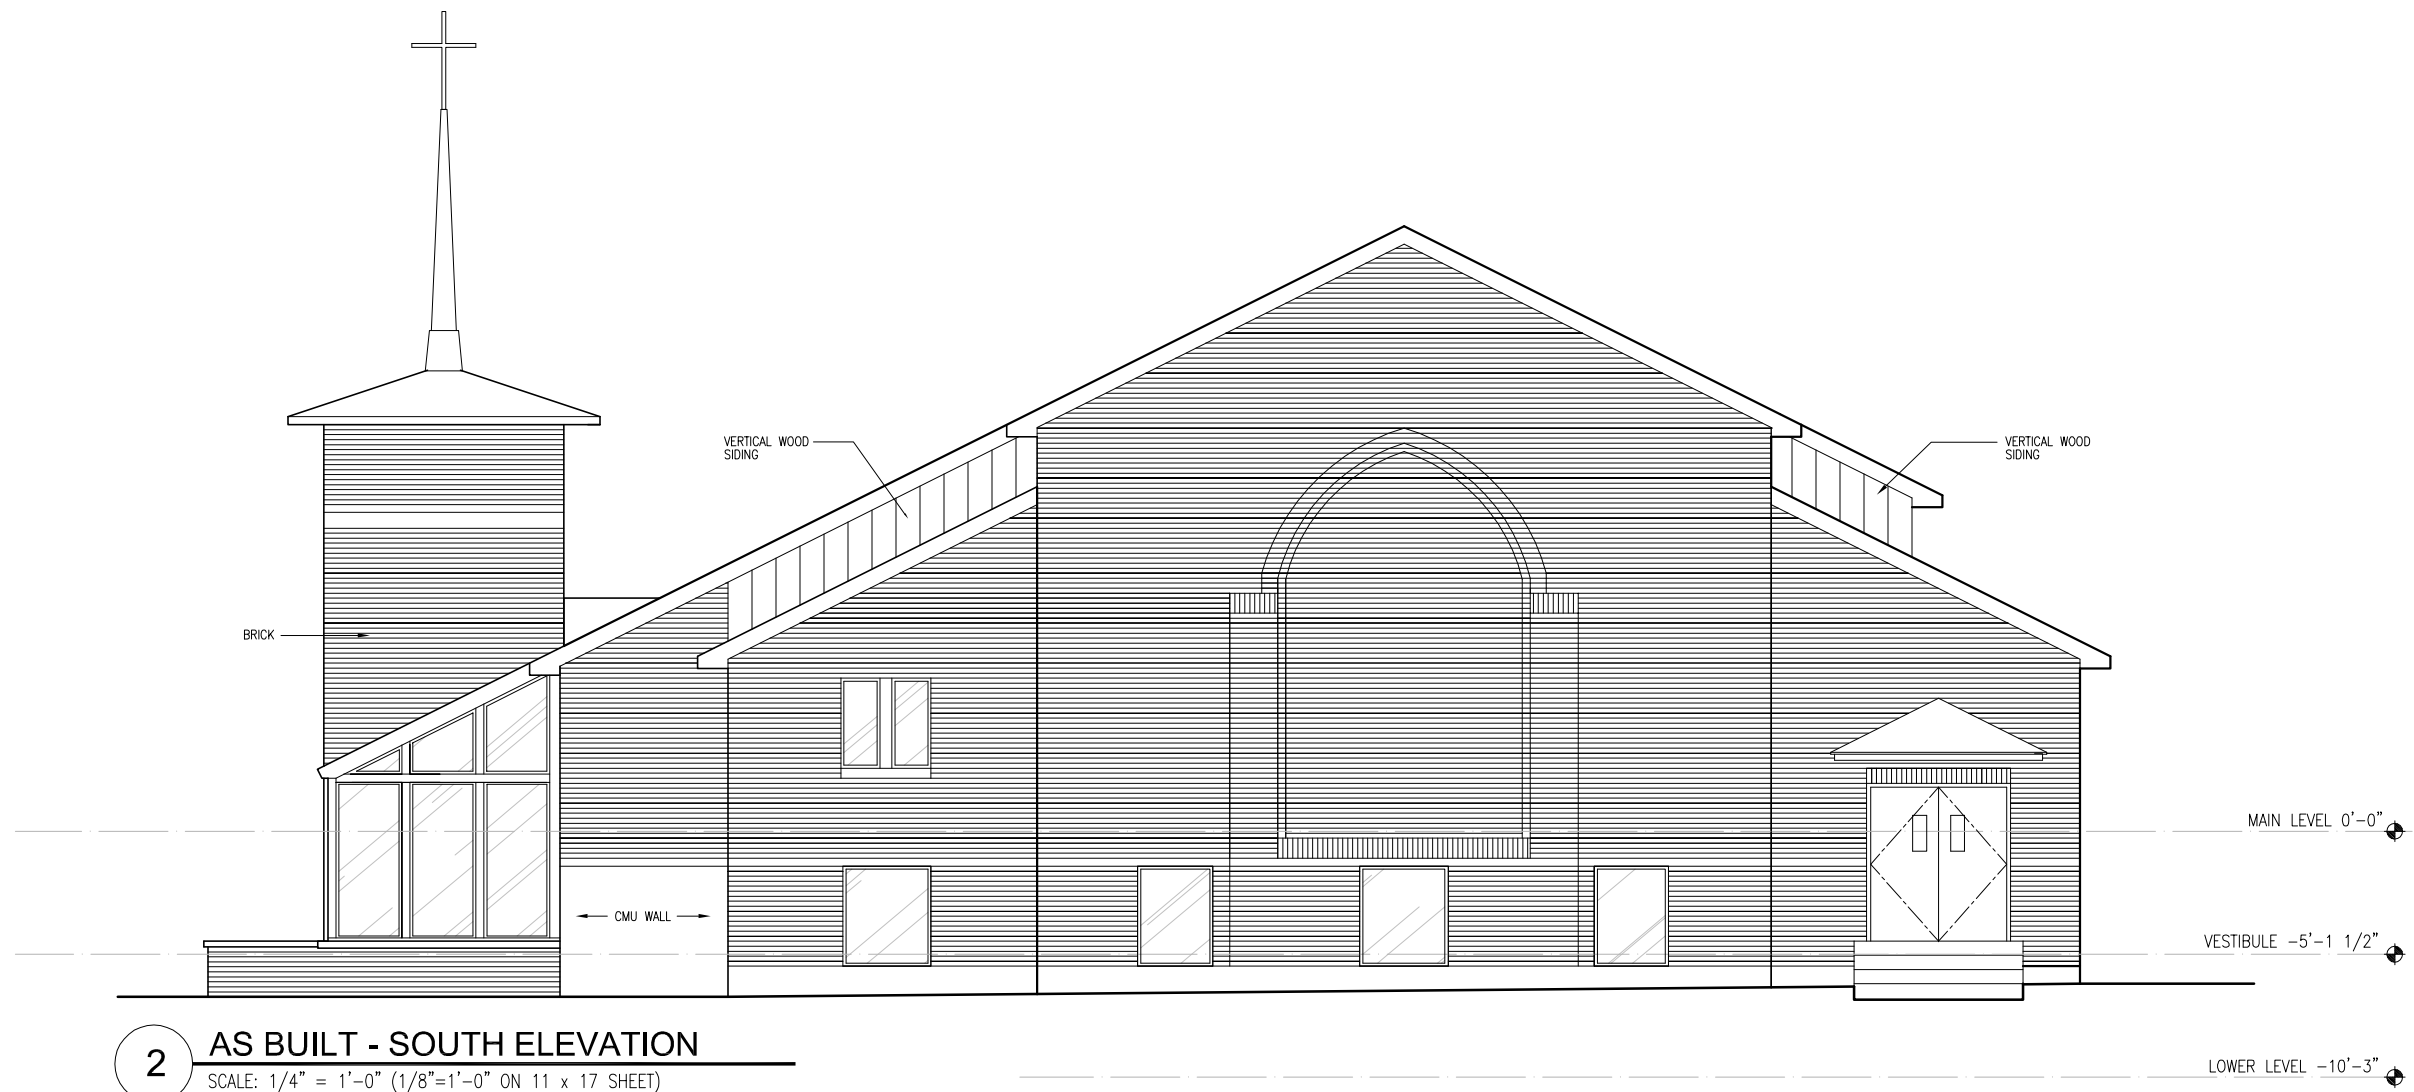

2 AS BUILT - SOUTH ELEVATION
 SCALE: 1/4" = 1'-0" (1/8"=1'-0" ON 11 x 17 SHEET)

| | | | | | | | | | | | | | | | | | | | | |
|---|--|--|--|--|--|--|--|--|--|--|--|--|--|--|--|--|--|--|--|--|
| REVISIONS | | | | | | | | | | | | | | | | | | | | |
| <table border="1"> <tr><td> </td><td> </td><td> </td><td> </td><td> </td><td> </td><td> </td><td> </td><td> </td><td> </td></tr> <tr><td> </td><td> </td><td> </td><td> </td><td> </td><td> </td><td> </td><td> </td><td> </td><td> </td></tr> </table> | | | | | | | | | | | | | | | | | | | | | | | |


ARTIOS
 ARCHITECTURE
 COMMUNITY DESIGN
 DEVELOPMENT
 1829 E. SHADOW WOOD LANE
 COEUR D'ALENE, ID 83815
 T: (208) 66-5557

REAL LIFE MINISTRIES
 610 N. 4TH STREET
 COEUR D'ALENE, ID 83814


EXTERIOR ELEVATIONS

AS-BUILT DRAWINGS
 5-12-2015

A2.0

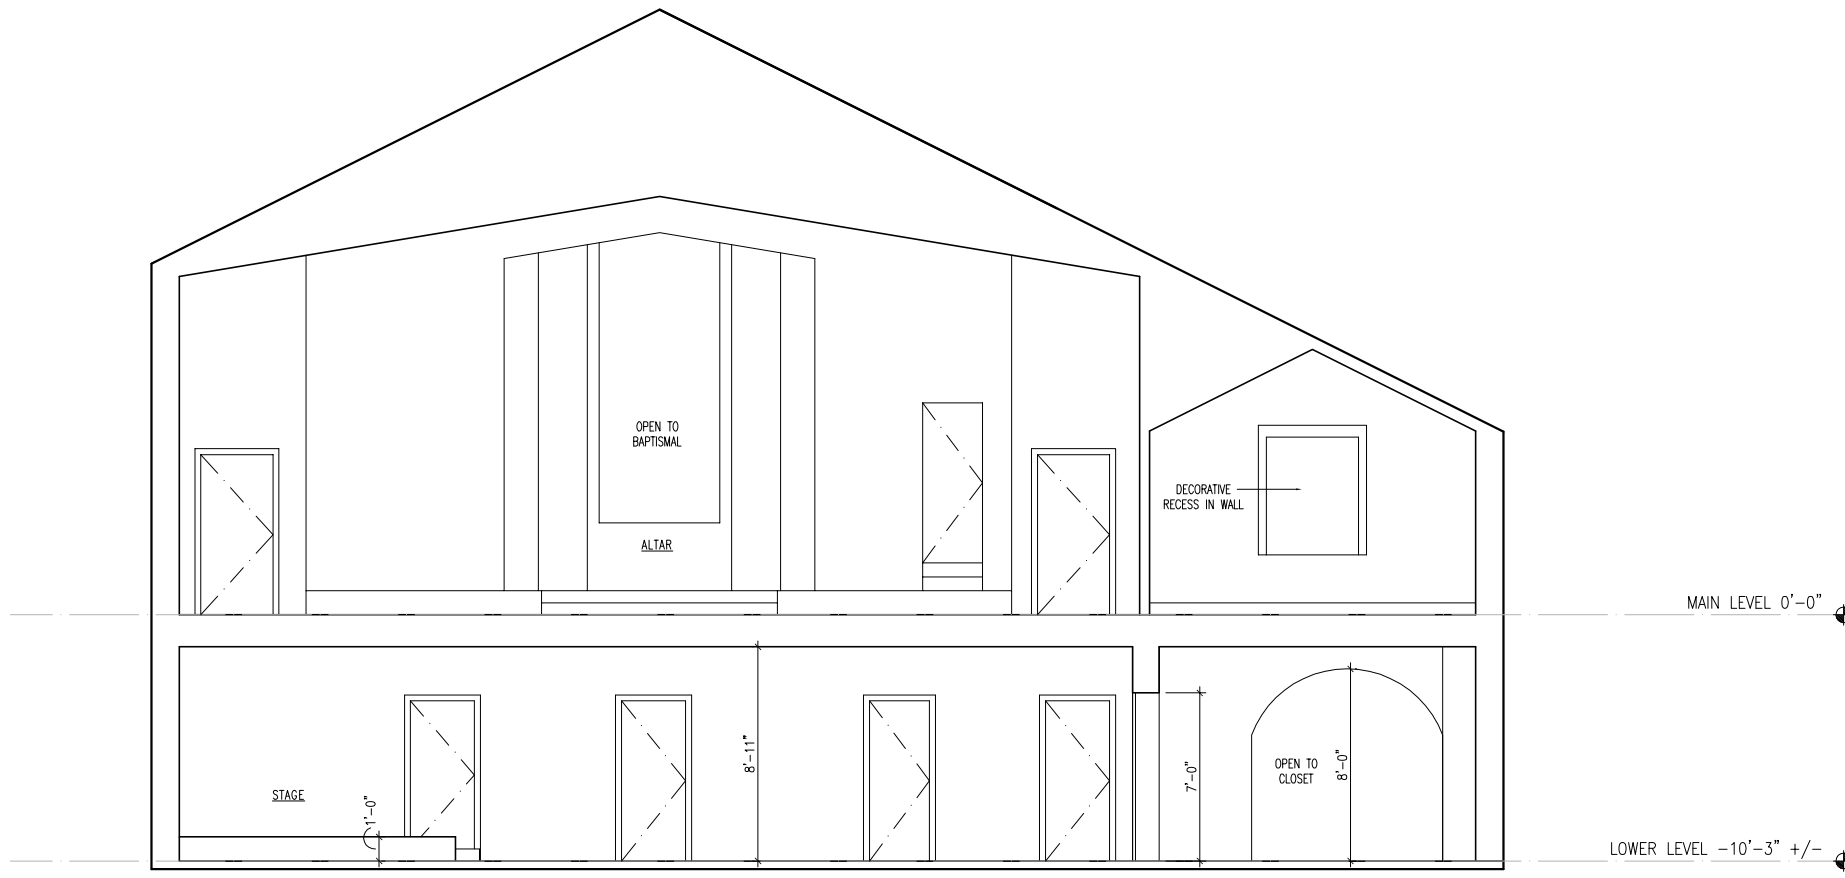

1 AS - BUILT SECTION A-A
 SCALE: 1/4" = 1'-0" (1/8"=1'-0" ON 11 x 17 SHEET)

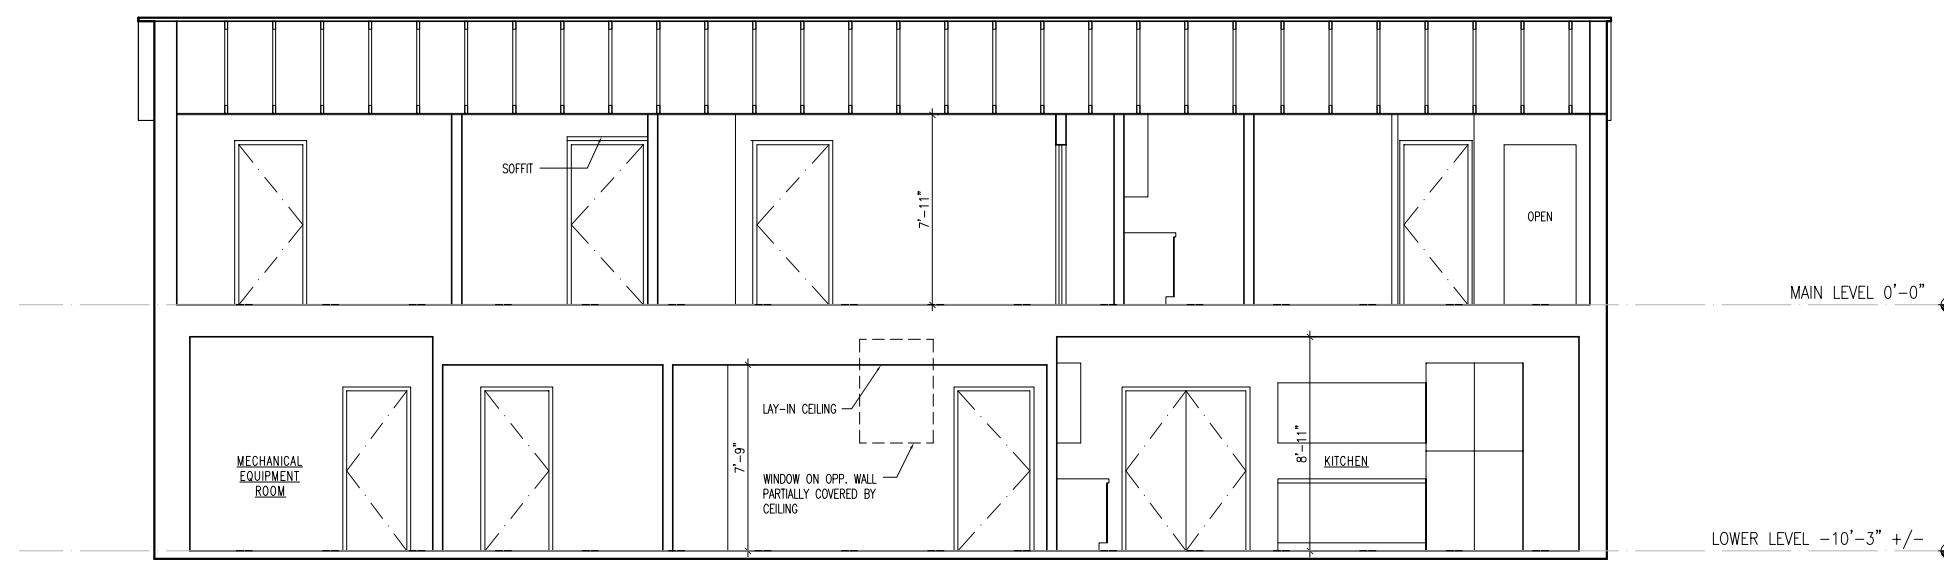

2 AS - BUILT SECTION B-B
 SCALE: 1/4" = 1'-0" (1/8"=1'-0" ON 11 x 17 SHEET)

| |
|--|
| REVISIONS |
| <div style="display: flex; justify-content: space-between;"> ◀ ◀ ◀ ◀ ◀ ◀ </div> |
| ARTIOS ARCHITECTURE COMMUNITY DESIGN DEVELOPMENT <small>1029 E. SHADOW WOOD LANE COEUR D'ALENE, ID 83815 T: (208) 66-5557</small> |
| REAL LIFE MINISTRIES 610 N. 4TH STREET COEUR D'ALENE, ID 83814 |
| BUILDING SECTIONS |
| AS-BUILT DRAWINGS |
| 5-12-2015 |
| A3.0 |