



EXISTING
BUILDING

EXISTING
BUILDING

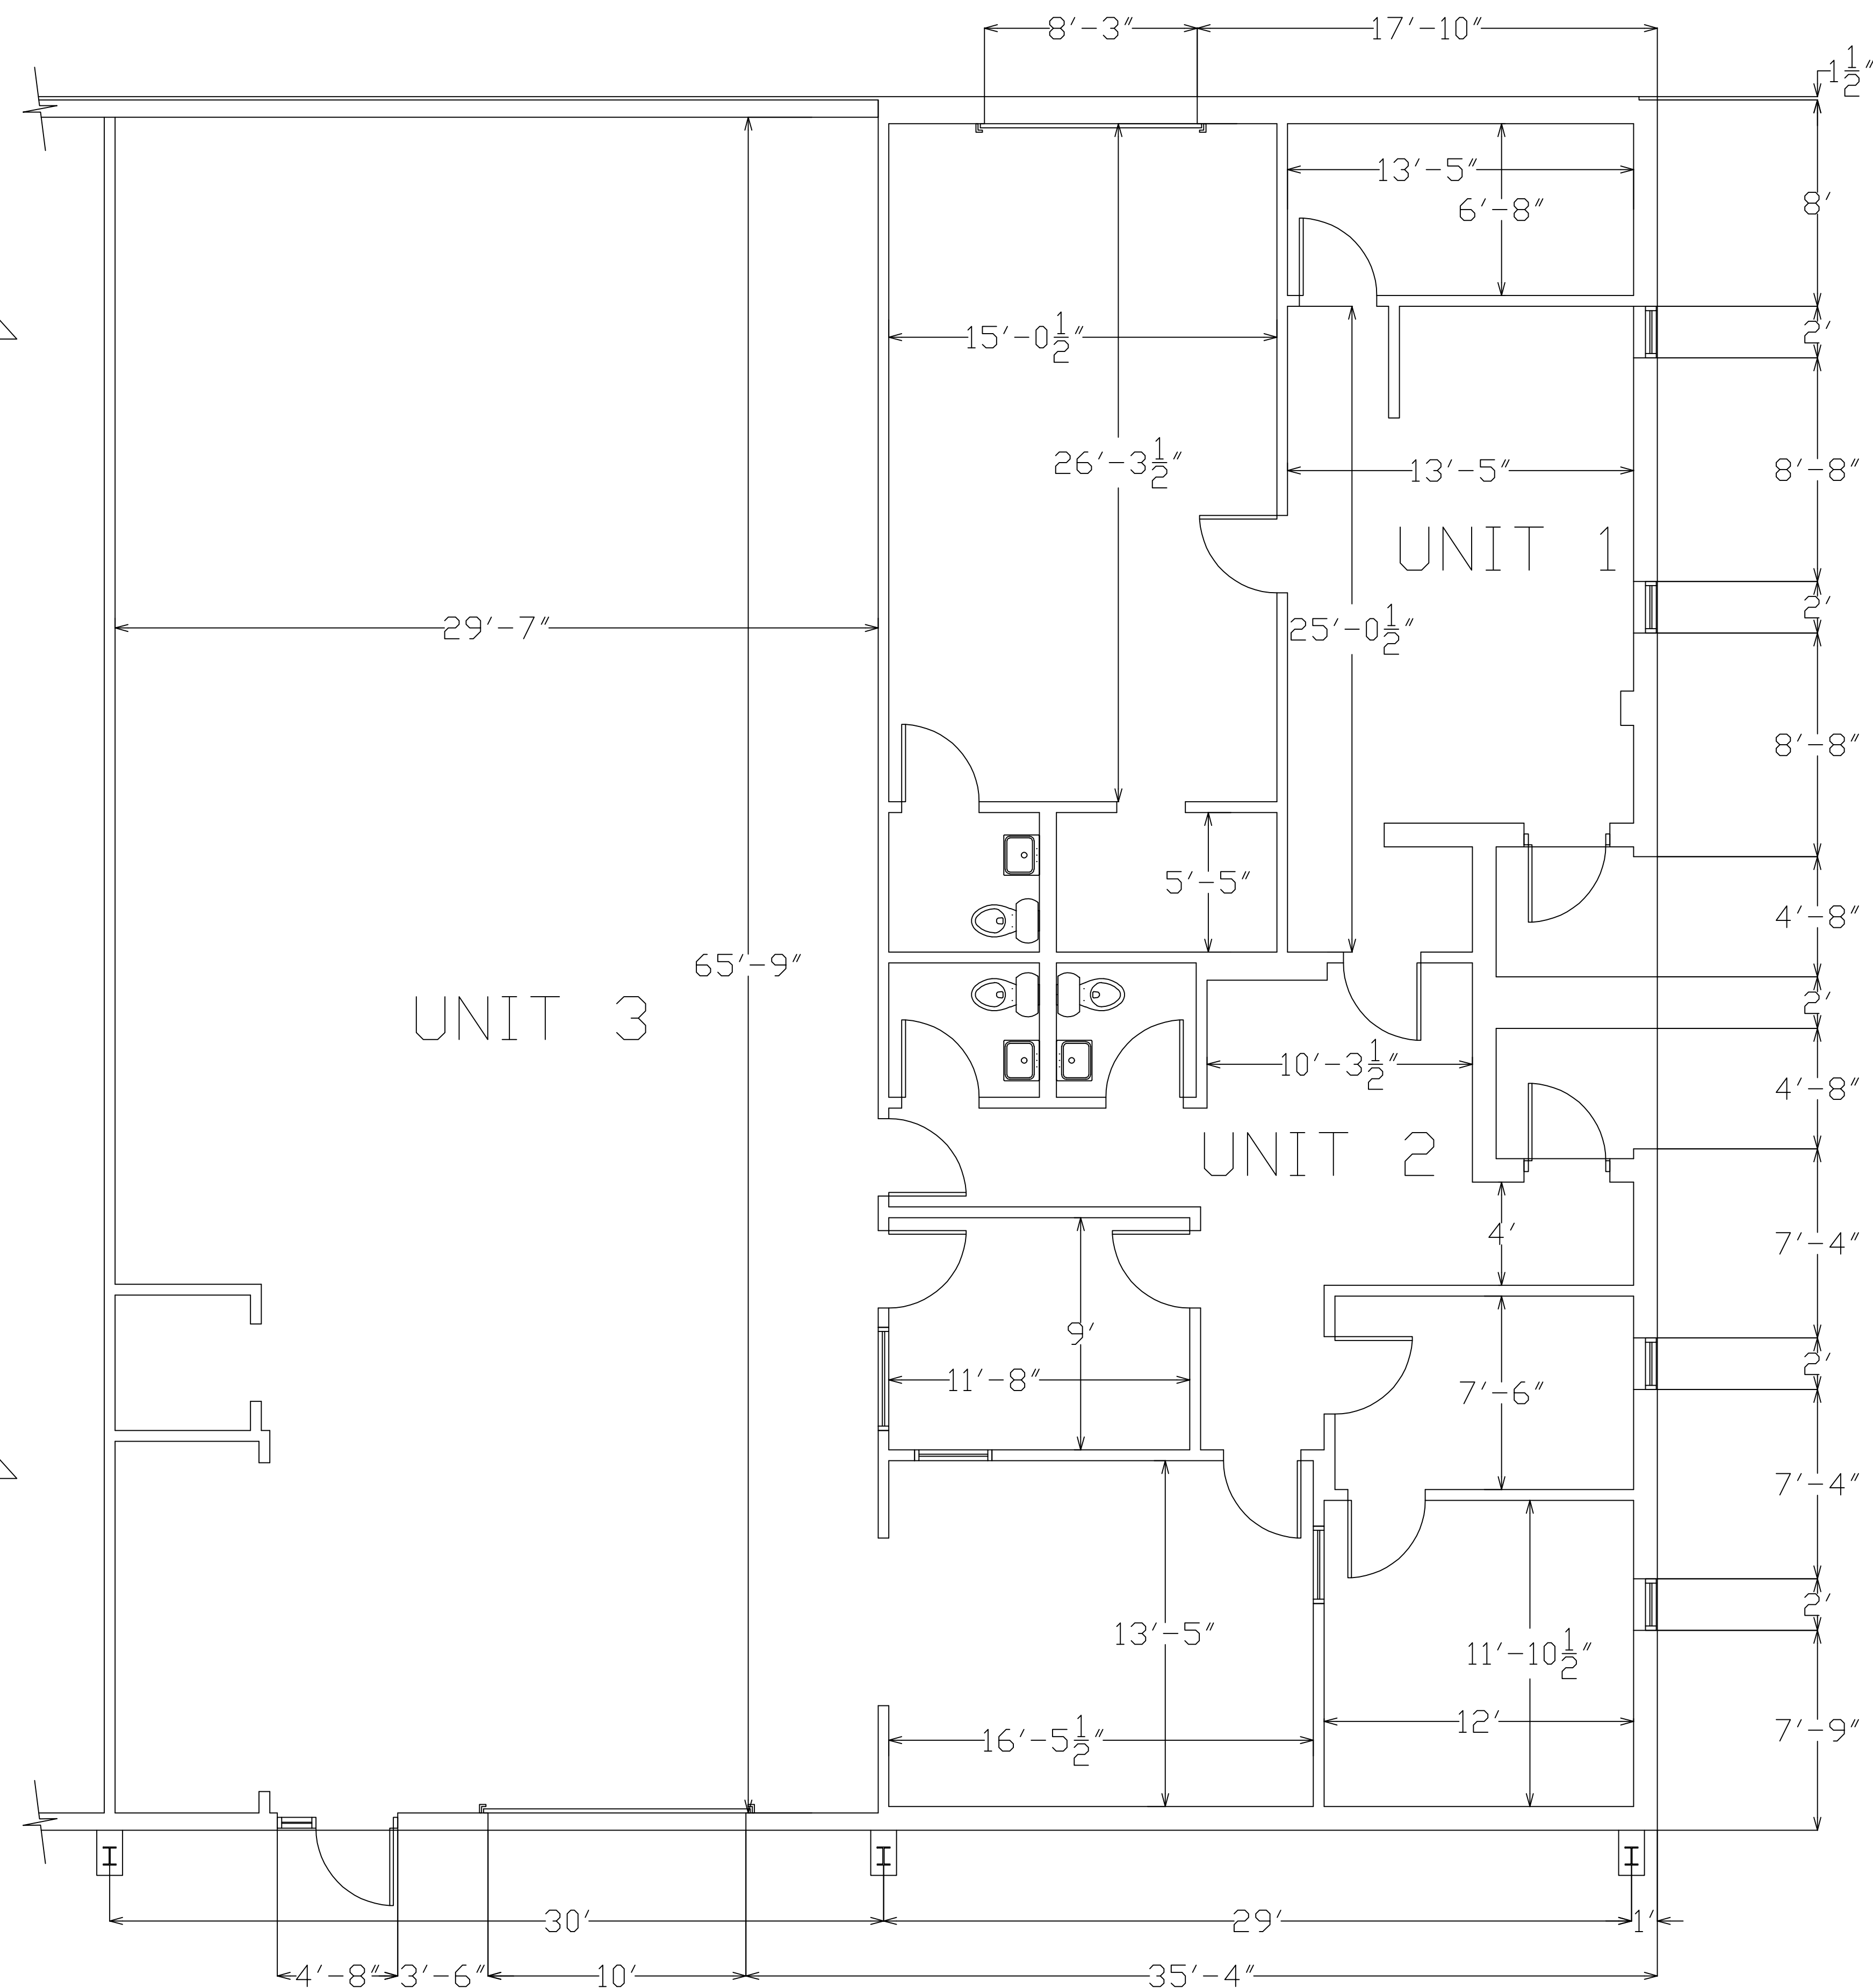

1 EXISTING PARTIAL FLOOR PLAN
UNIT 1= 907sf TOTAL
UNITS 2&3= 2,875sf TOTAL
TOTAL= 3,782sf

110 Elm Street
Bridgewater, MA 02324

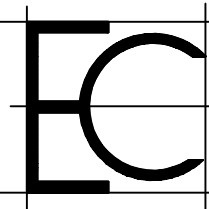

Existing Conditions Surveys Inc.

398 Columbus Avenue # 334
Boston, MA 02118 USA

T 617.247.9181

F 617.249.0748

E info@existingconditions.com

WWW.existingconditions.com

The Most Accurate
Existing Conditions Surveys and
As-Built Surveys

All projects are measured using the most
advanced laser measuring equipment and our
best standards and practices. Visit
WWW.existingconditions.com for terms
conditions of use.

No.	Revision/Issue	Date

Existing Conditions
Partial Floor Plan
Units 1,2,3

Date 05-16-2012

Scale 1/4"=1'-0"

Job No.

Drawn By JES

EX-1