





VARADY
ASSOCIATES
INC.
 INTERIOR DESIGN

30400 TELEGRAPH · SUITE 120
 BINGHAM FARMS, · MI · 48025
 248·644·3990 FAX: 248·644·3952

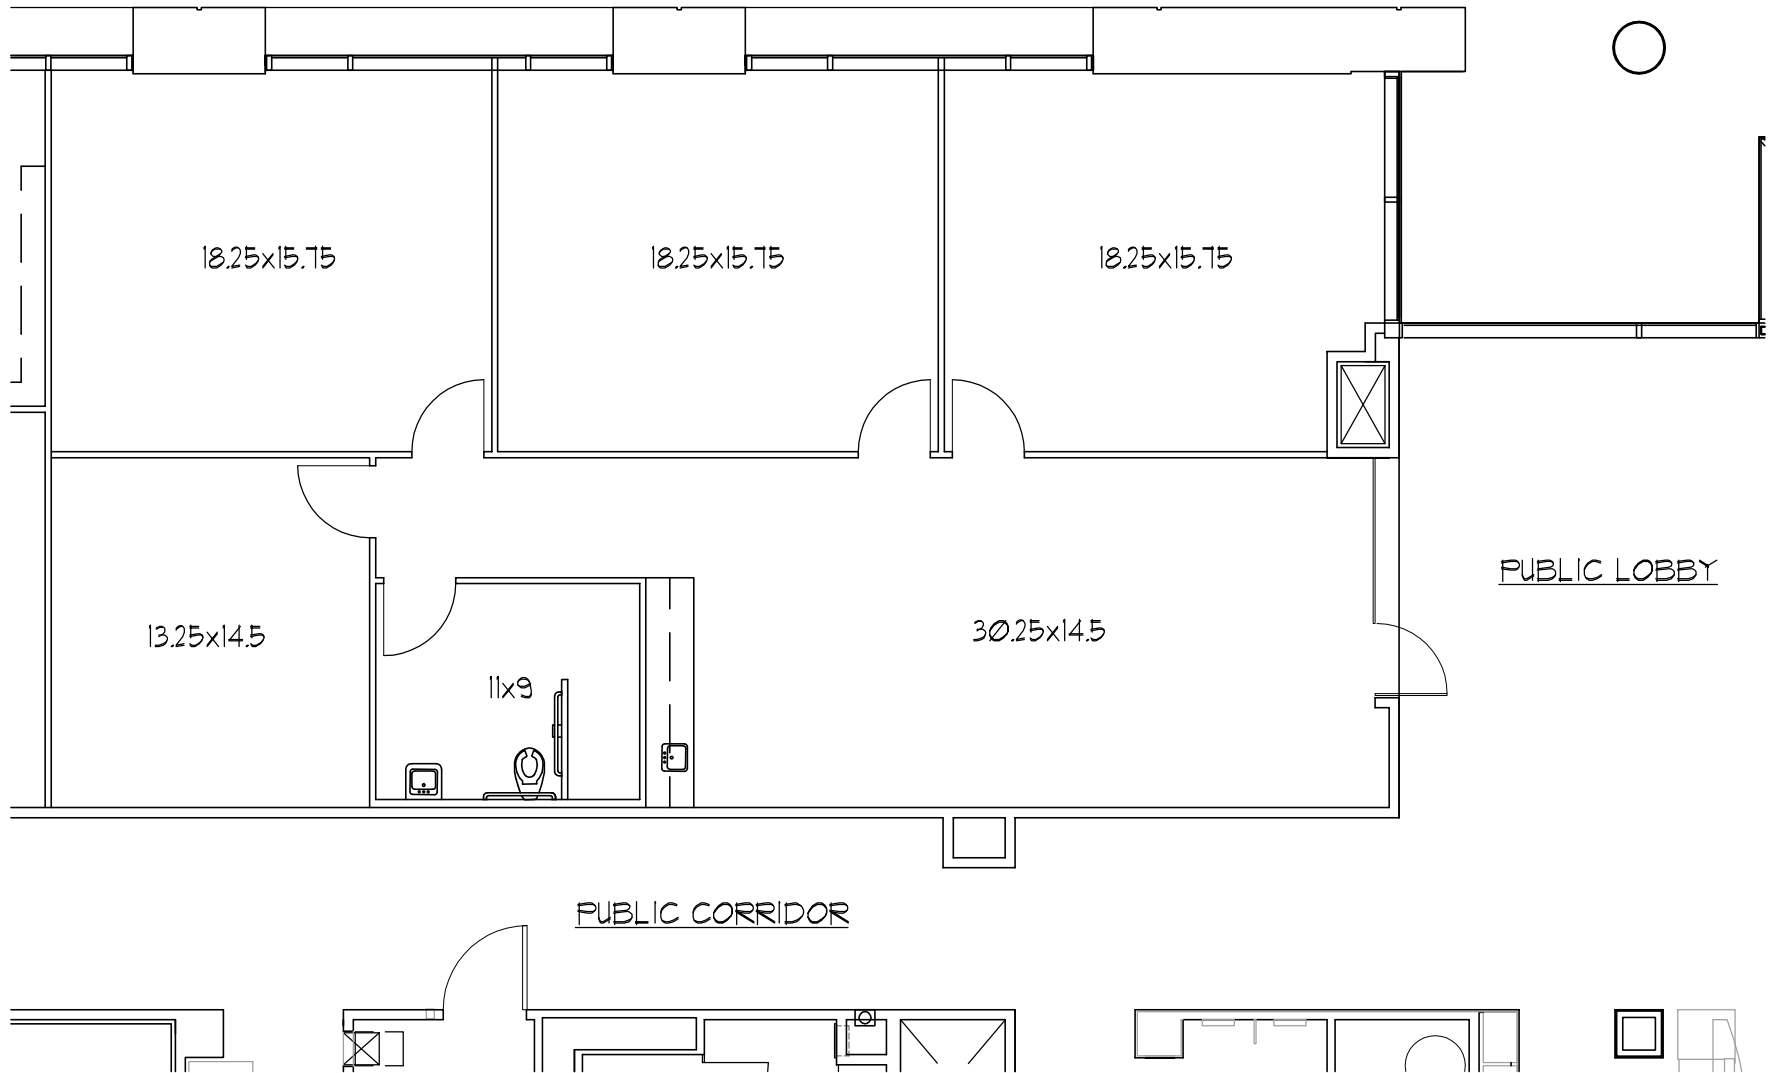

AS-BUILT PLAN
OAKLAND COMMONS II - SUITE 180
20750 CIVIC CENTER DRIVE
SOUTHFIELD, MICHIGAN 48076

DATE: 6-12-12

SCALE: 1" = 20'-0"

1,971 RENTABLE SQ. FT.


Farbman
Group
 FULL SERVICE REAL ESTATE SOLUTIONS


Farbman
 COMMERCIAL REAL ESTATE SERVICES, WORLDWIDE

CONTACT: LESLEY GUTMAN
 (248) 351-4383 LGUTMAN@FARBMAN.COM