


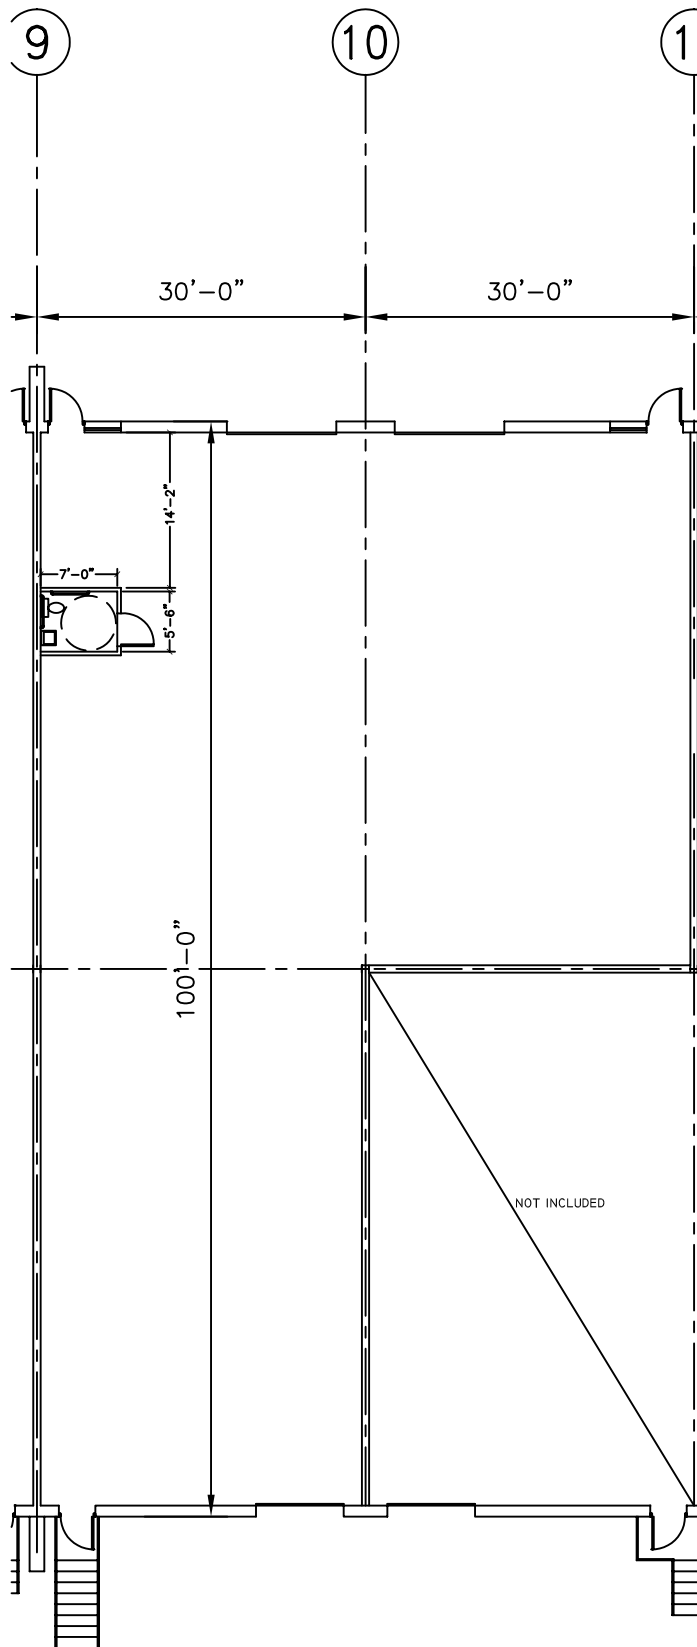

AS-BUILT

CROSSROADS COMMERCE CTR
 2107 EMMORTON ROAD
 SUITES 109, 110, 127
 EDGEWOOD, MD
 4,500 RENTABLE SQ.FT.

SCALE: N.T.S.
 DATE: 3/14/05
 REVISED:



Hill Management Services, Inc.
 9640 Deereco Road
 Timonium, Maryland 21093
 (410) 666-1000
 www.hillmgt.com