



SUITE 150  
AS BUILT - 1 OF 1  
THE ADDISON BUILDING  
VERIFY RSF  
SCALE: 3/32" = 1'-0"  
DATE: DECEMBER 21, 2020

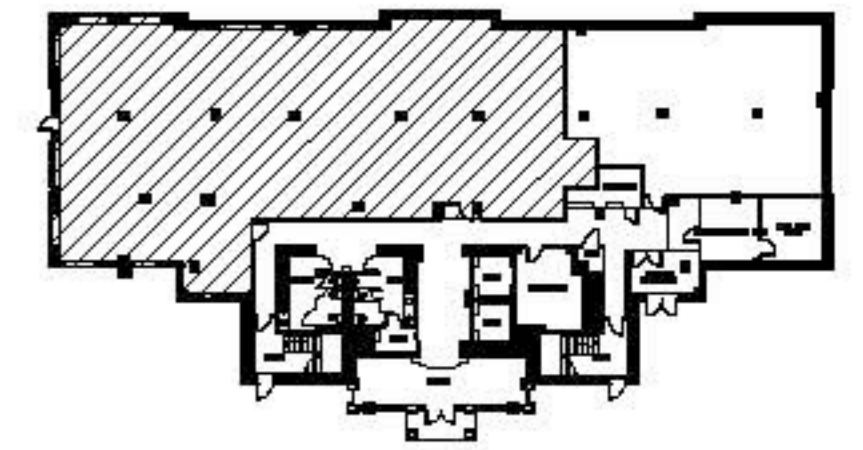

KEY PLAN

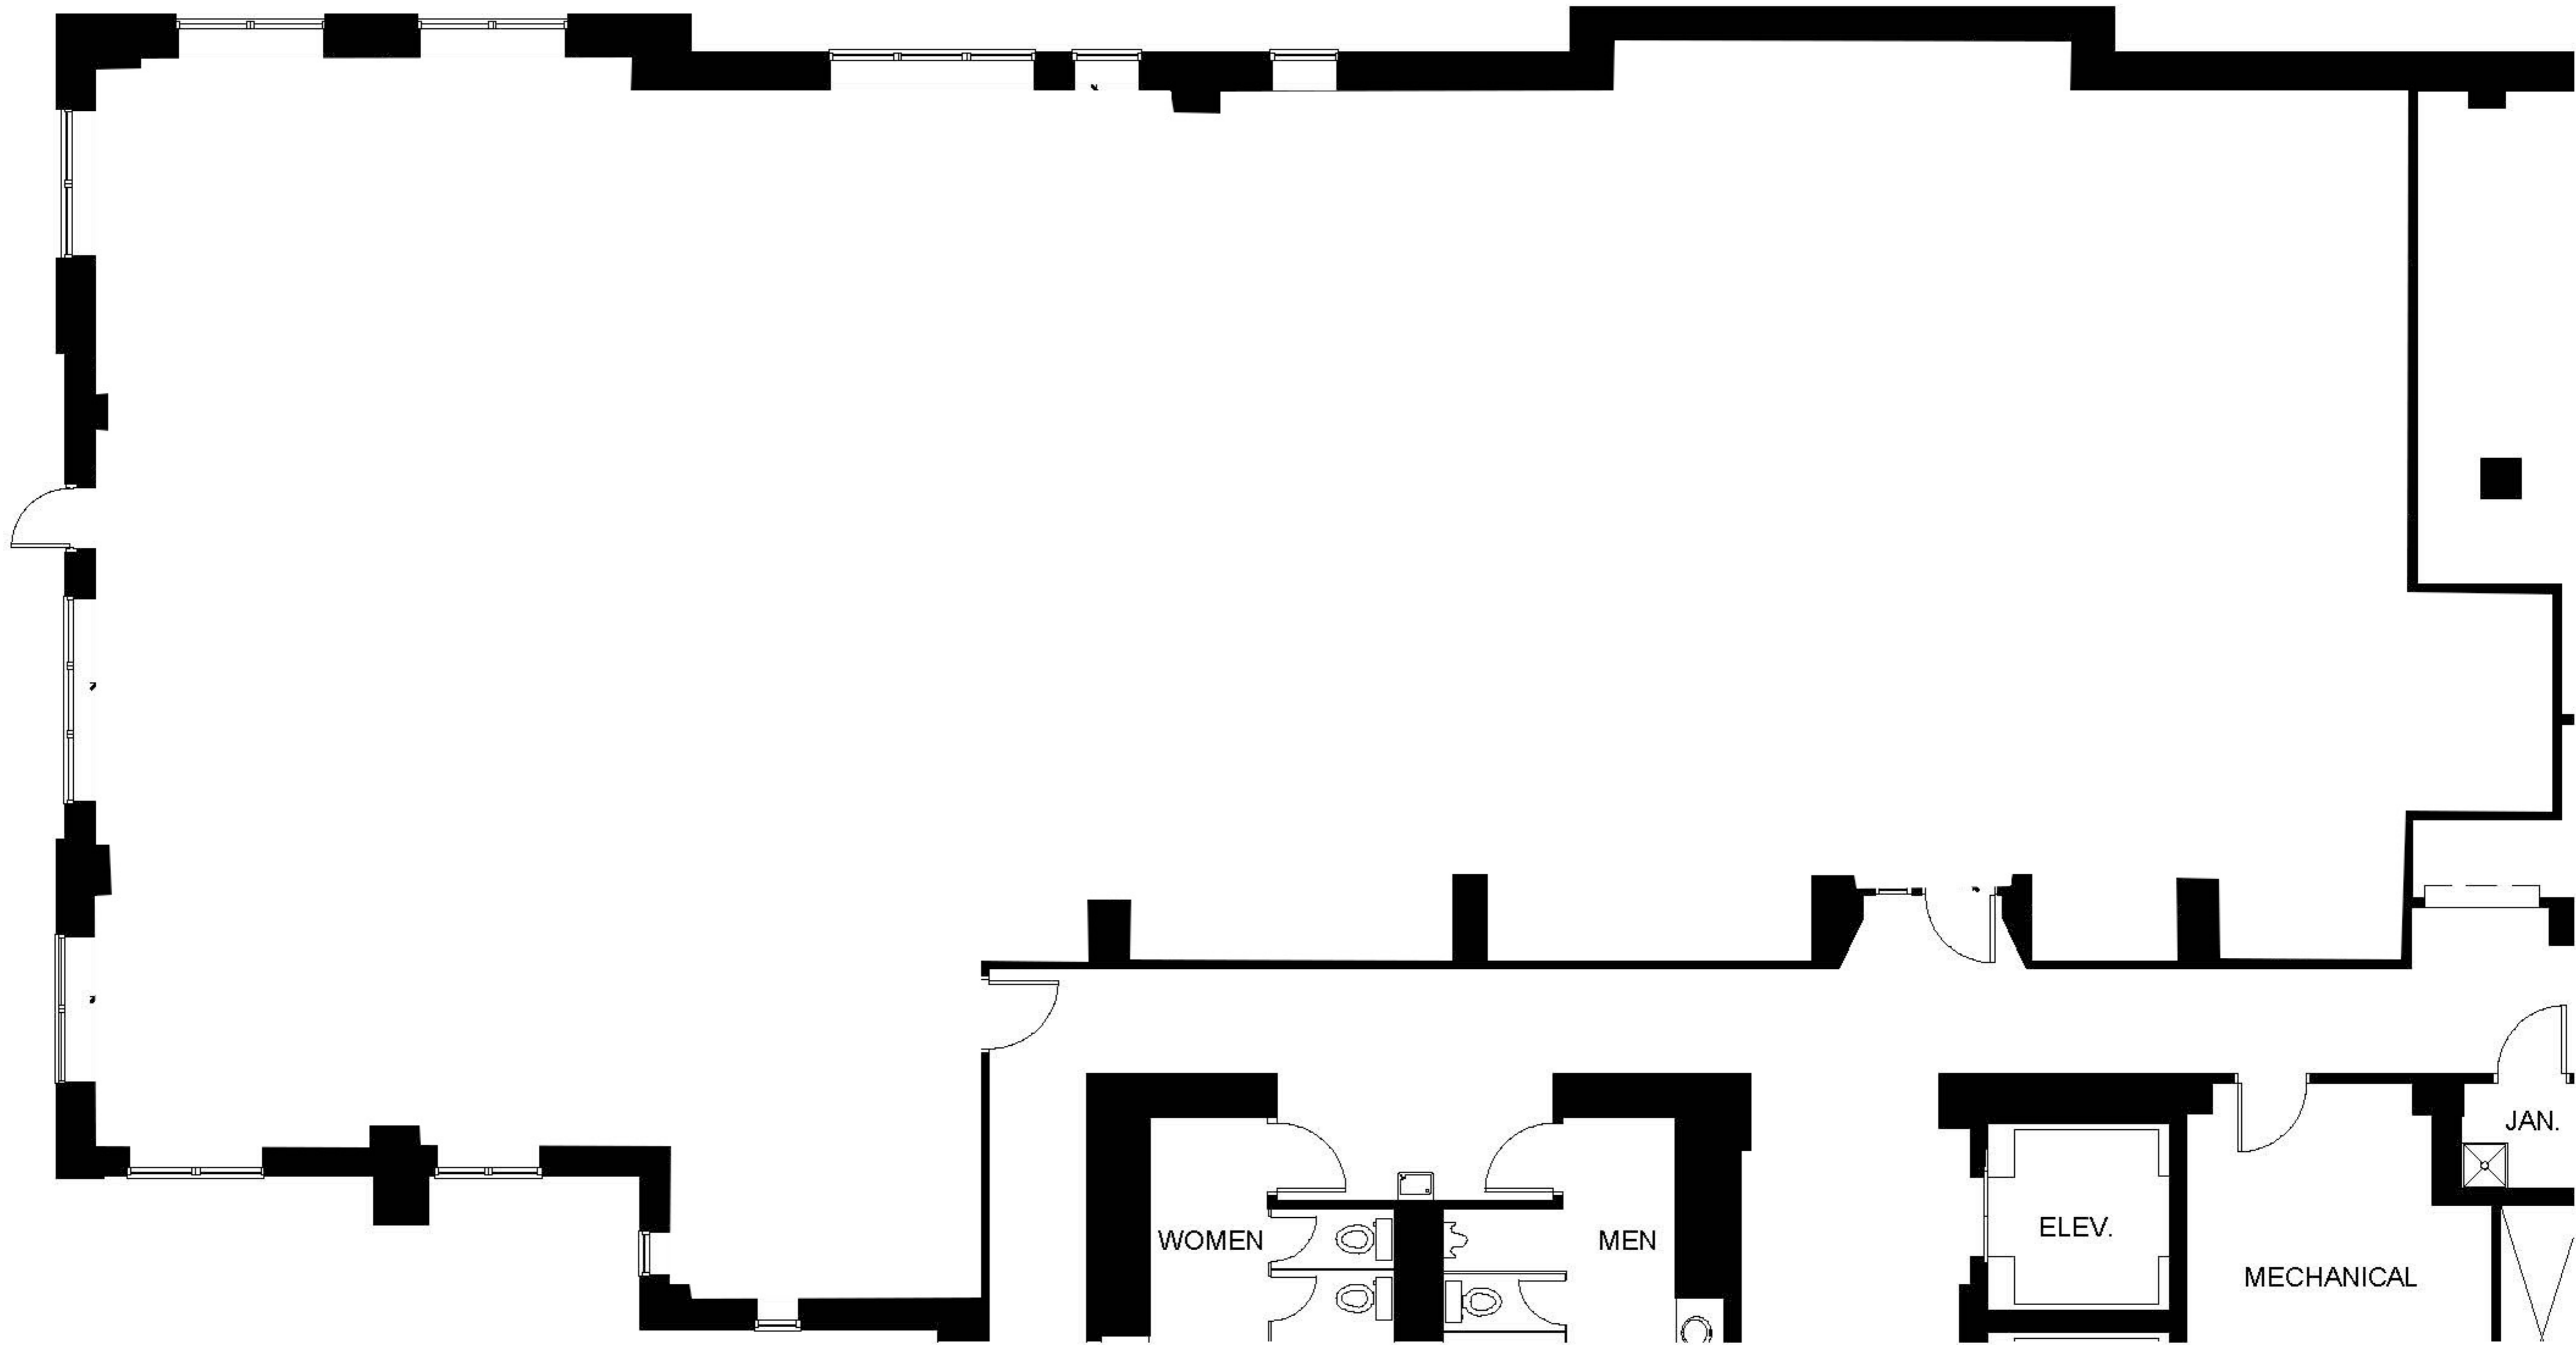

**SMITH  
HARRIS**  
**DESIGN**  
associates